



4191

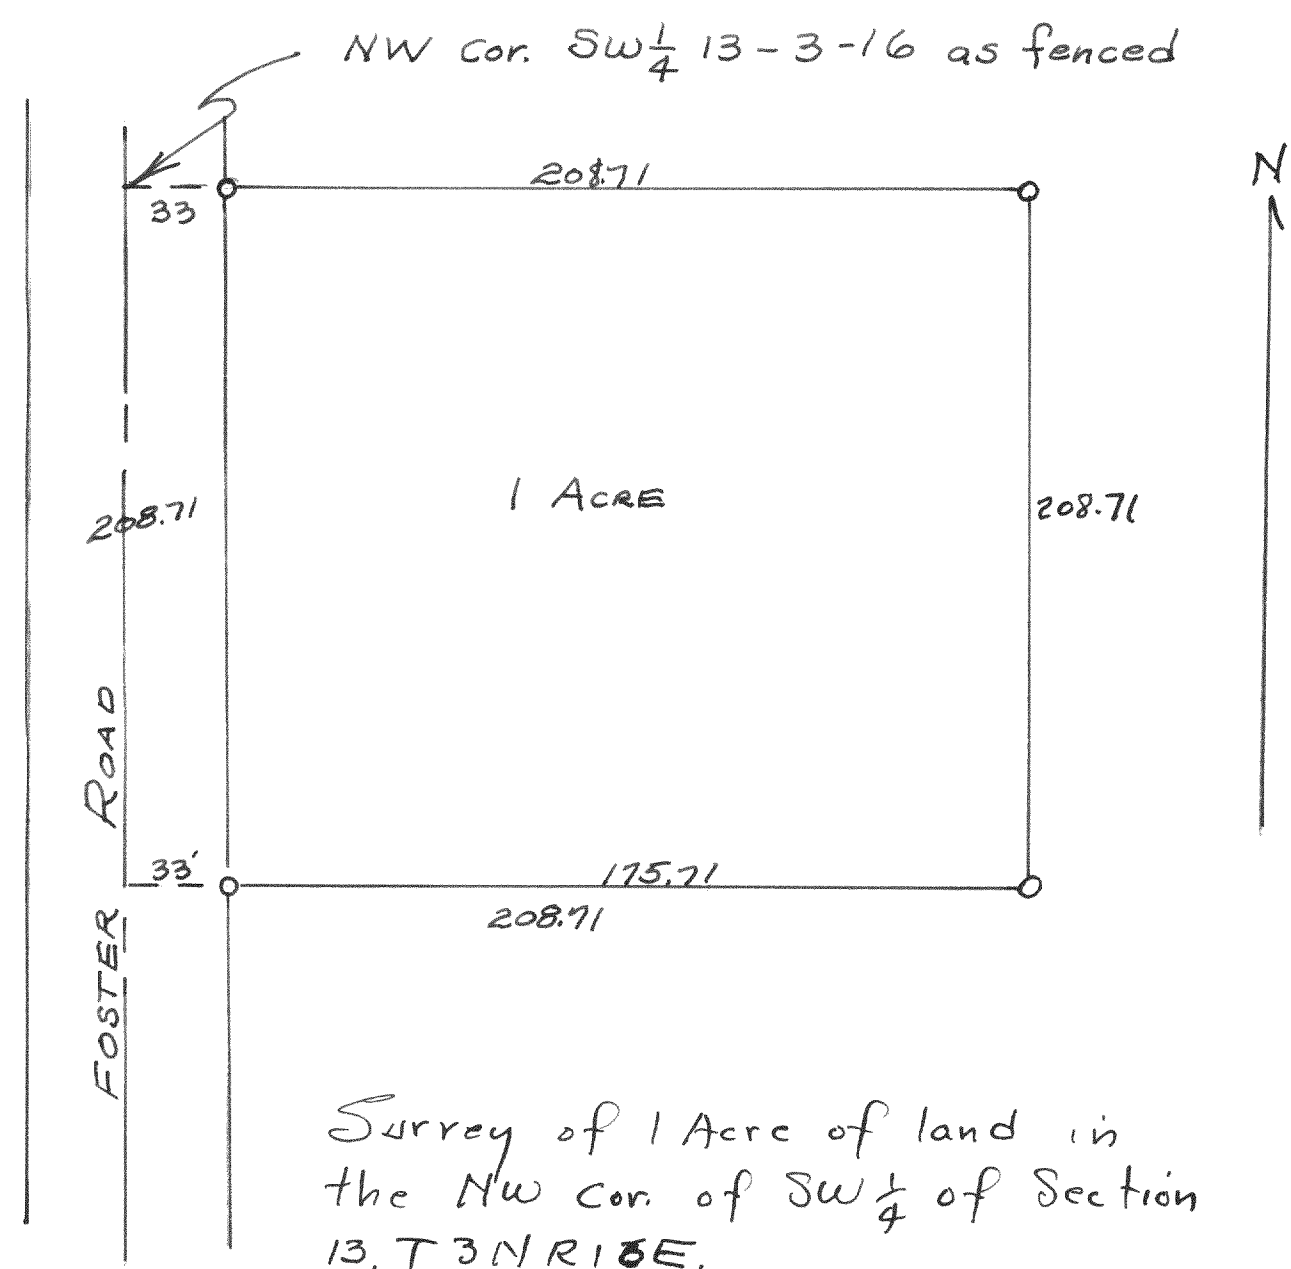

Survey of 1 Acre of land in
the NW cor. of SW $\frac{1}{4}$ of Section
13, T3N R18E.

May 1963 Lloyd L. Jensen
Surveyor

4192

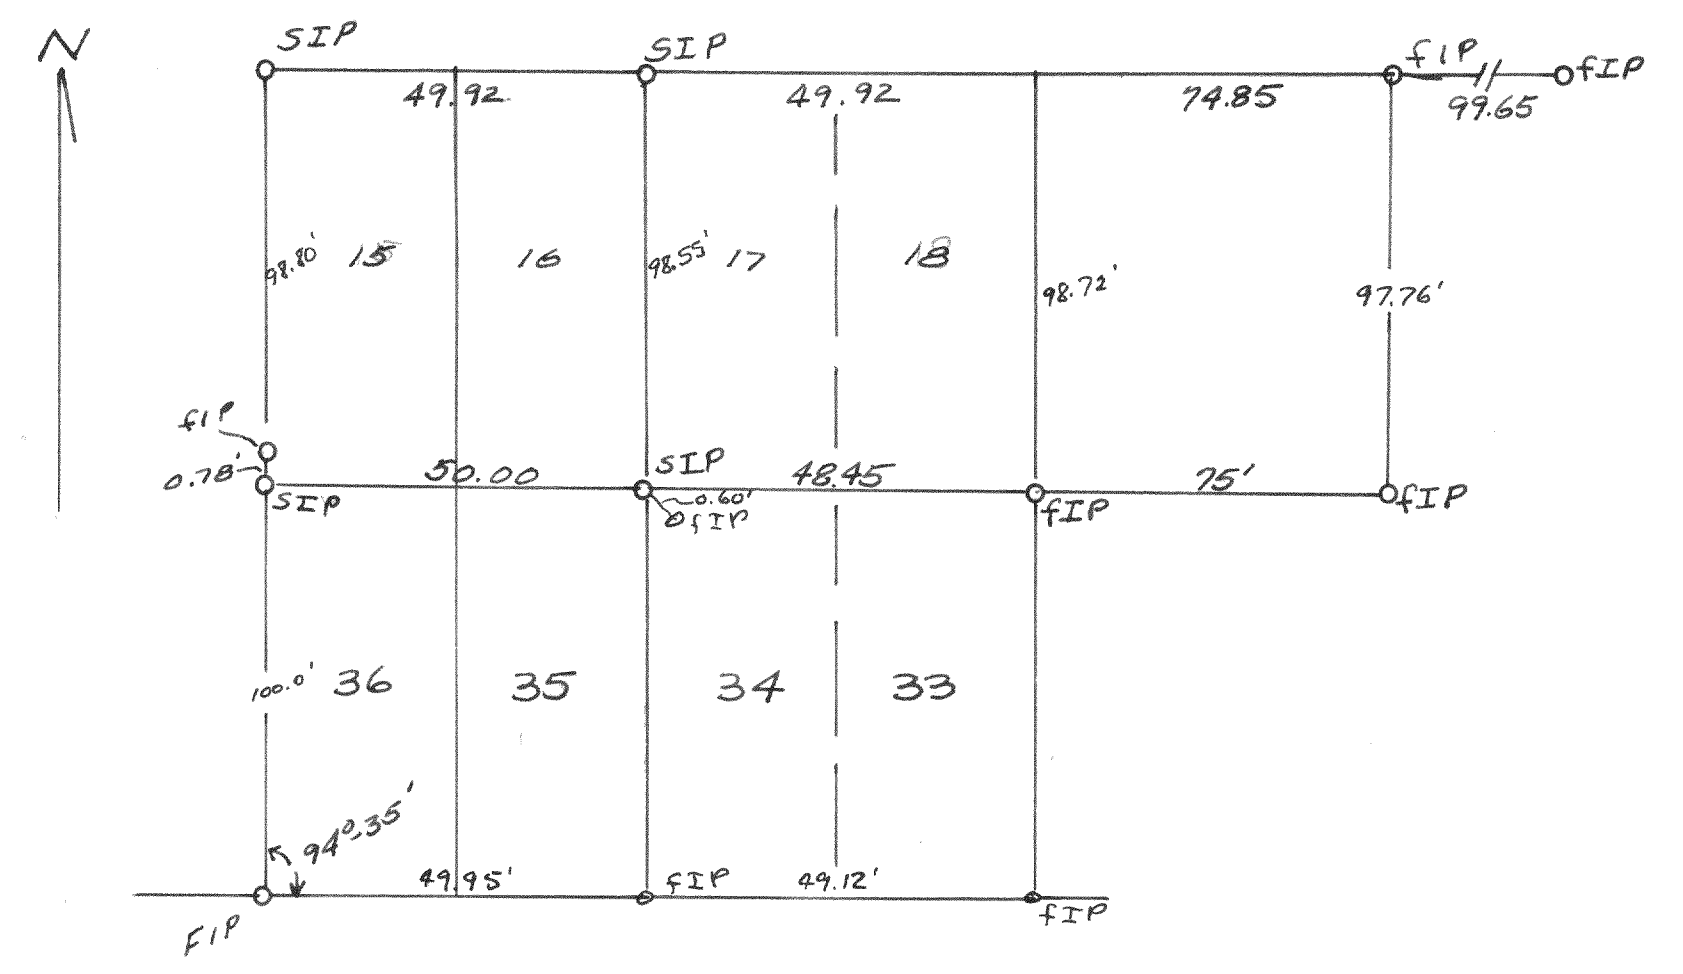

Survey of Lots 15, 16, 17, 18,
33, 34, 35, and 36 of Block 107
of Lake Wandawega Subd.

July 5, 1963 Lloyd L. Jensen
Surveyor