



Plat of Survey of Land in SE 1/4 Sec. 19  
TANRIBE Village of East Troy Block 3  
August 1953  
LLJ  
CS

# 2790

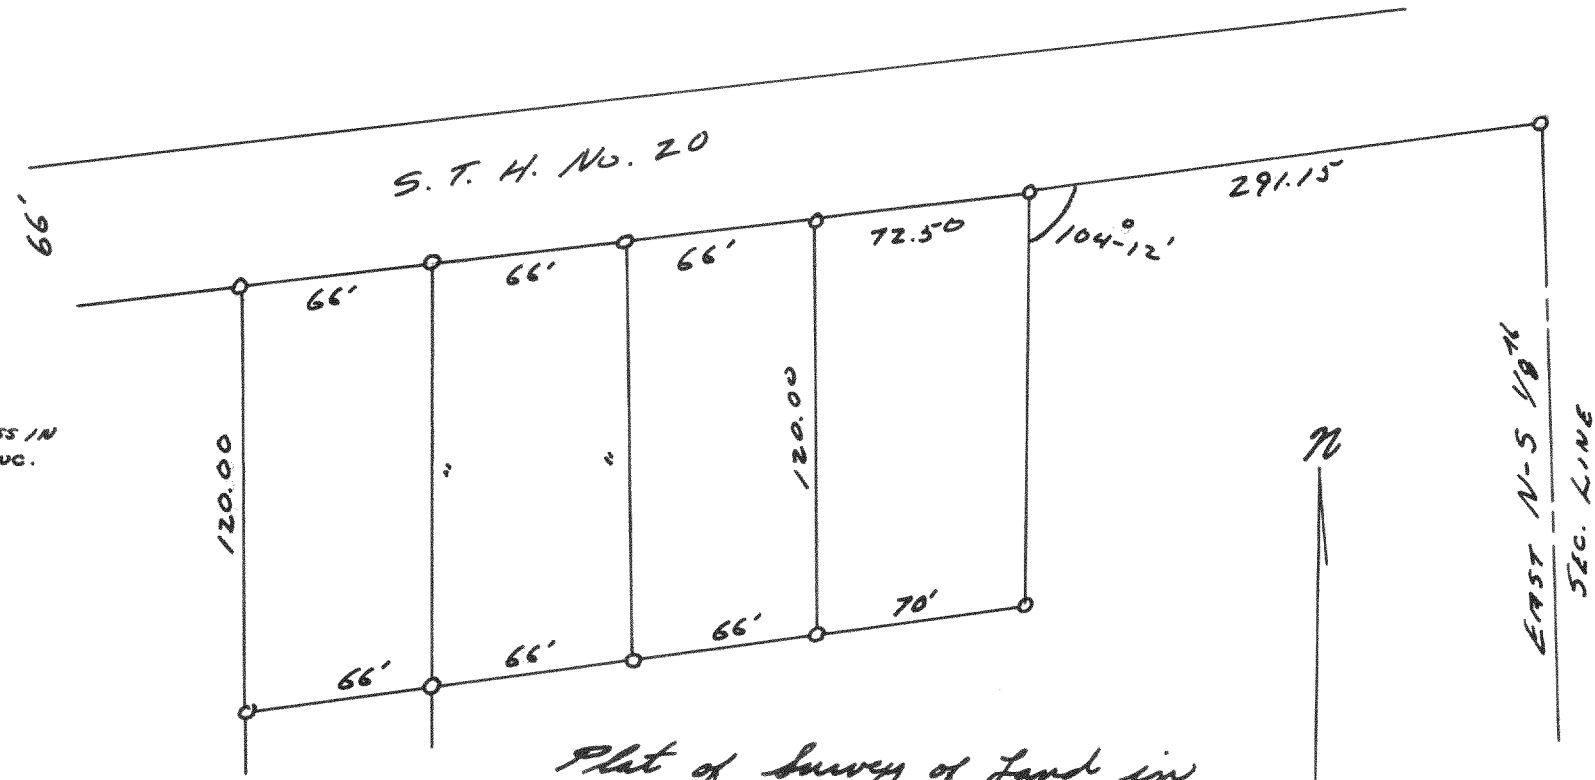


Plat of Survey of Land in  
SE 1/4 Sec. 19 TANRIBE  
Village of East Troy  
May 1953  
LLJ  
CS

# 2791

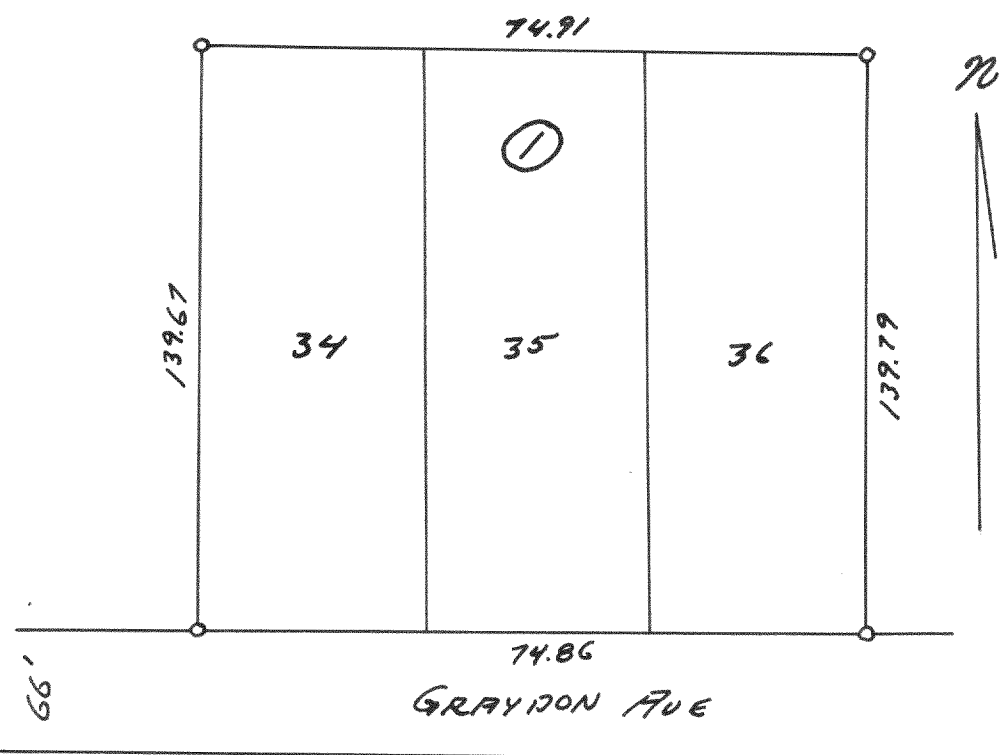


Plat of Survey of Lots 34-36 Block 1  
Clarkson Add. Village of East Troy  
Aug. 1953  
LLJ  
CS

# 2792

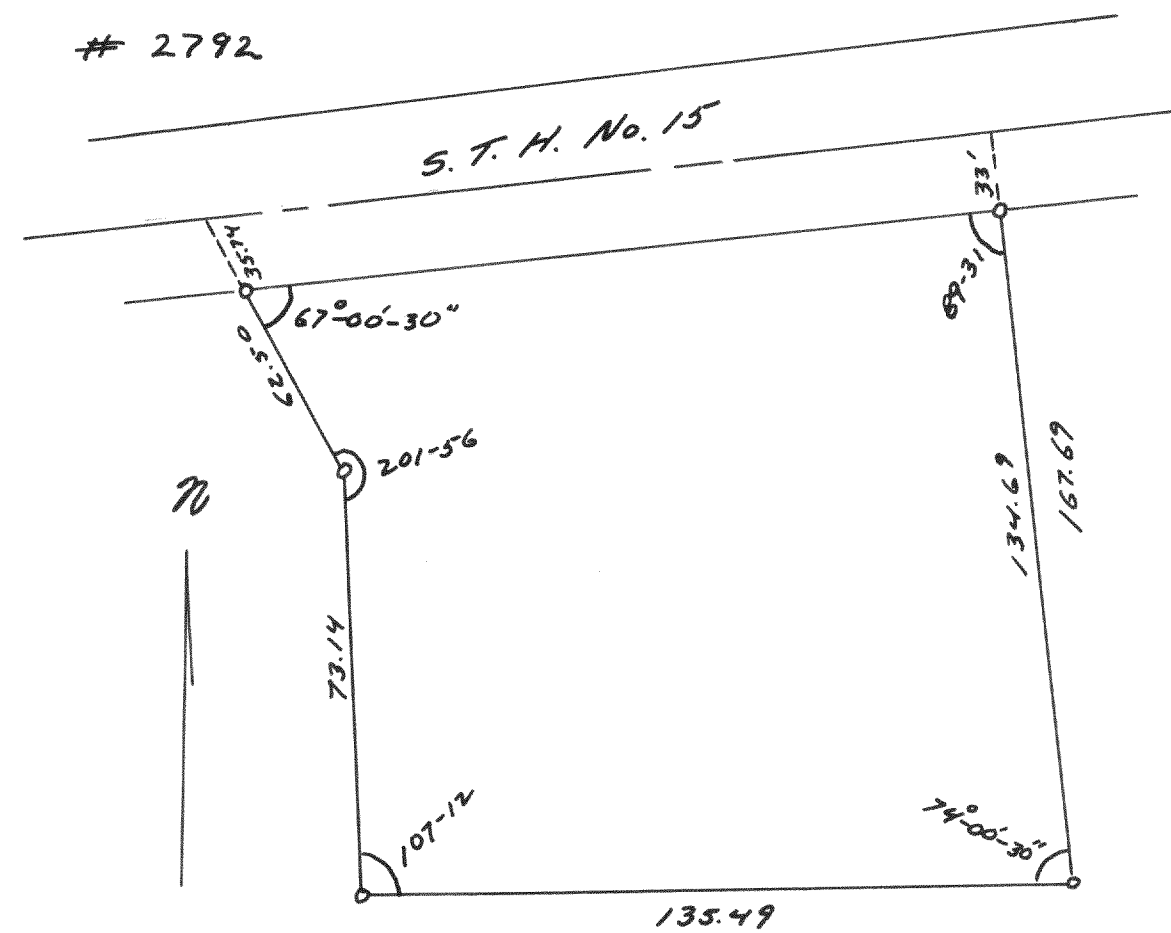

Plat of Survey of Land in SW 1/4 Sec. 20  
TANRIBE Village of East Troy  
March 1953  
LLJ  
CS

# 2793

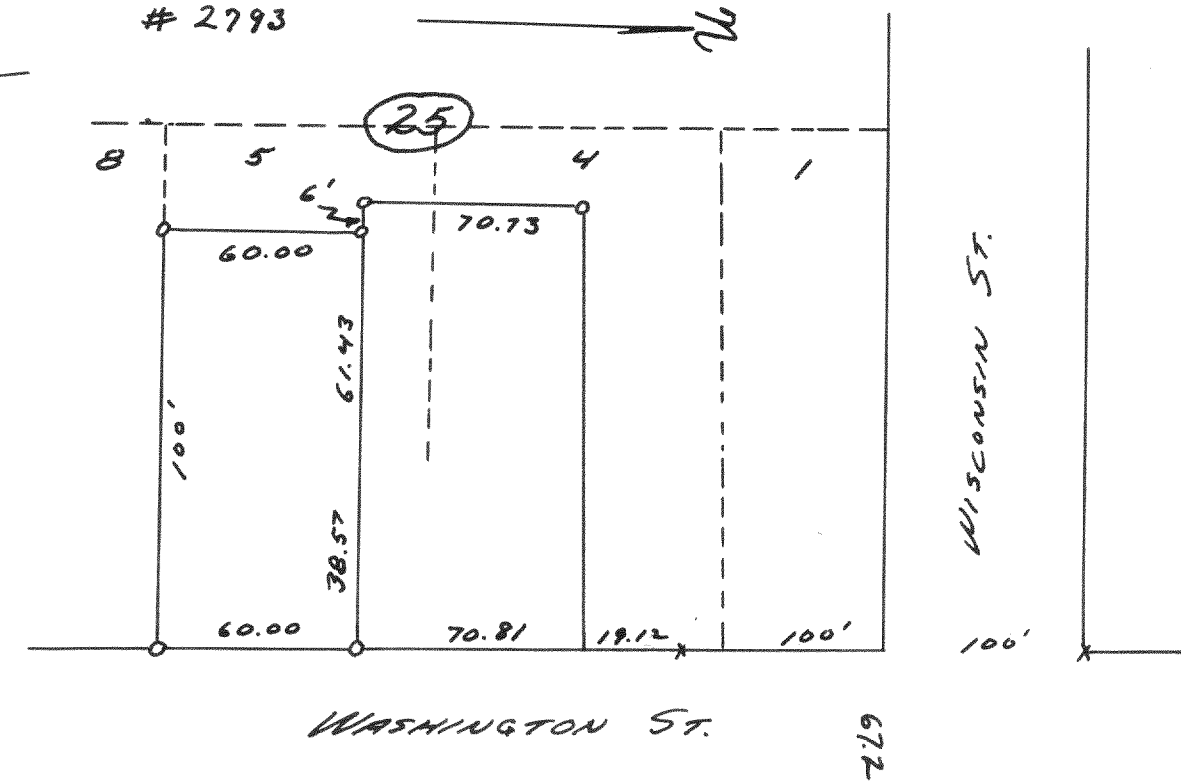

Plat of Survey of Lots  
4 & 5 Block 25 City of  
Oldham April 1953  
LLJ  
CS