



#4195

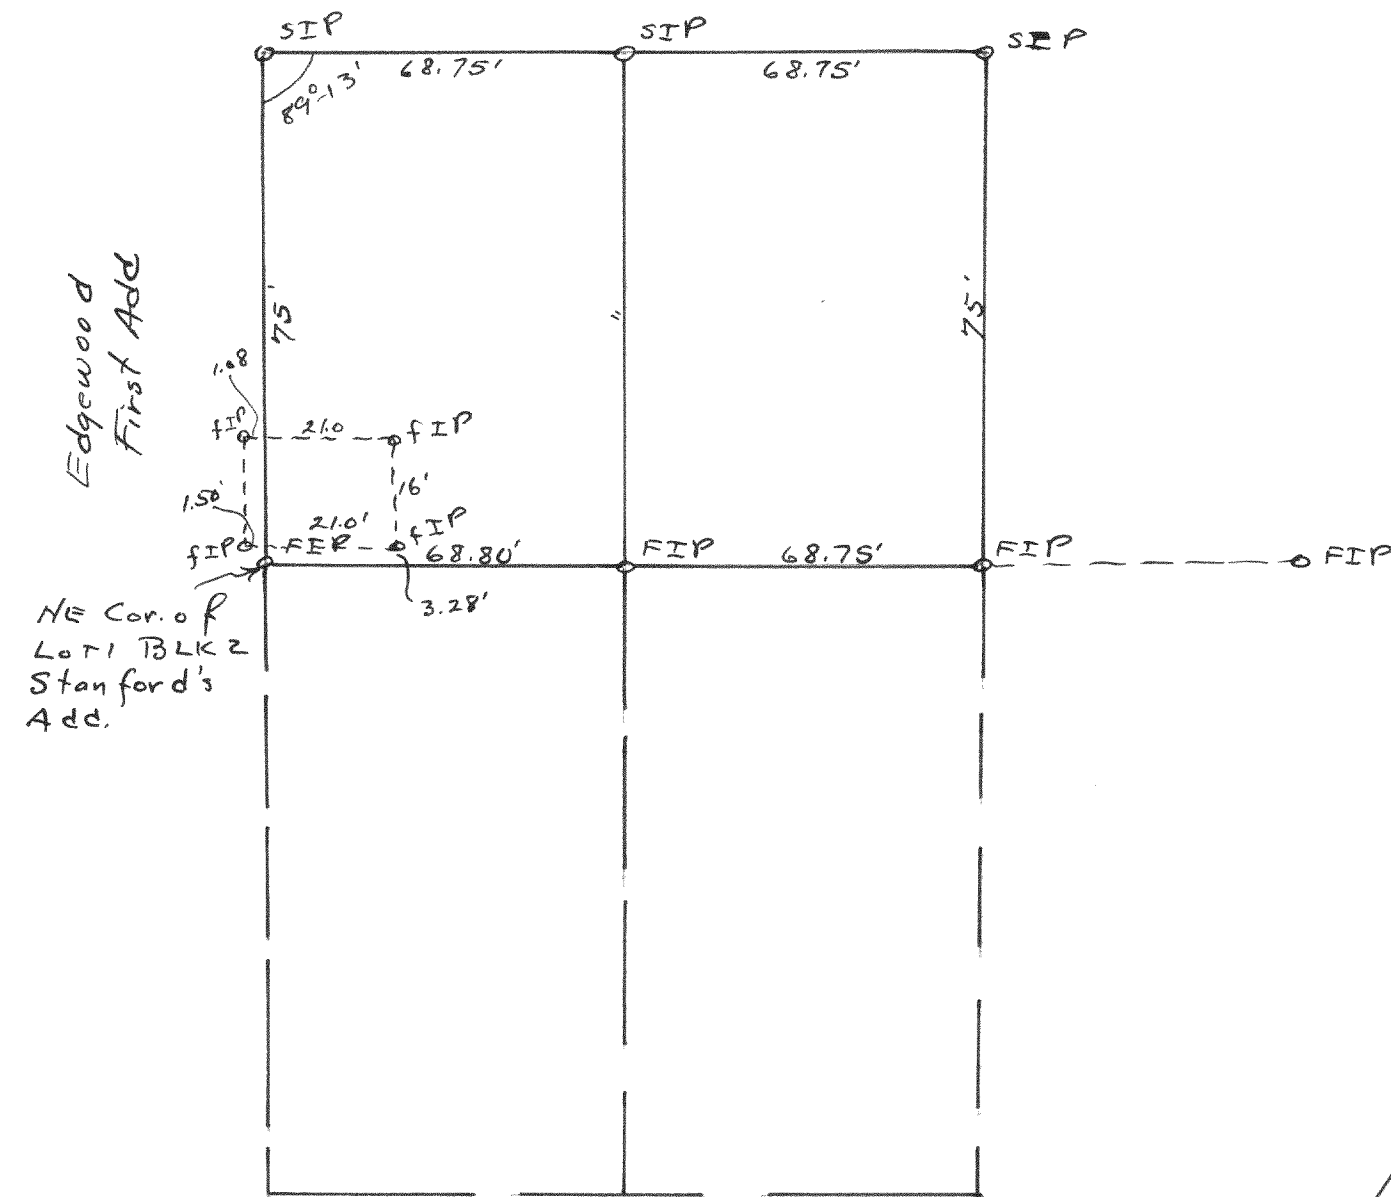

2nd Street

Survey of land located in the
Northeast $\frac{1}{4}$ of Section 36, T3N
R16E, City of Elkhorn
Nov. 1962 Lloyd L. Jensen
Surveyor

4196

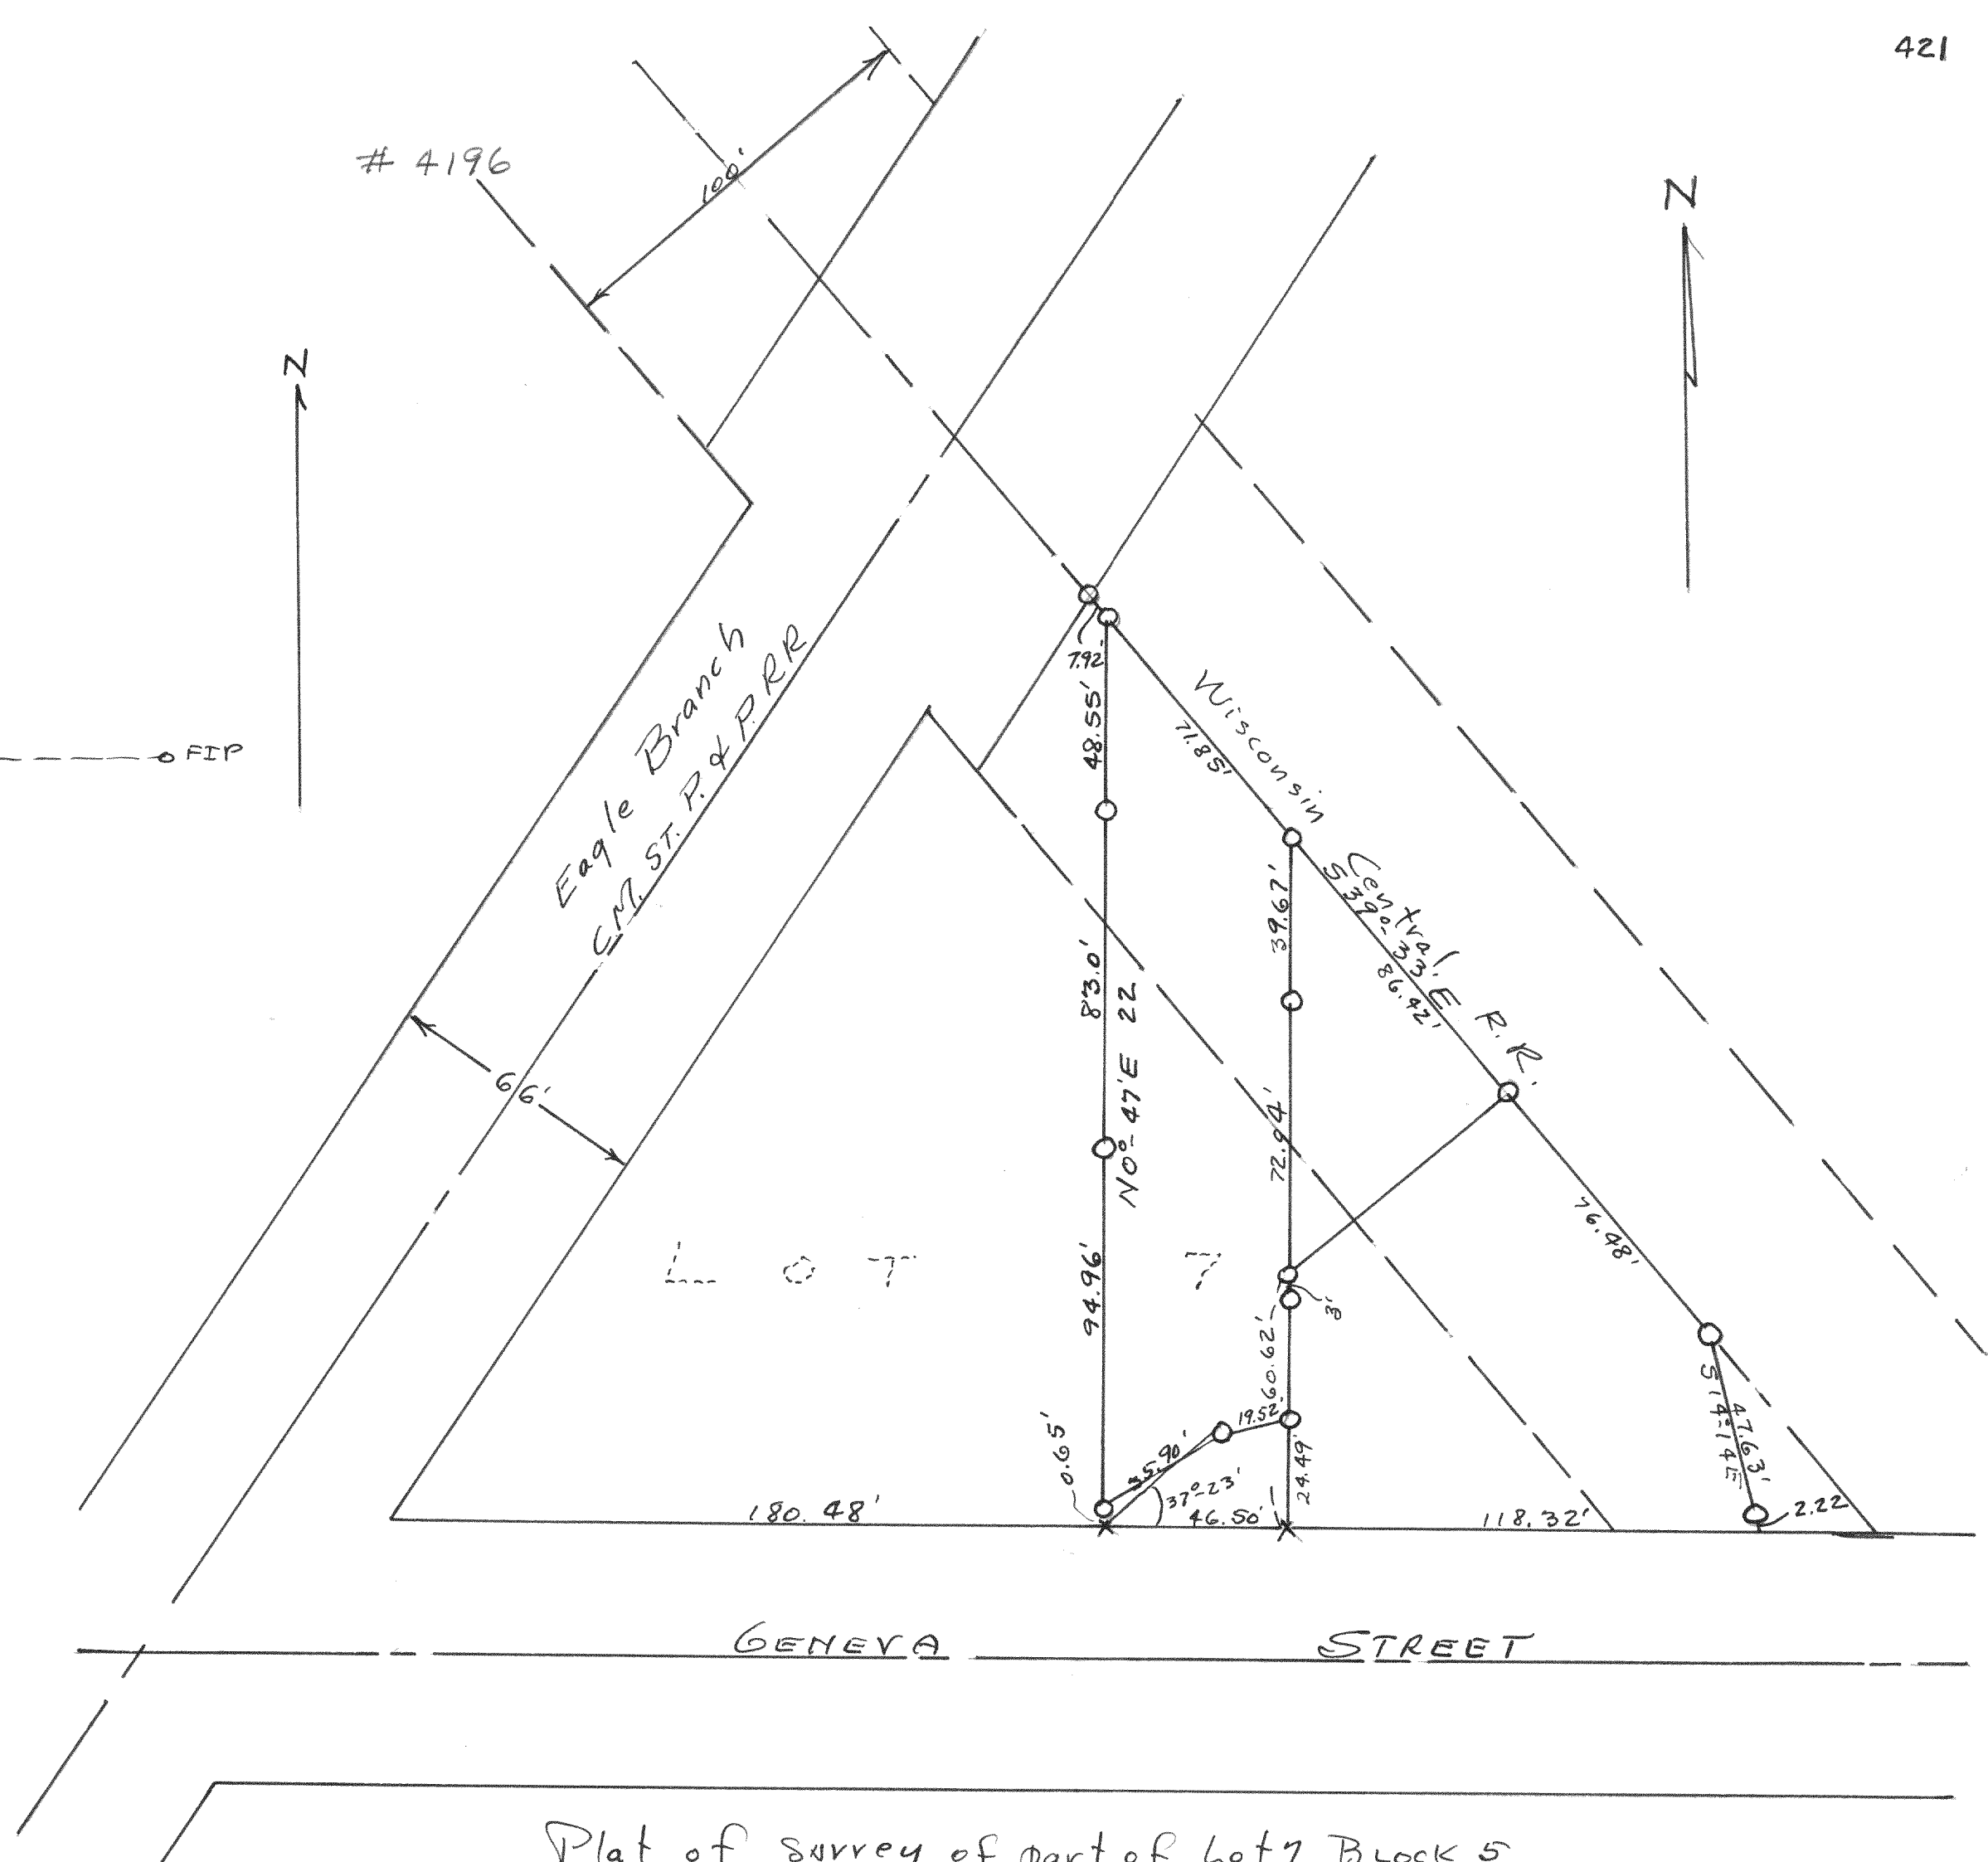

Plat of Survey of part of Lot 7 Block 5
of Arnolds Add. to the City of Elkhorn and
Railroad Right of way.
March 1951
Nov. 6, 1962

Lloyd L. Jensen
Surveyor