


#4197

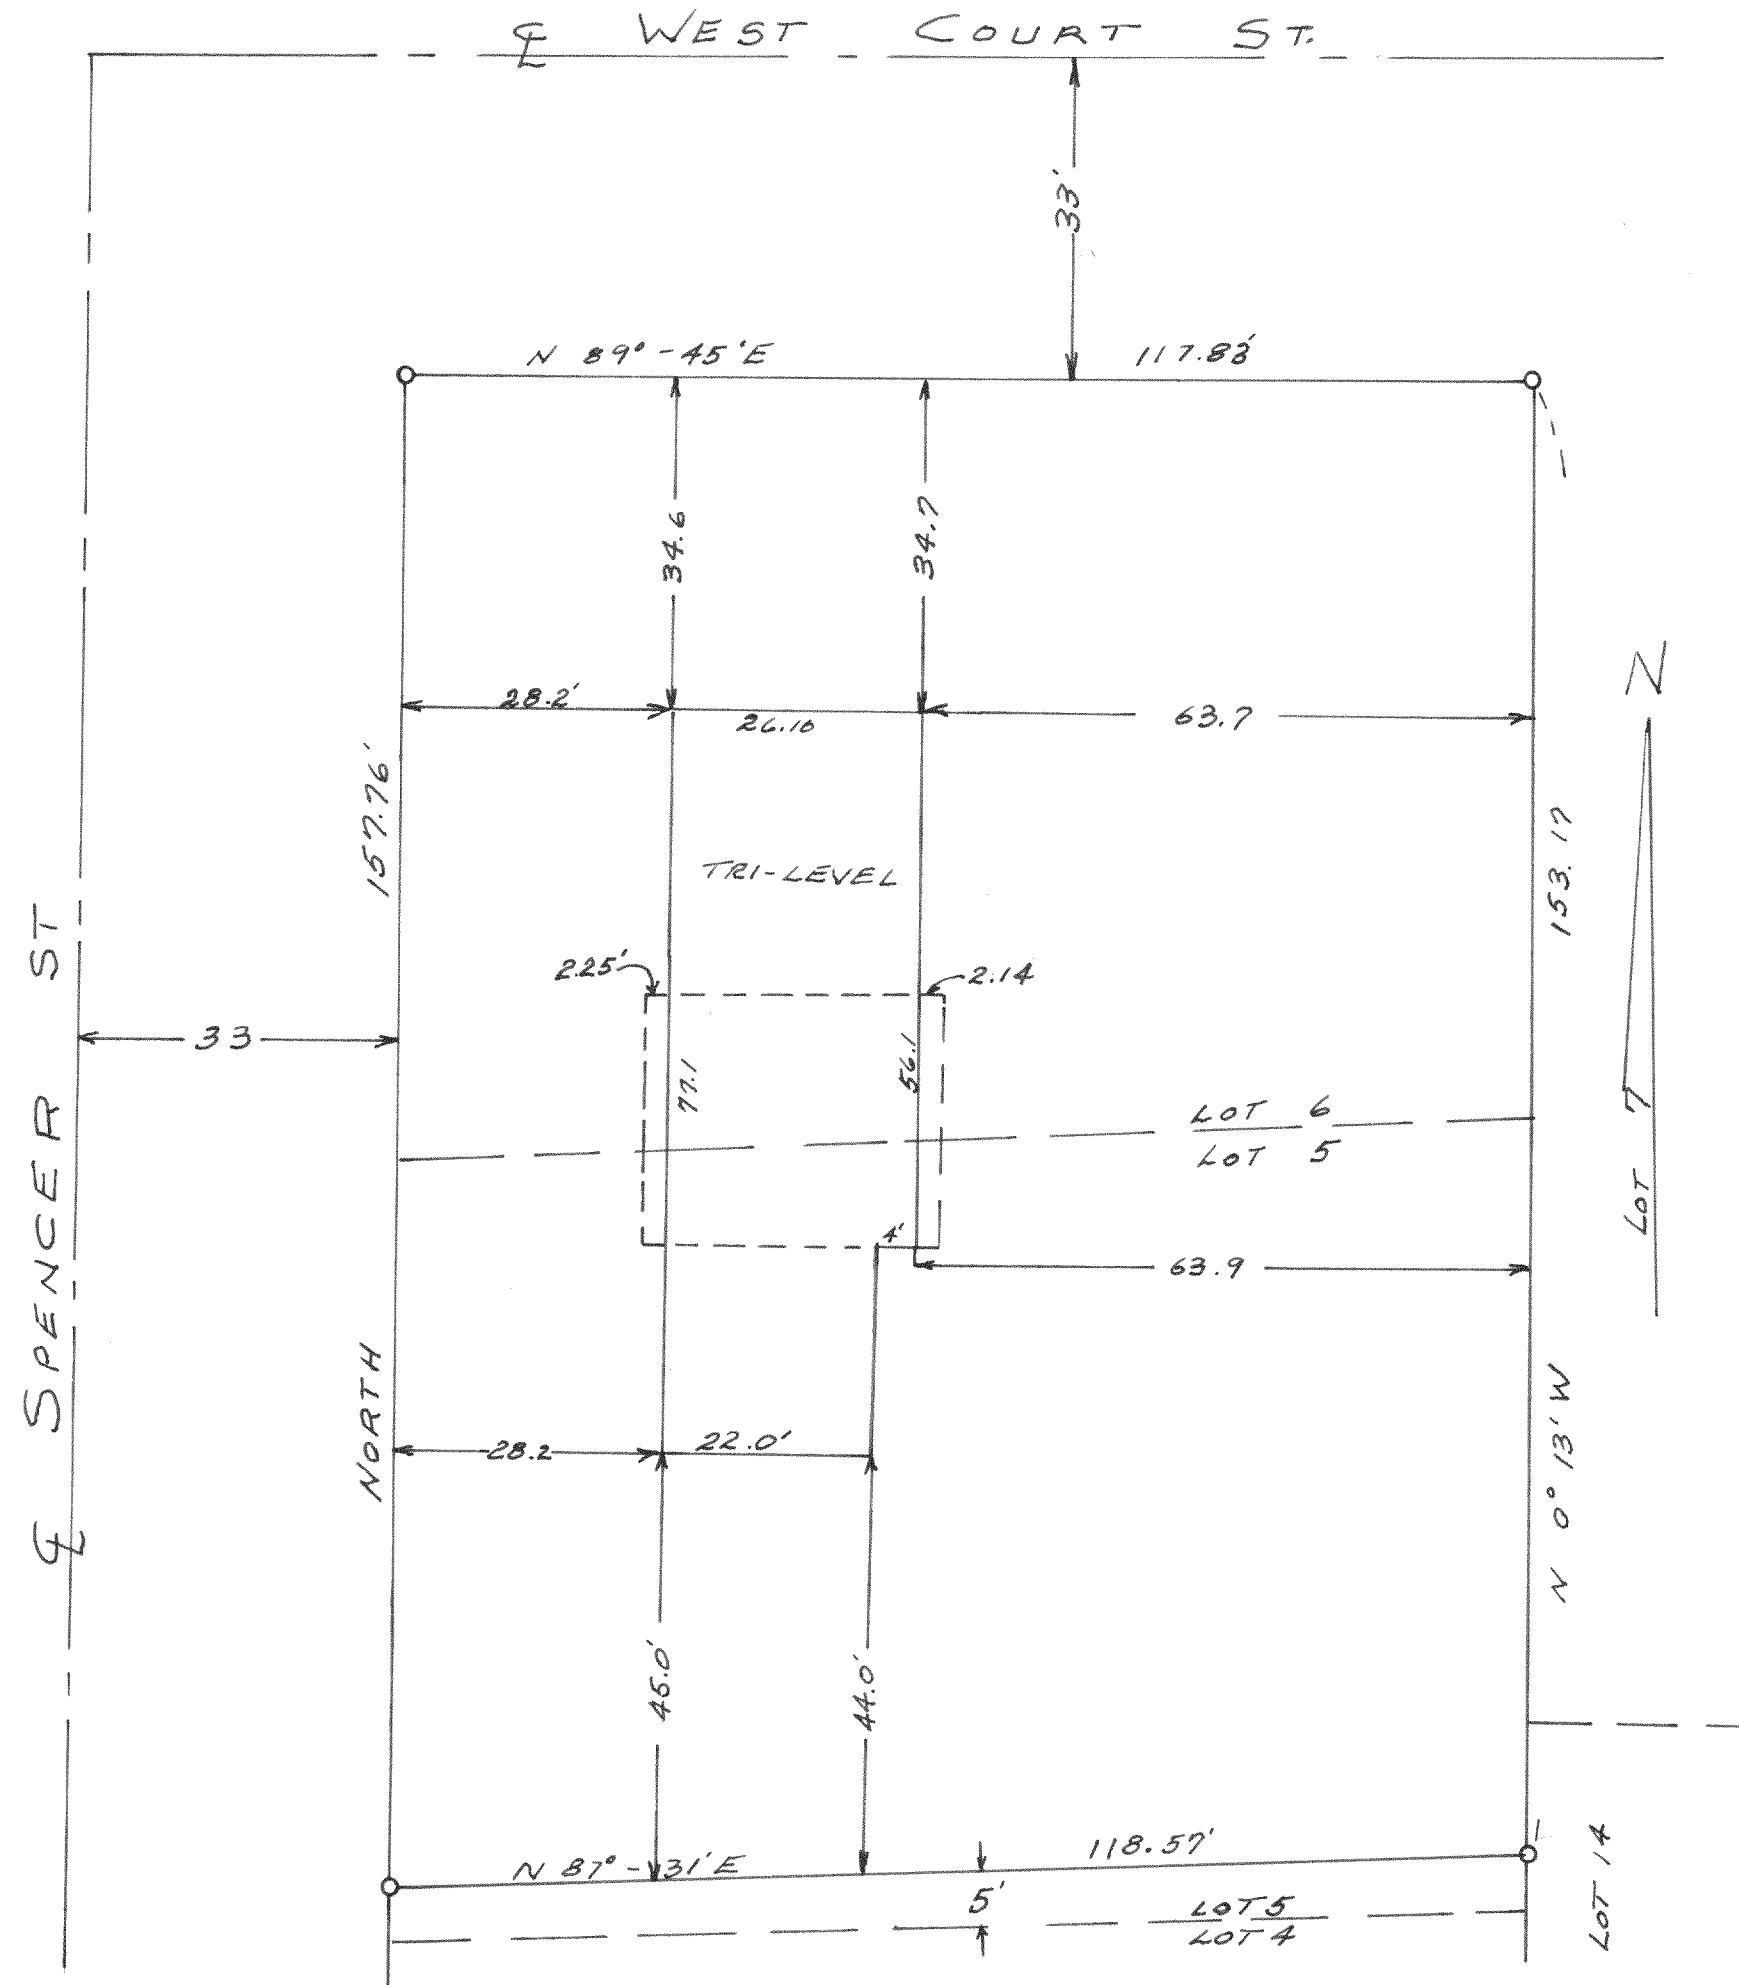

PLAT OF SURVEY OF

LOT 6 AND 5 (EXCEPT THE
50.5') OAKLAND SUBD. SEC. 36
T3N, R1E CITY OF ELKHORN
WALWORTH COUNTY
APRIL 1964

Lloyd L. Jensen
CO. SURVEYOR