


#4203

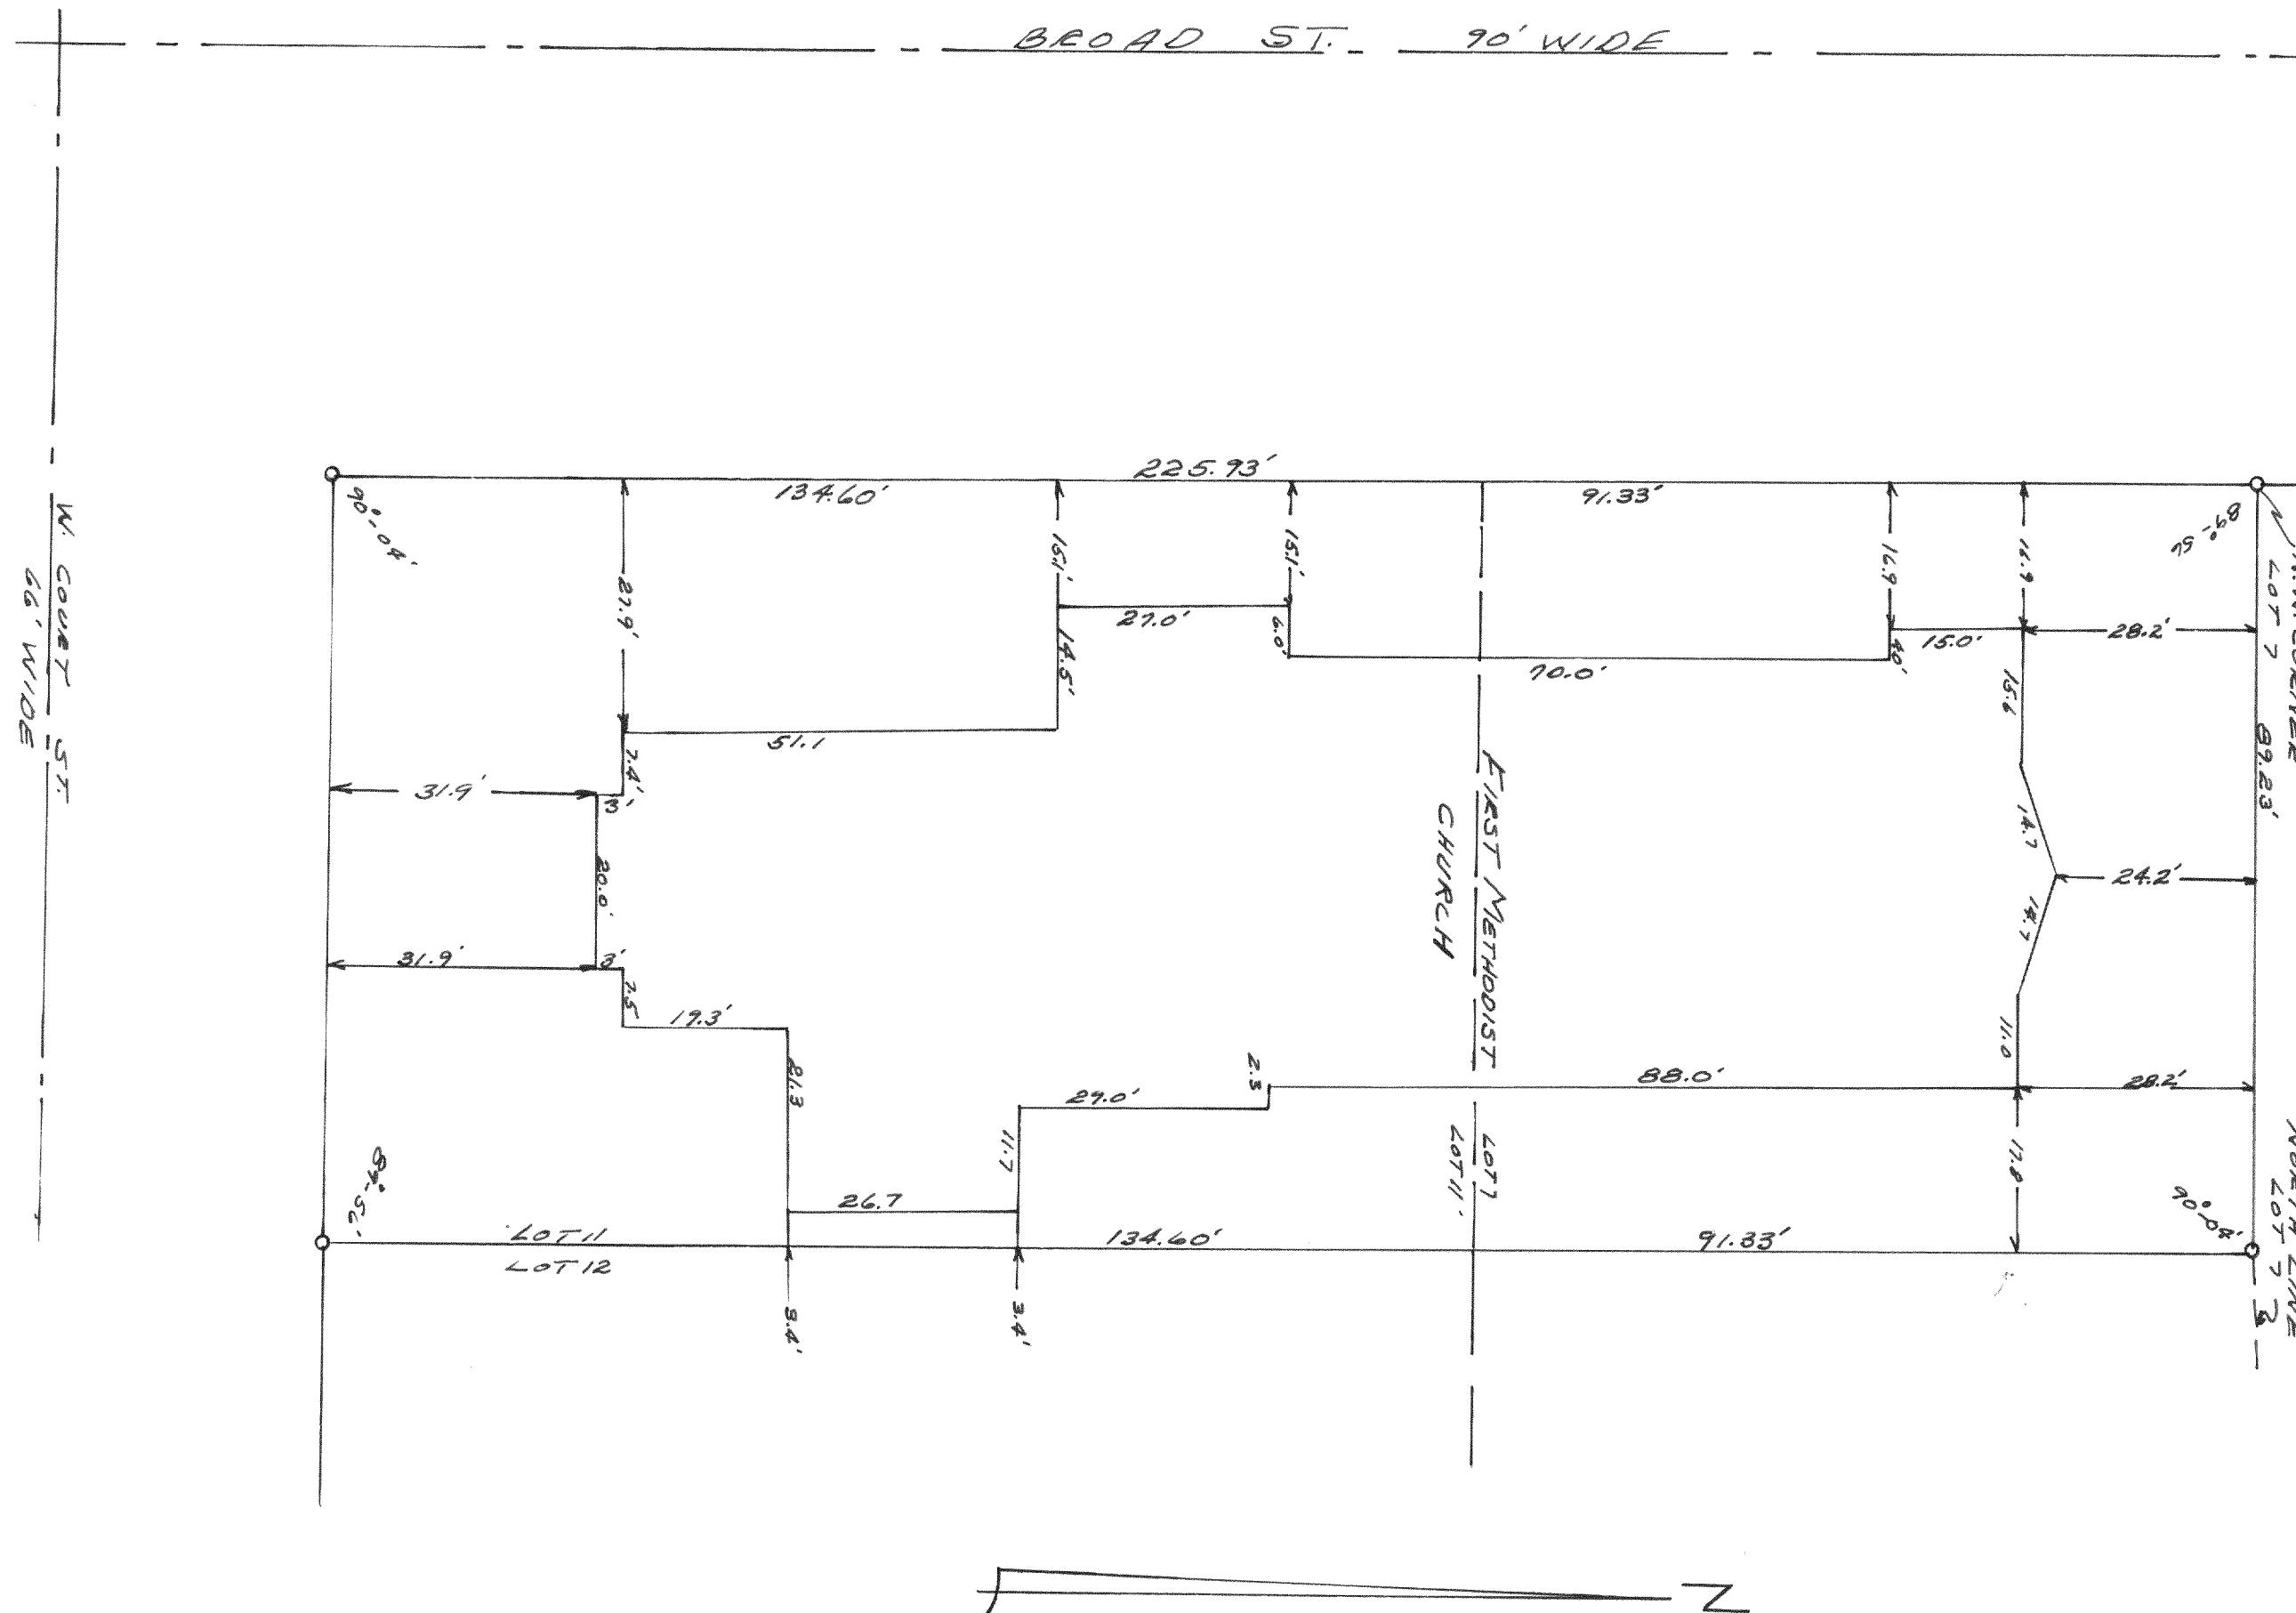

PLAT OF SURVEY OF
LOT 11 AND THE WEST 89.23'
OF LOT 7, BLOCK 16, ORIGINAL
PLAT, CITY OF ELKHORN,
WALWORTH COUNTY, WIS.

Oct. 1964

Lloyd Jensen
CO. SURVEYOR