




2794

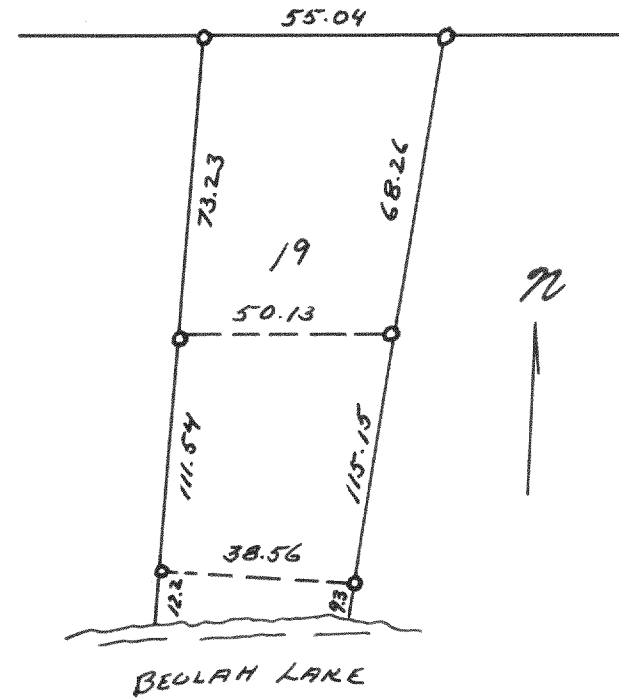


Plat of Survey of Lot 19
French Sub. F4N18C
July 1953 LLJ CS
2797

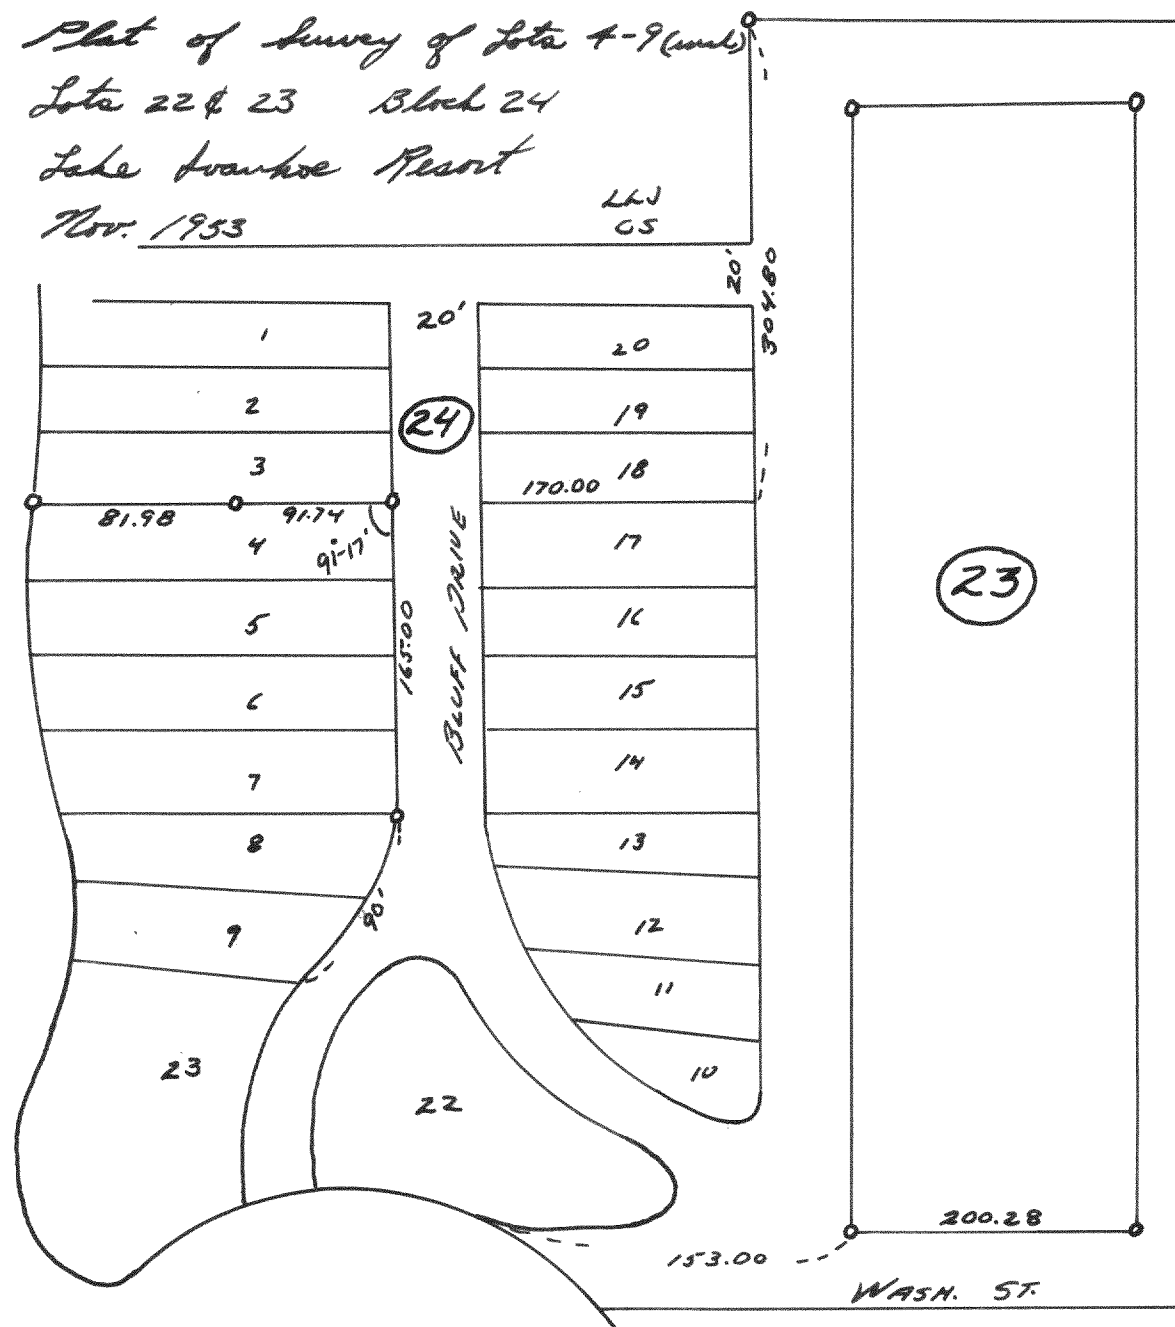

2795

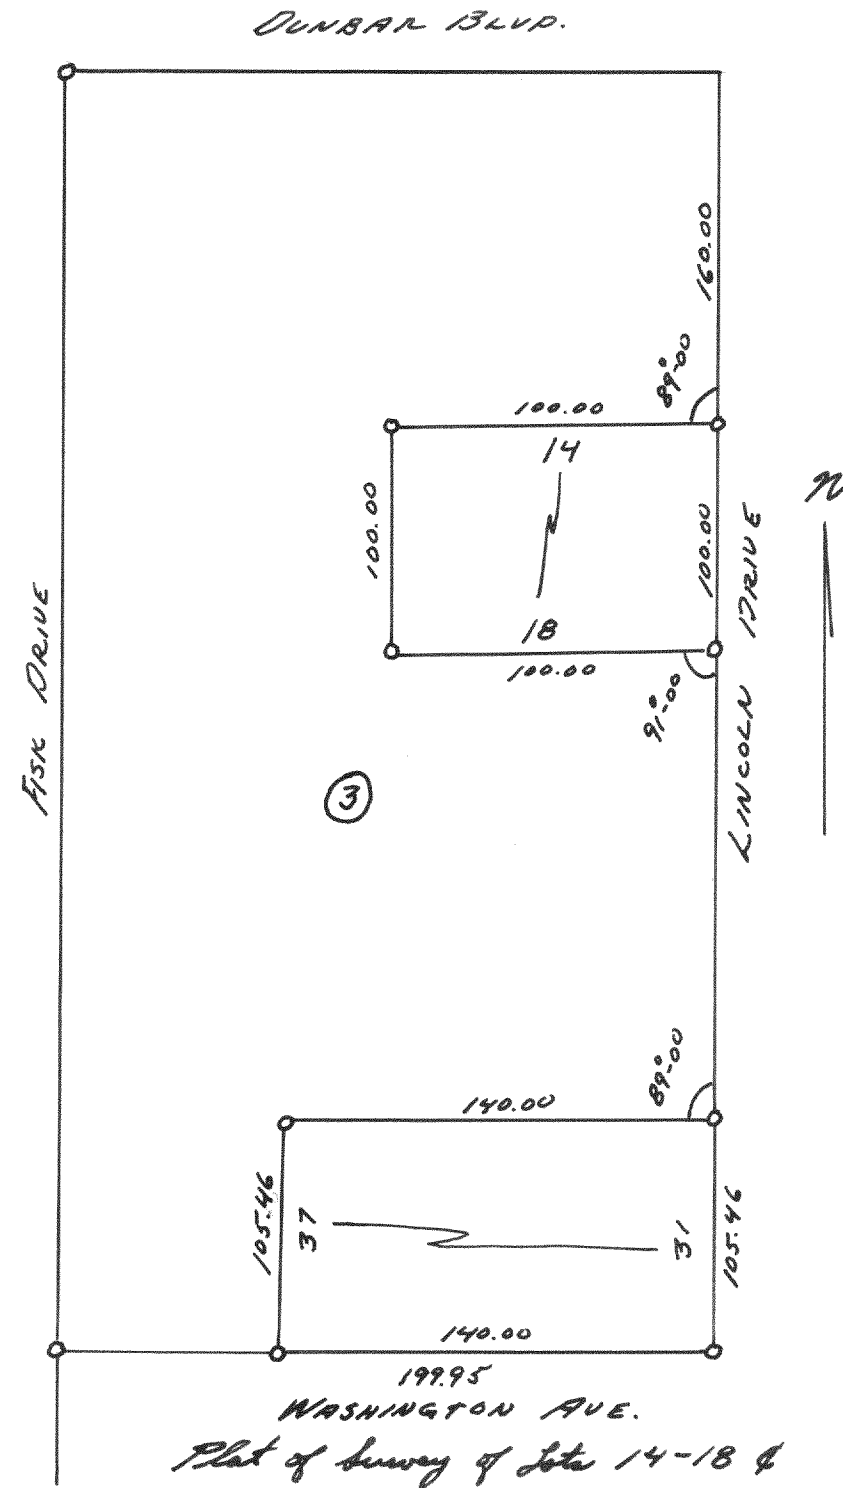


Plat of Survey of Lots 14-18 &
Lots 31-37 Block 3 Lake Ivanhoe
Resort May 1953 LLJ CS
2798

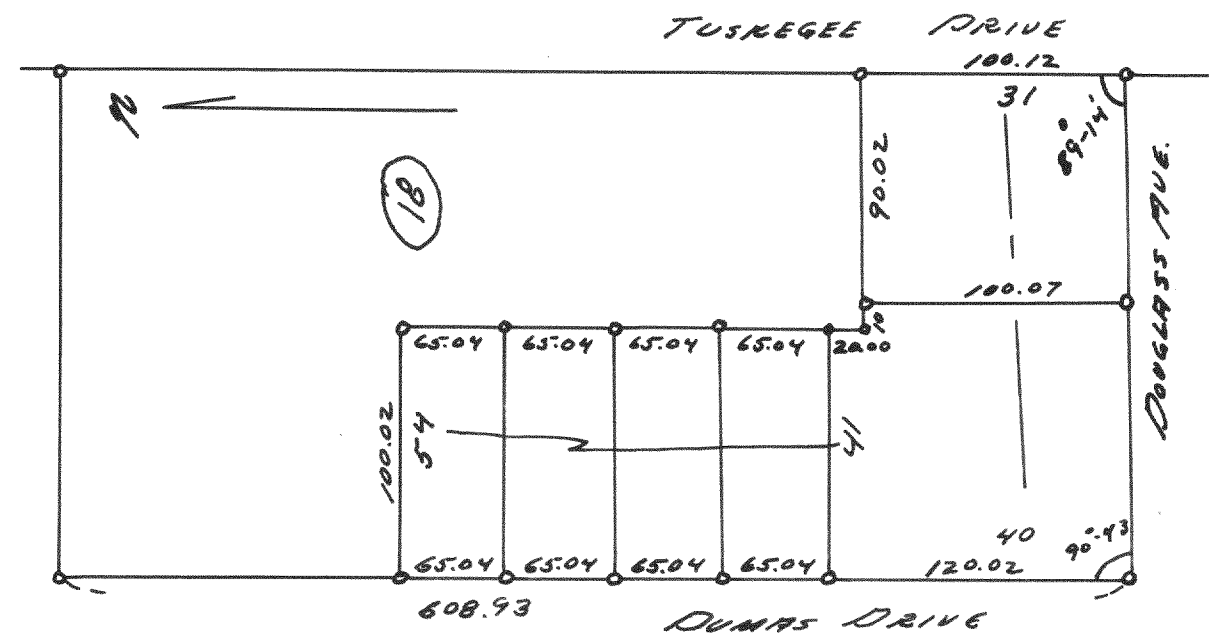

Plat of Survey of
Lots 31-54 Block 18
Lake Ivanhoe Resort
April 53 LLJ CS

2796

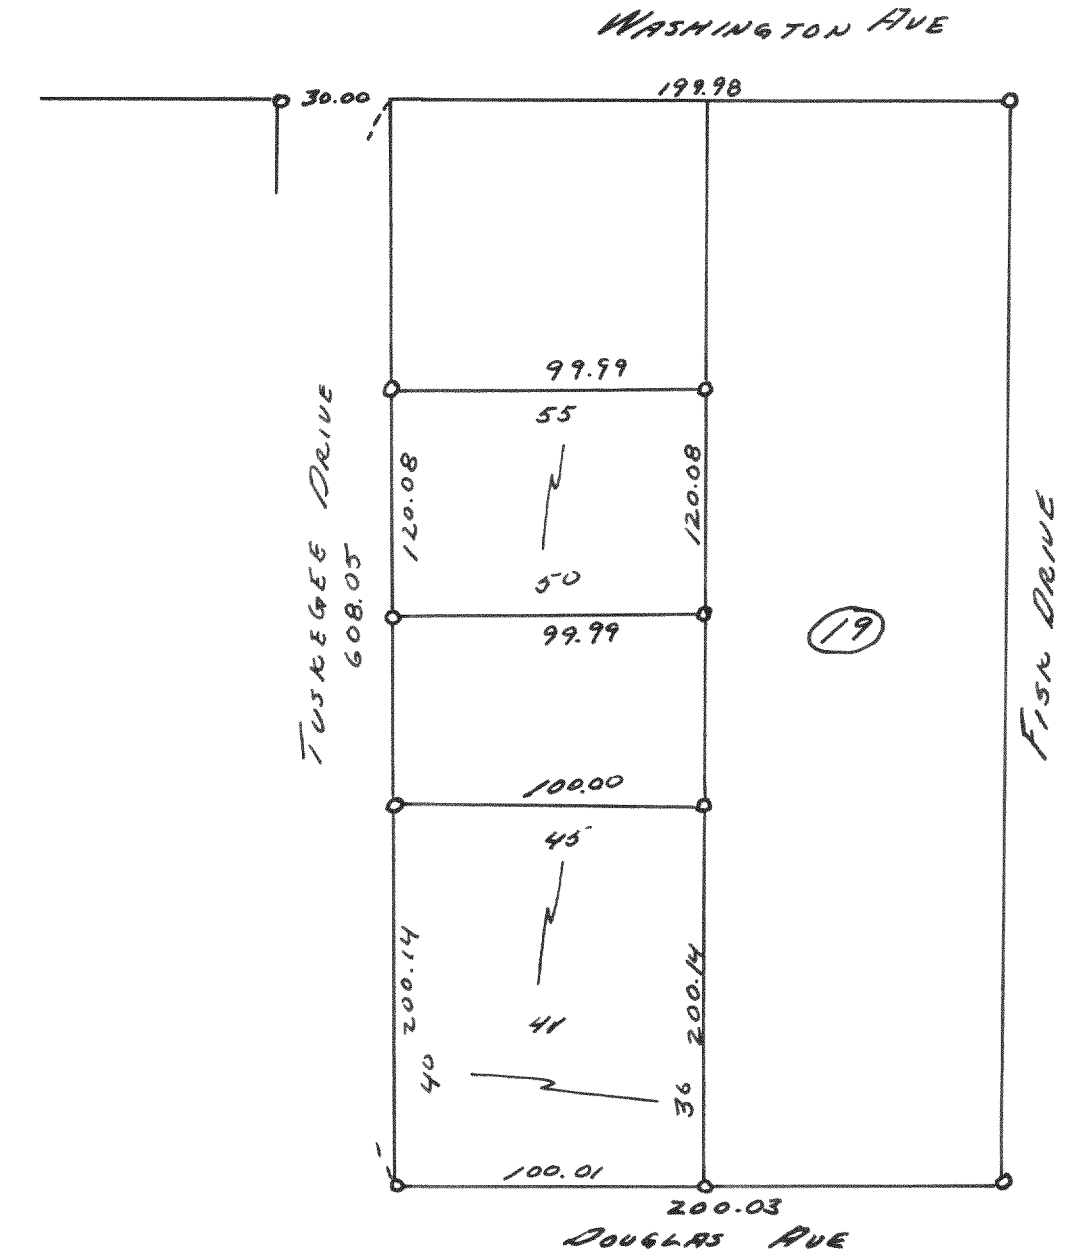

Plat of Survey of Lots
36-40 and 50-55 Block 19 Lake Ivanhoe
Resort May 1953 LLJ CS