


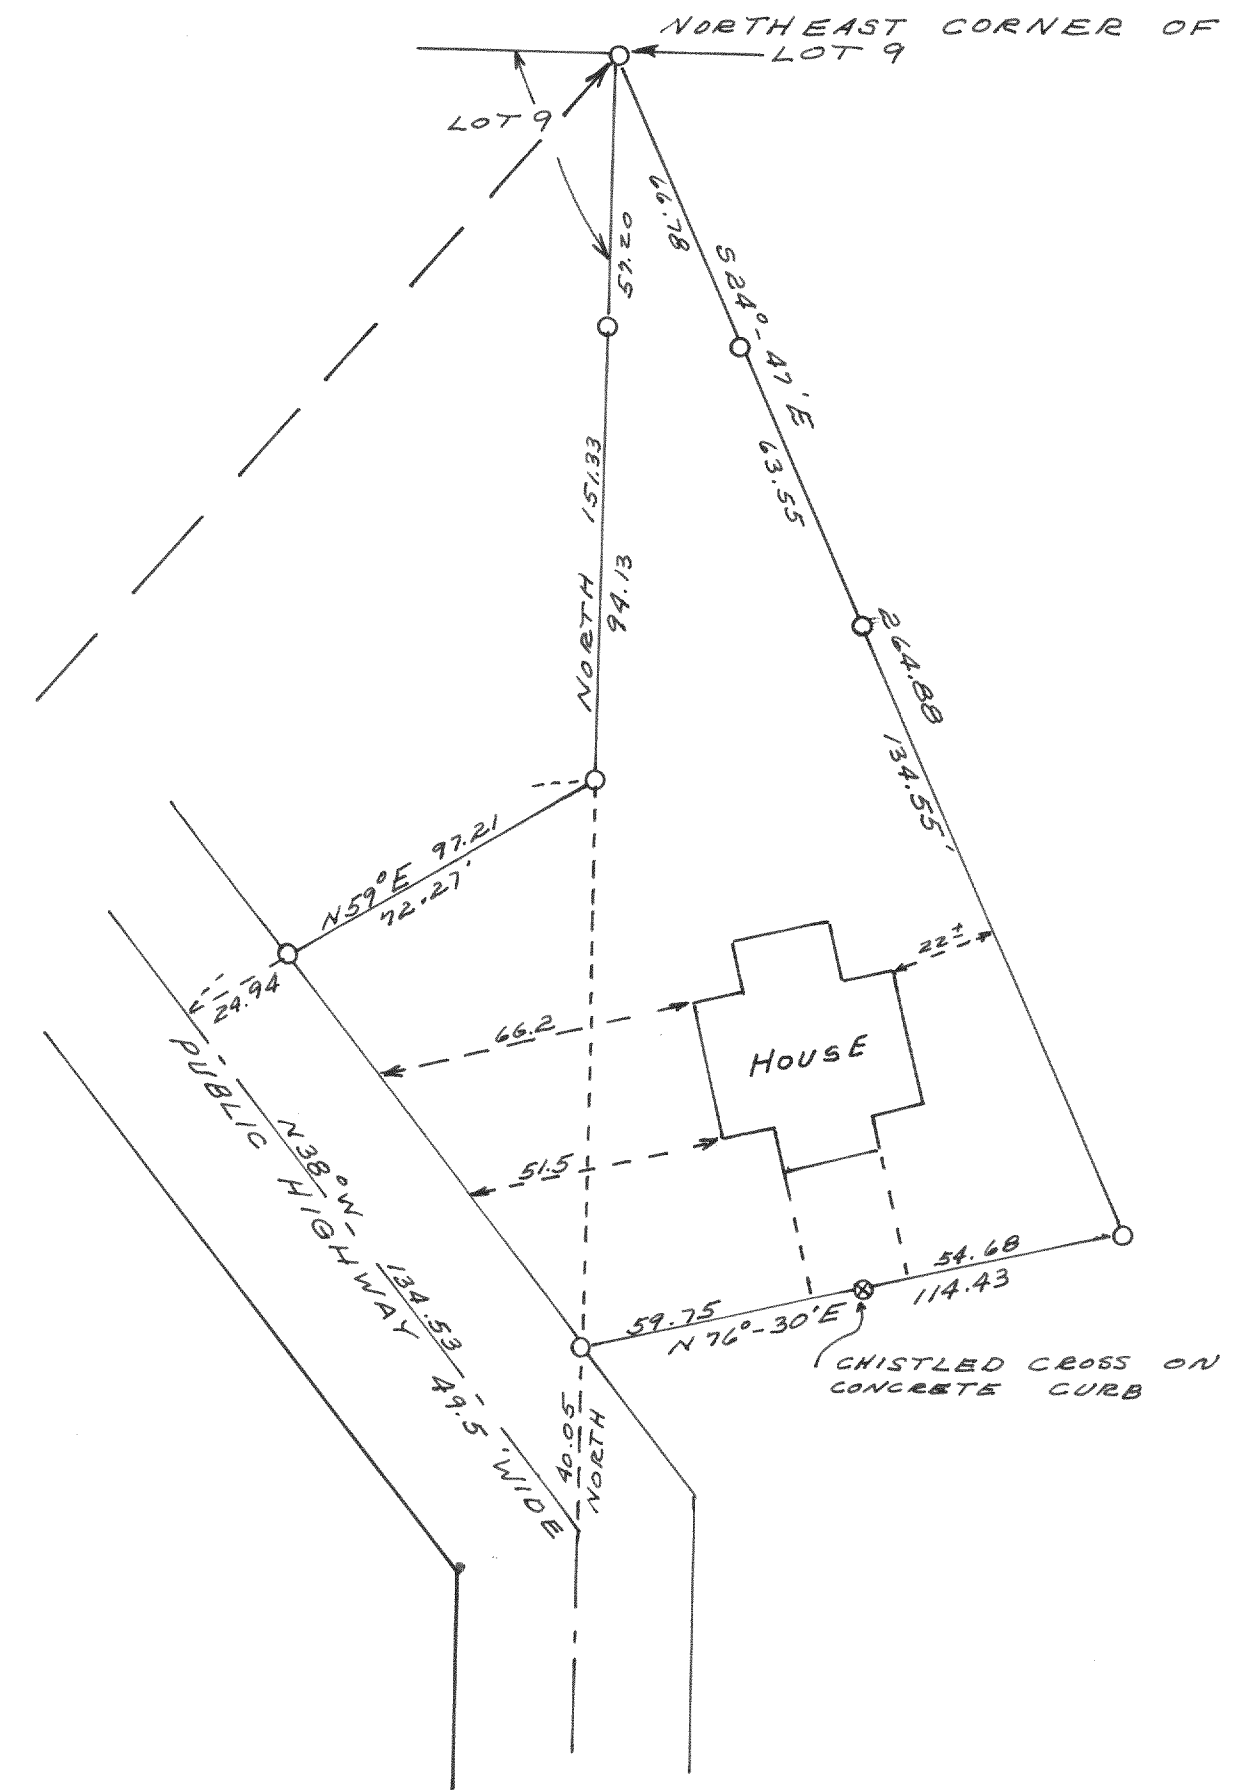

PLAT OF SURVEY OF
PART OF LOT 9 BEULAH LAKE PARK - LAND
LOCATED IN SECTION 4 TAN - RIBE
TOWN OF EAST TROY WALWORTH COUNTY
WIS DEC 1963

Lloyd Jensen
SURVEYOR