

~~444~~
444


#4226

PLAT OF SURVEY
OF

LOTS 1 & 4 - BLOCK - 11 WILLIAMS 2ND
ADDITION TO THE VILLAGE OF WILLIAMS
BAY, WALWORTH COUNTY, WISCONSIN.

OCT. 1964

Lloyd Jensen
CO. SURVEYOR

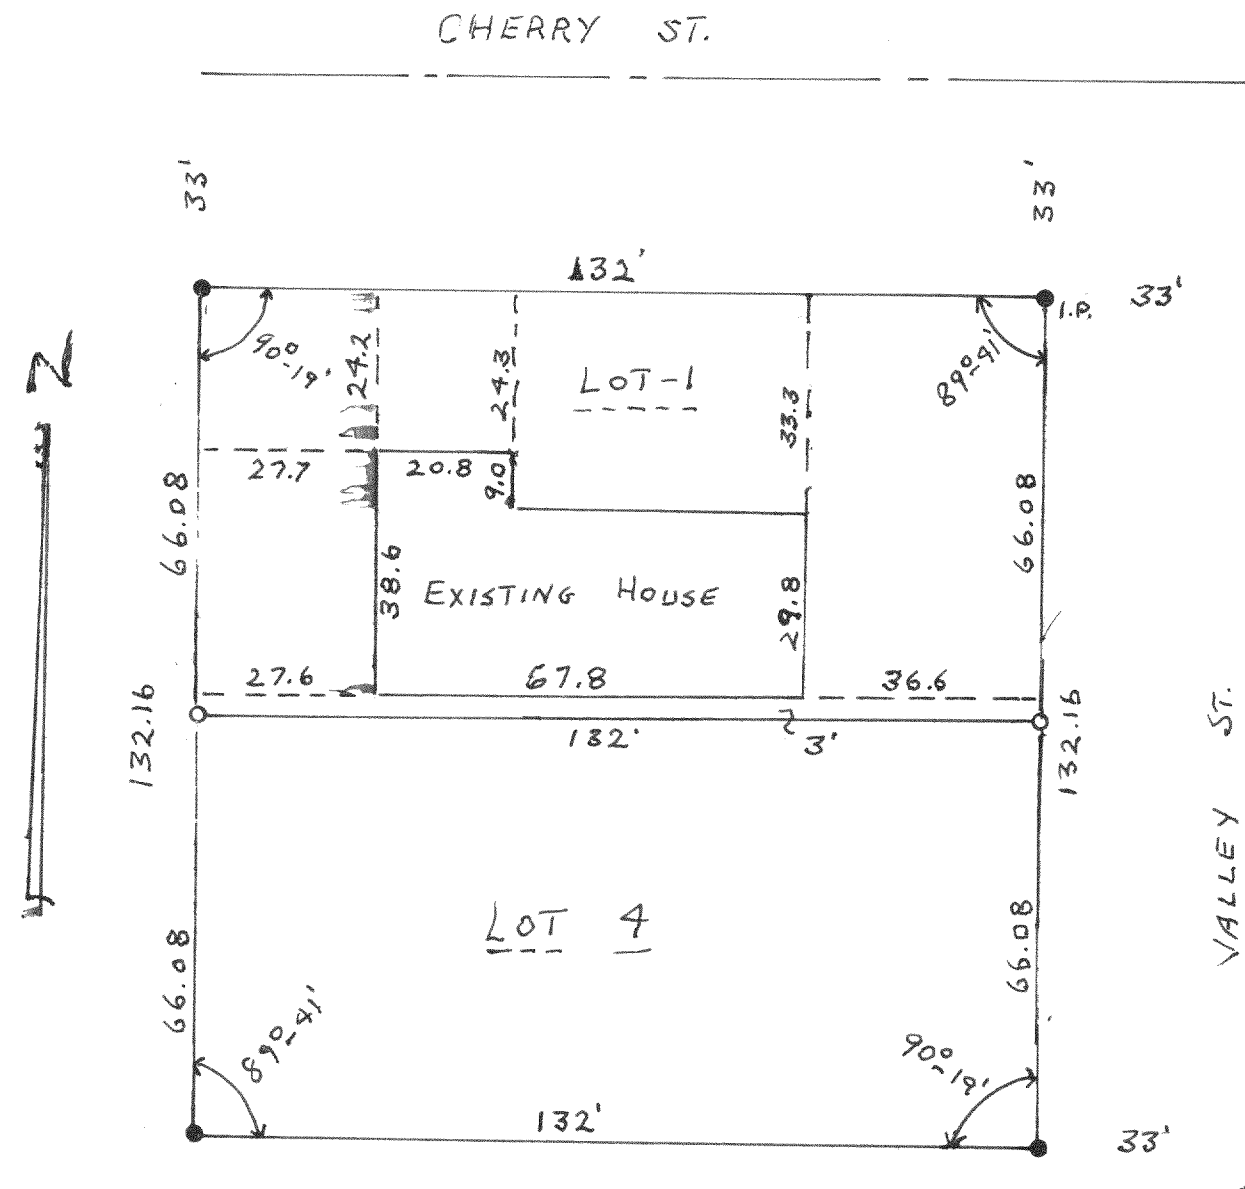

#4227

PLAT OF SURVEY OF

LOT 119, PLAT OF THE ORIGINAL CEDAR
POINT PARK SUBDIVISION, LOCATED IN
SECTION 6, T1N R17E, VILLAGE OF
WILLIAMS BAY, WALWORTH COUNTY, WISCONSIN

JANUARY 1965

Lloyd Jensen
CO. SURVEYOR

