


#4240 PLAT OF SURVEY OF
LOT 15 AND PART OF LOT 14 OF BEULAH LAKE PARK - LOCATED
IN SECTION 4, T4N, R18E, WALWORTH COUNTY, WISCONSIN.
SEPT. 1964 *Clayton Jensen*

H COUNTY, WISCONSIN.
Lloyd Jensen
CO. SURVEYOR

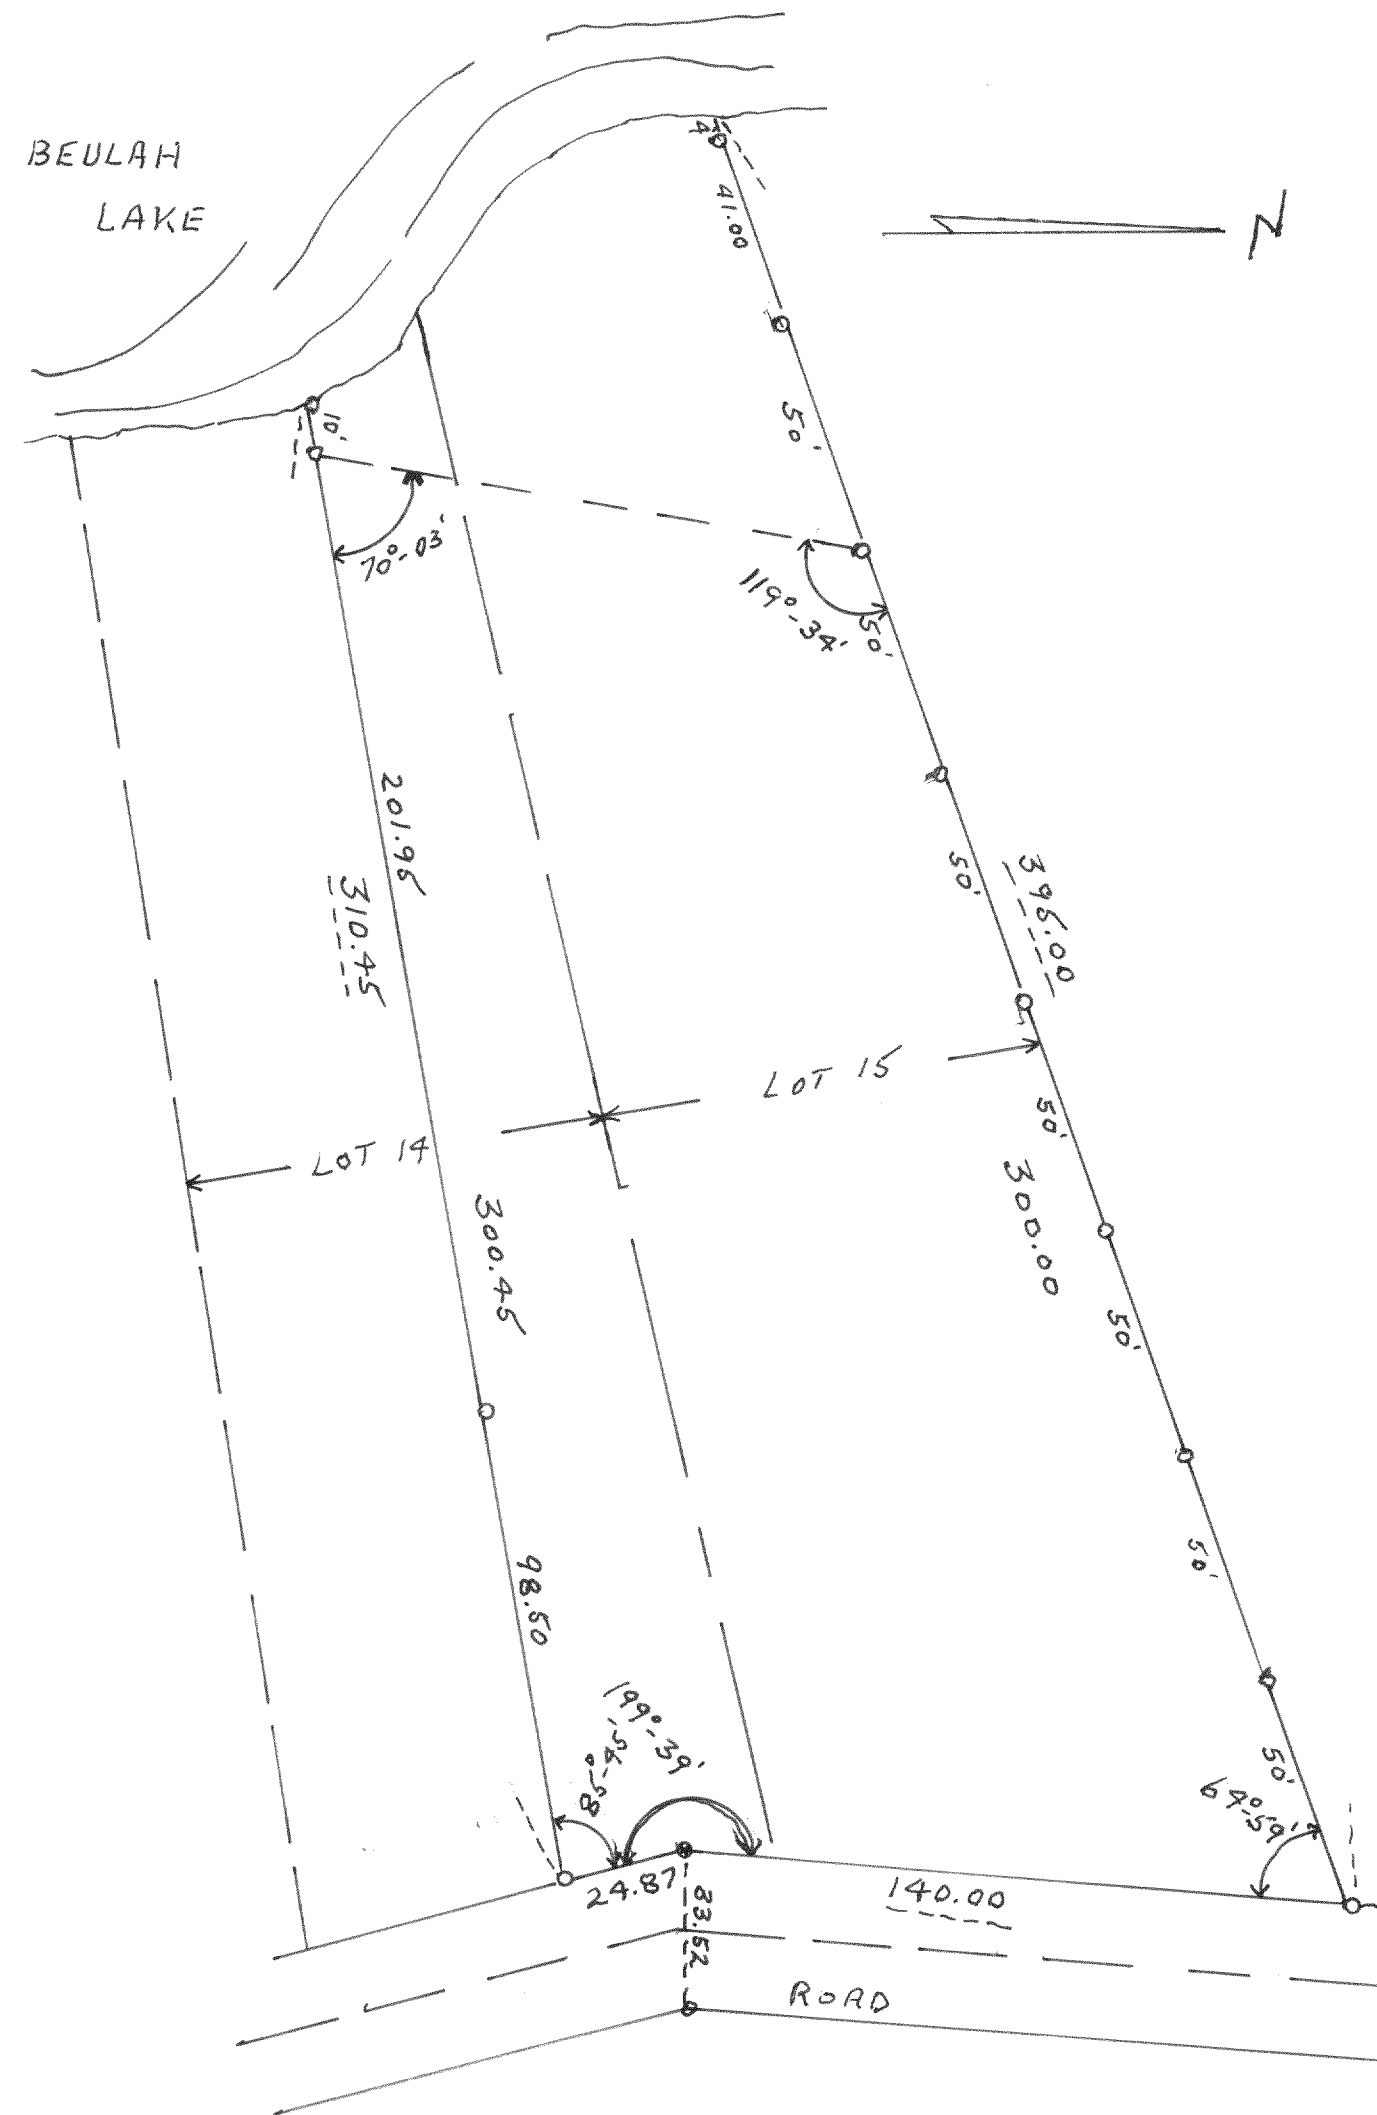

#4241

PLAT OF SURVEY OF
1 ACRE OF LAND LOCATED IN THE
SOUTHWEST $\frac{1}{4}$ OF SECTION 17, T4
NR 18 E OF WALWORTH COUNTY, WIS.

Lloyd Jensen
CO. SURVEYOR

DEC. 17, 1964

