



2809

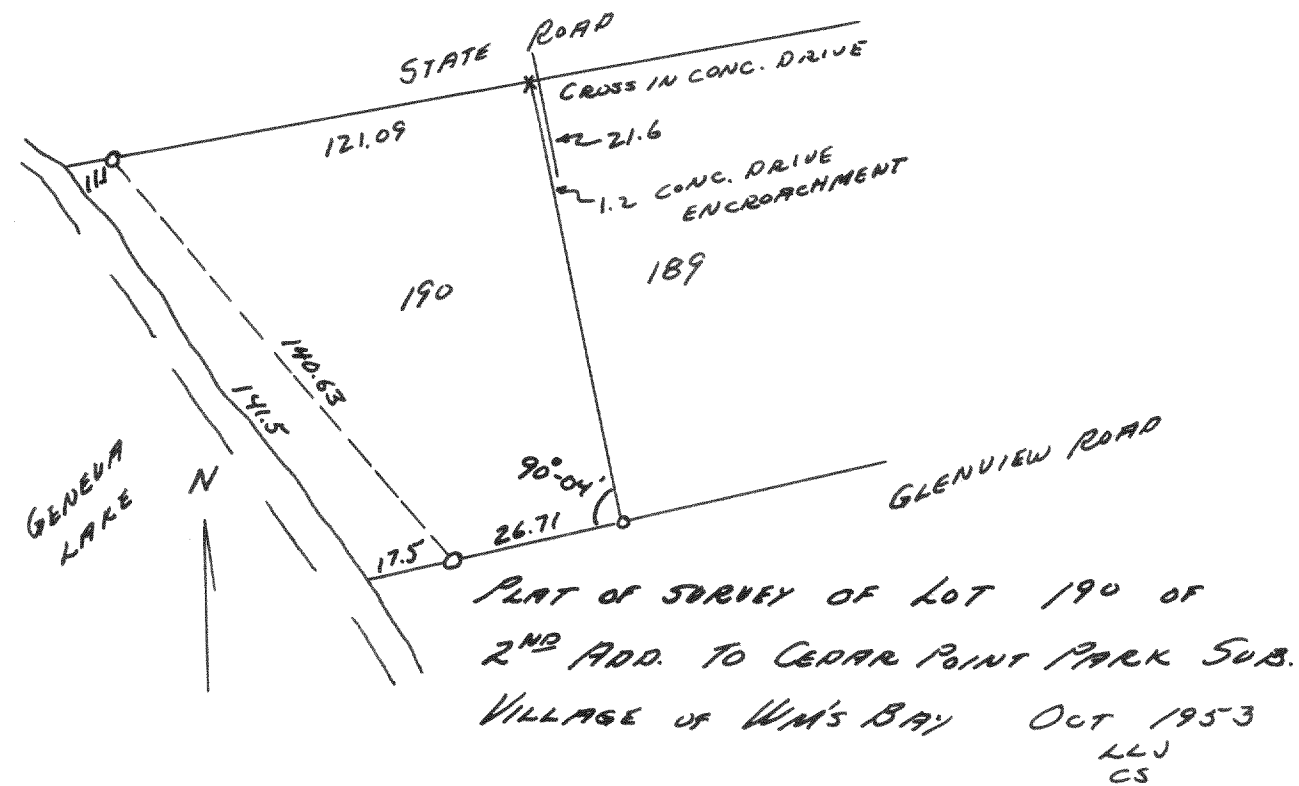


2810

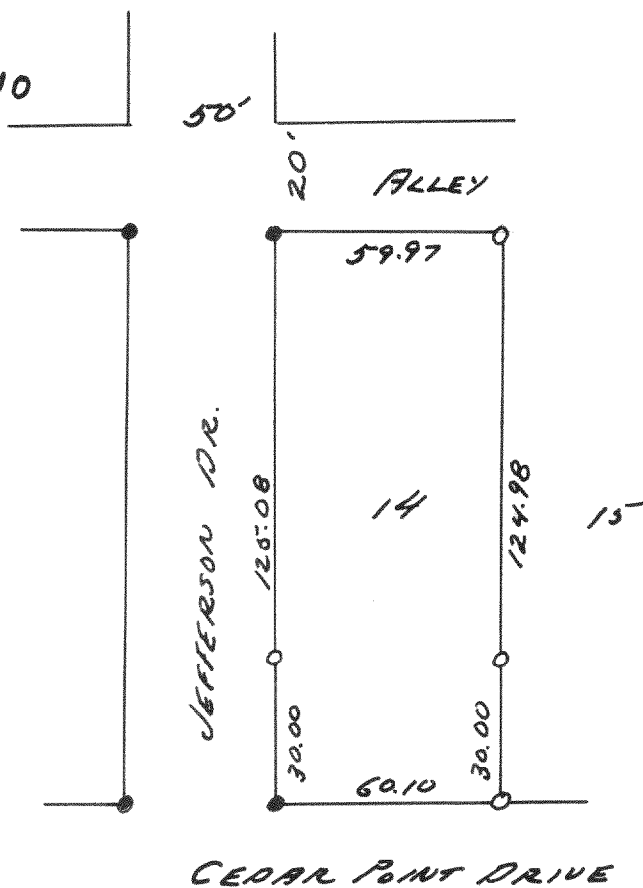


PLAT OF SURVEY OF LOT 14 CEDAR
POINT PARK, ORIGINAL, VILLAGE OF WM'S BAY
NOV. 1953
LLJ
CS

2811

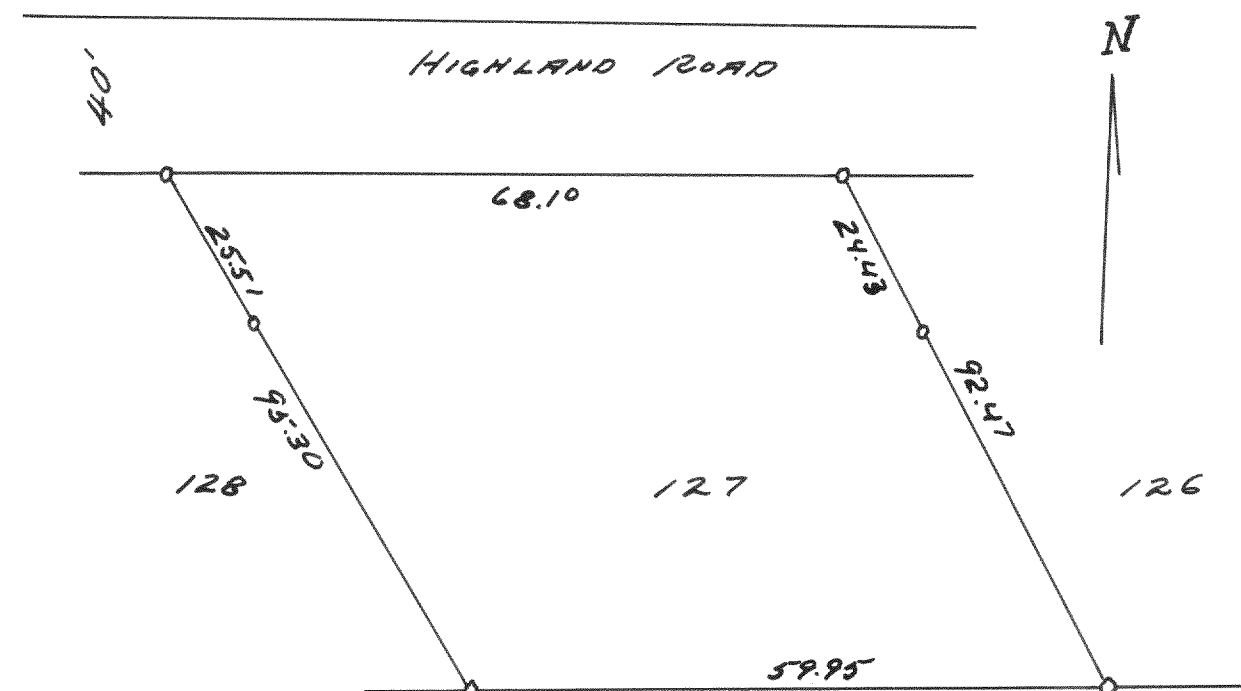


PLAT OF SURVEY OF LOT 127 2ND ADD
CEDAR POINT PARK VILLAGE OF WILLIAMS BAY
SEPT. 1953
LLJ
CS

2812

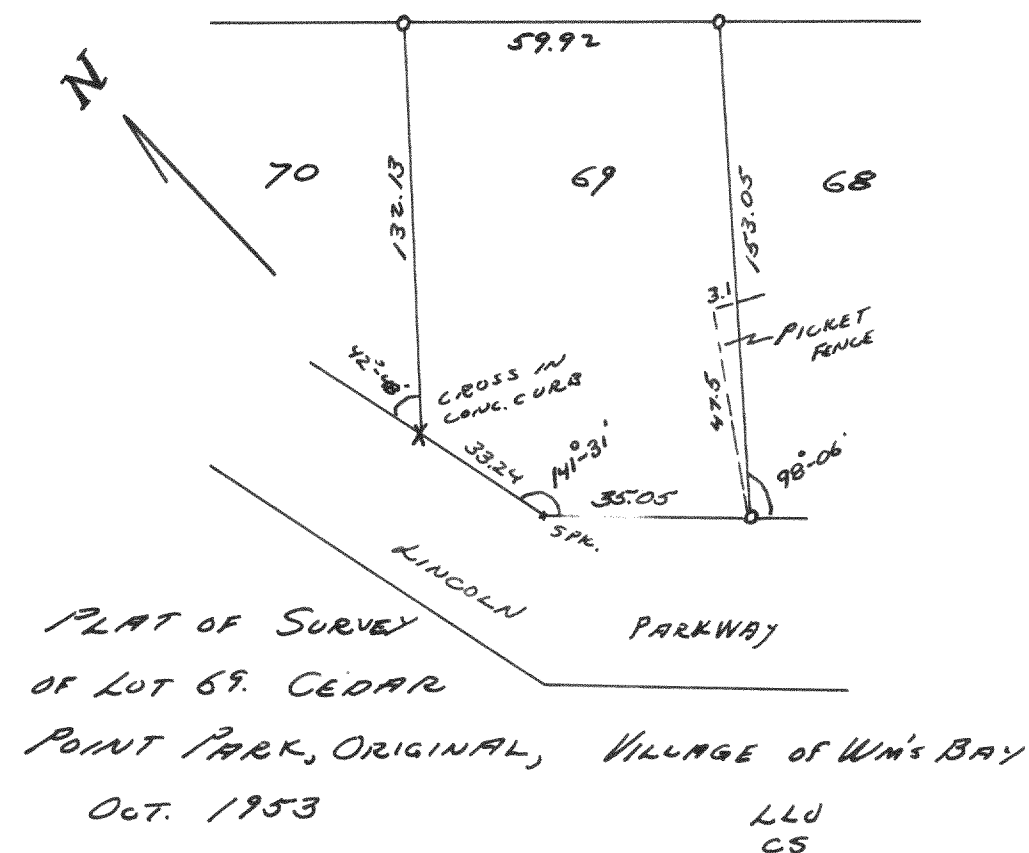


2813

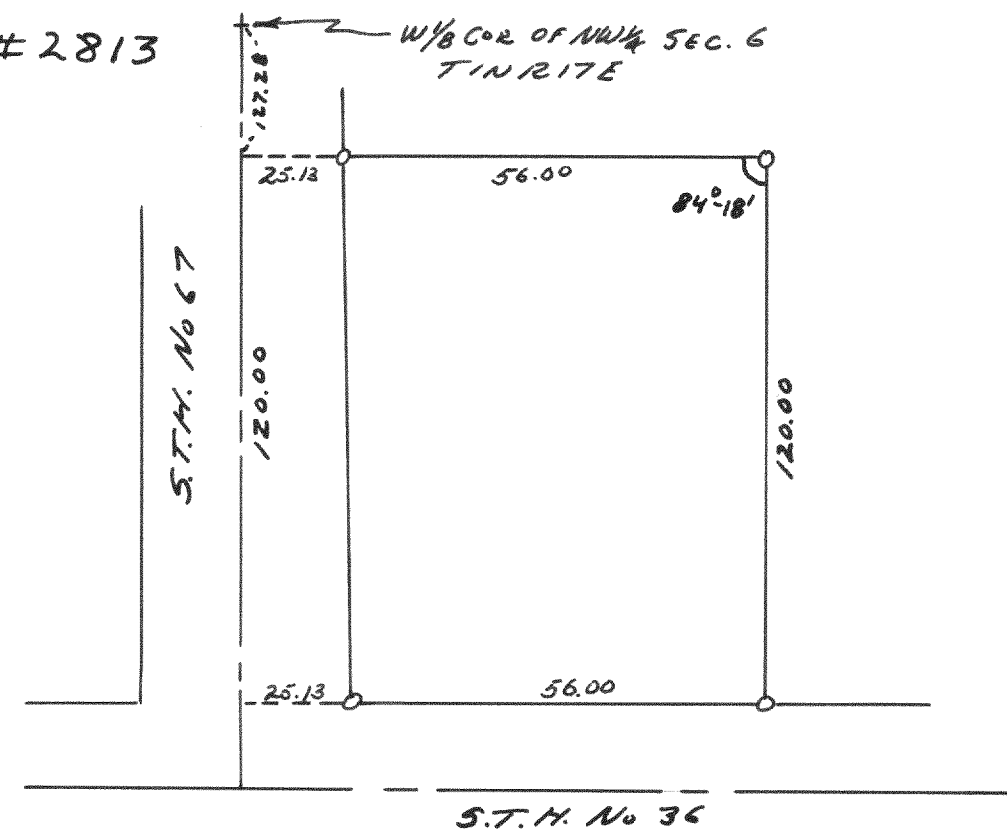

PLAT OF SURVEY OF LAND LOCATED IN
SW 1/4 NW 1/4 SEC. 6. TINRITE
VILLAGE OF WM'S BAY
AUG. 1953
LLJ
CS

2814

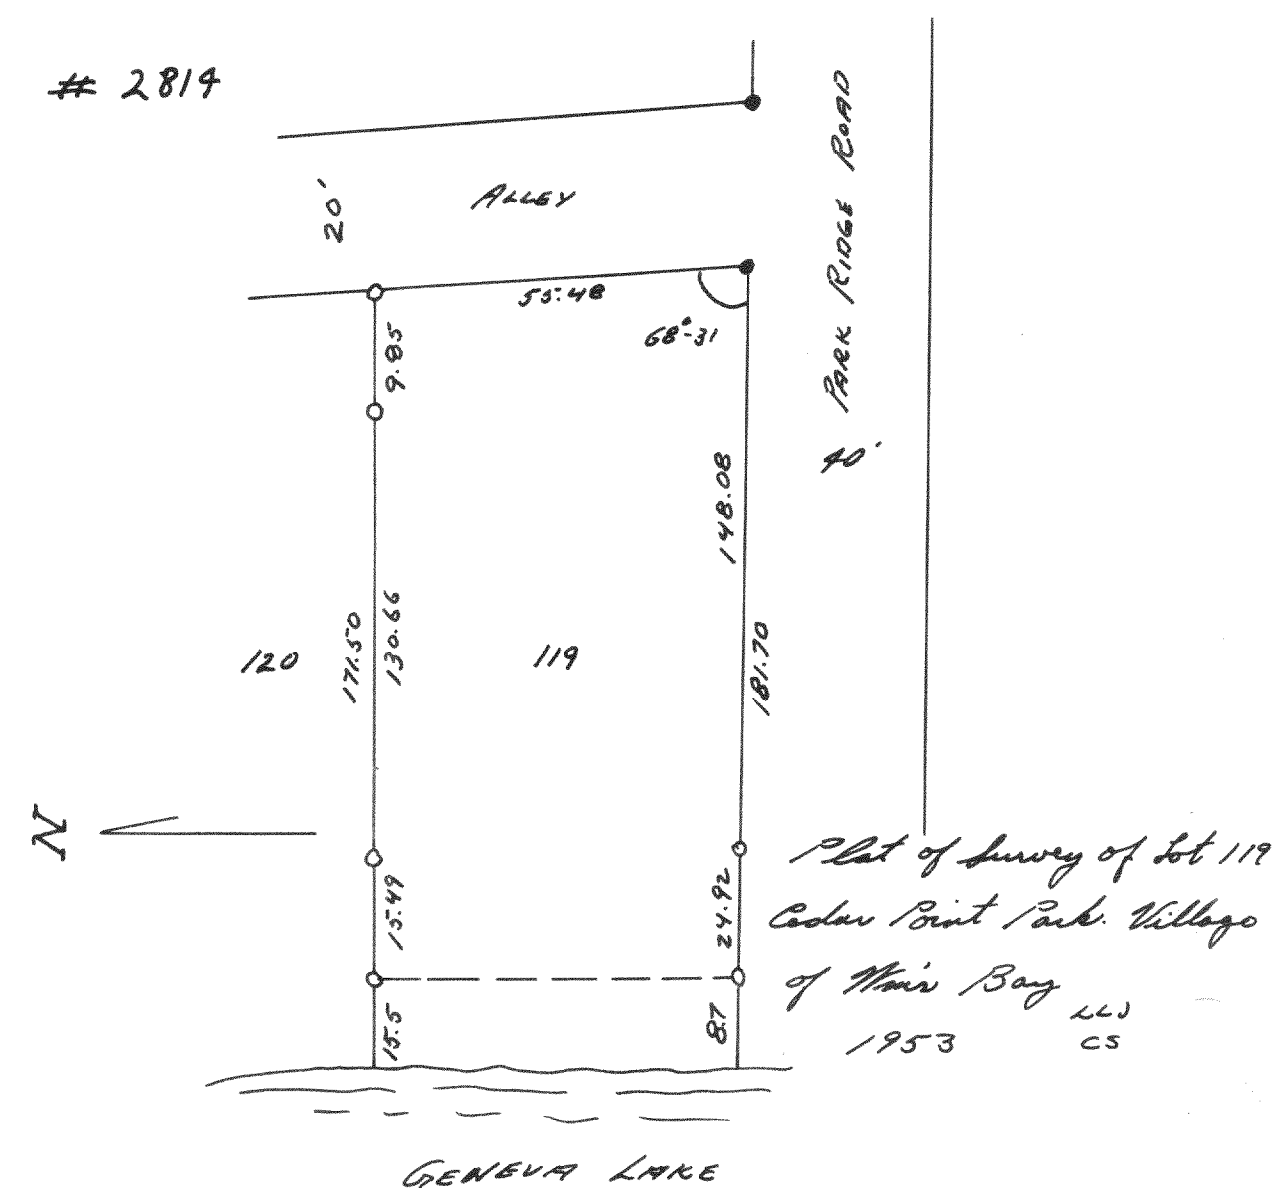

PLAT OF SURVEY OF LOT 119
CEDAR POINT PARK VILLAGE
OF WM'S BAY
1953
LLJ
CS