


#4249

PLAT OF SURVEY OF
LOT 8 BLOCK 12 LAKE
GENEVA MANOR, CITY
OF LAKE GENEVA, WAL
CO. WIS.

MAY 10, 1963

Lloyd Jensen
C.D. SURVEYOR

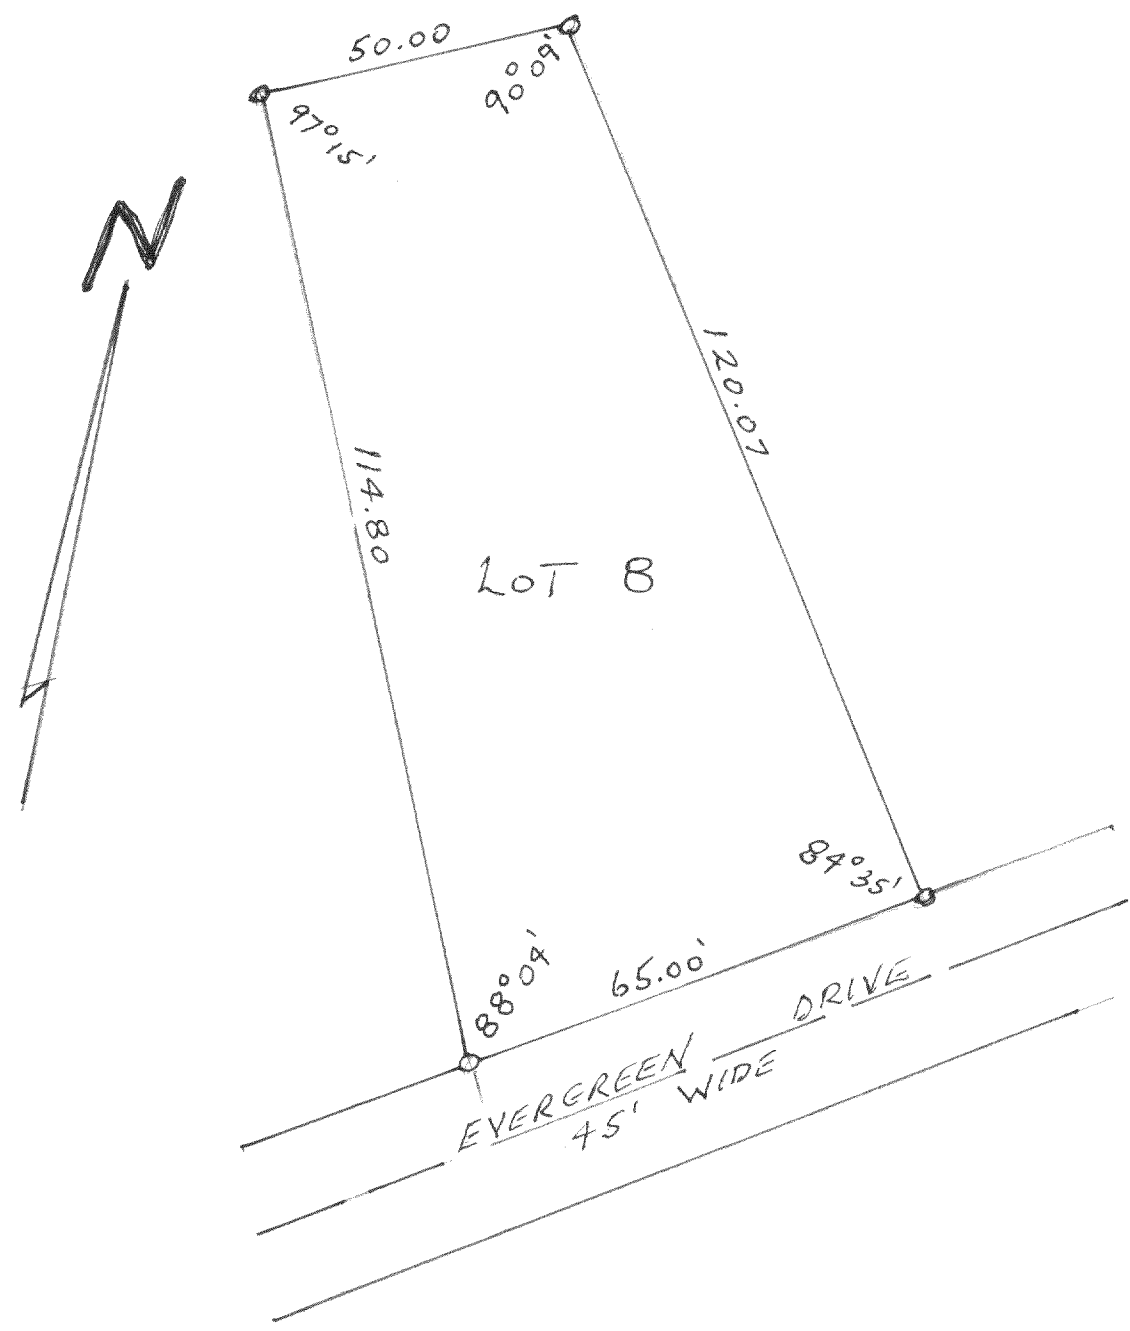


#4250

PLAT OF SURVEY OF
PART OF LOT 25 BLOCK 31
LAKE GENEVA MANOR, CITY OF
LAKE GENEVA, WAL. CO. WIS.

MAY 1962

Lloyd Jensen
C.D. SURVEYOR

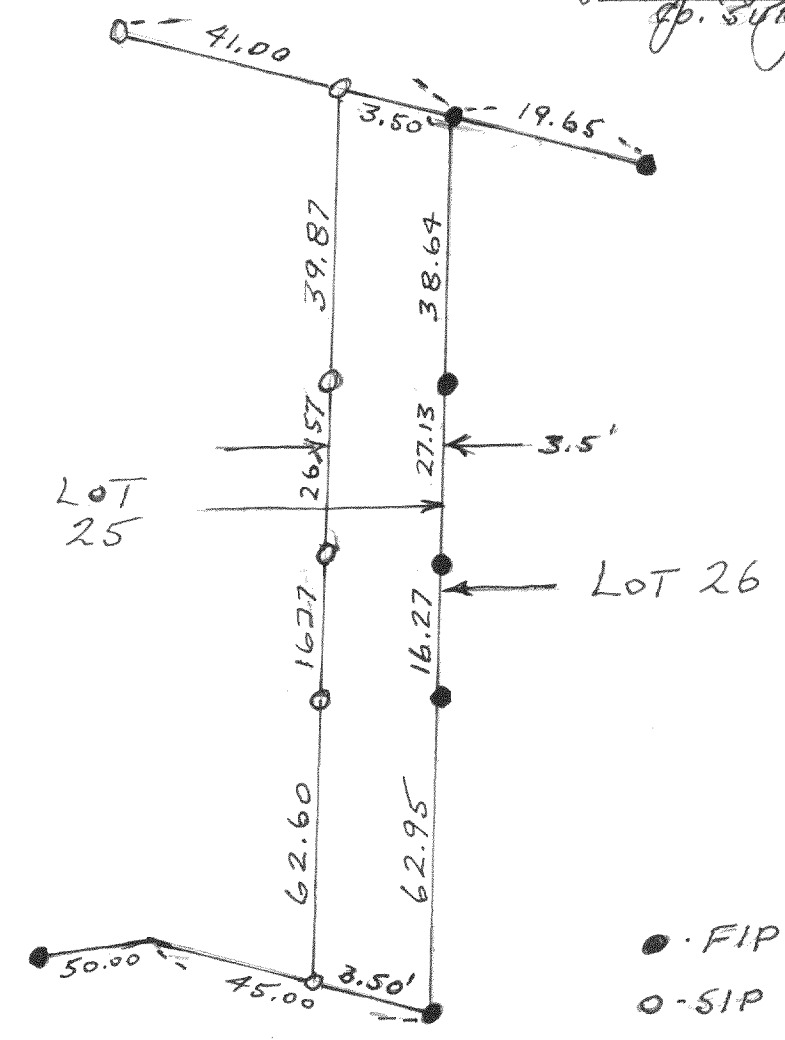

#4251

PLAT OF SURVEY OF
LOT 4, BLOCK 31, LAKE
GENEVA MANOR, CITY OF
LAKE GENEVA, WAL. CO. WIS.

MAY 1963

Lloyd Jensen
C.D. SURVEYOR

