




Lloyd Jensen
CO. SURVEYOR

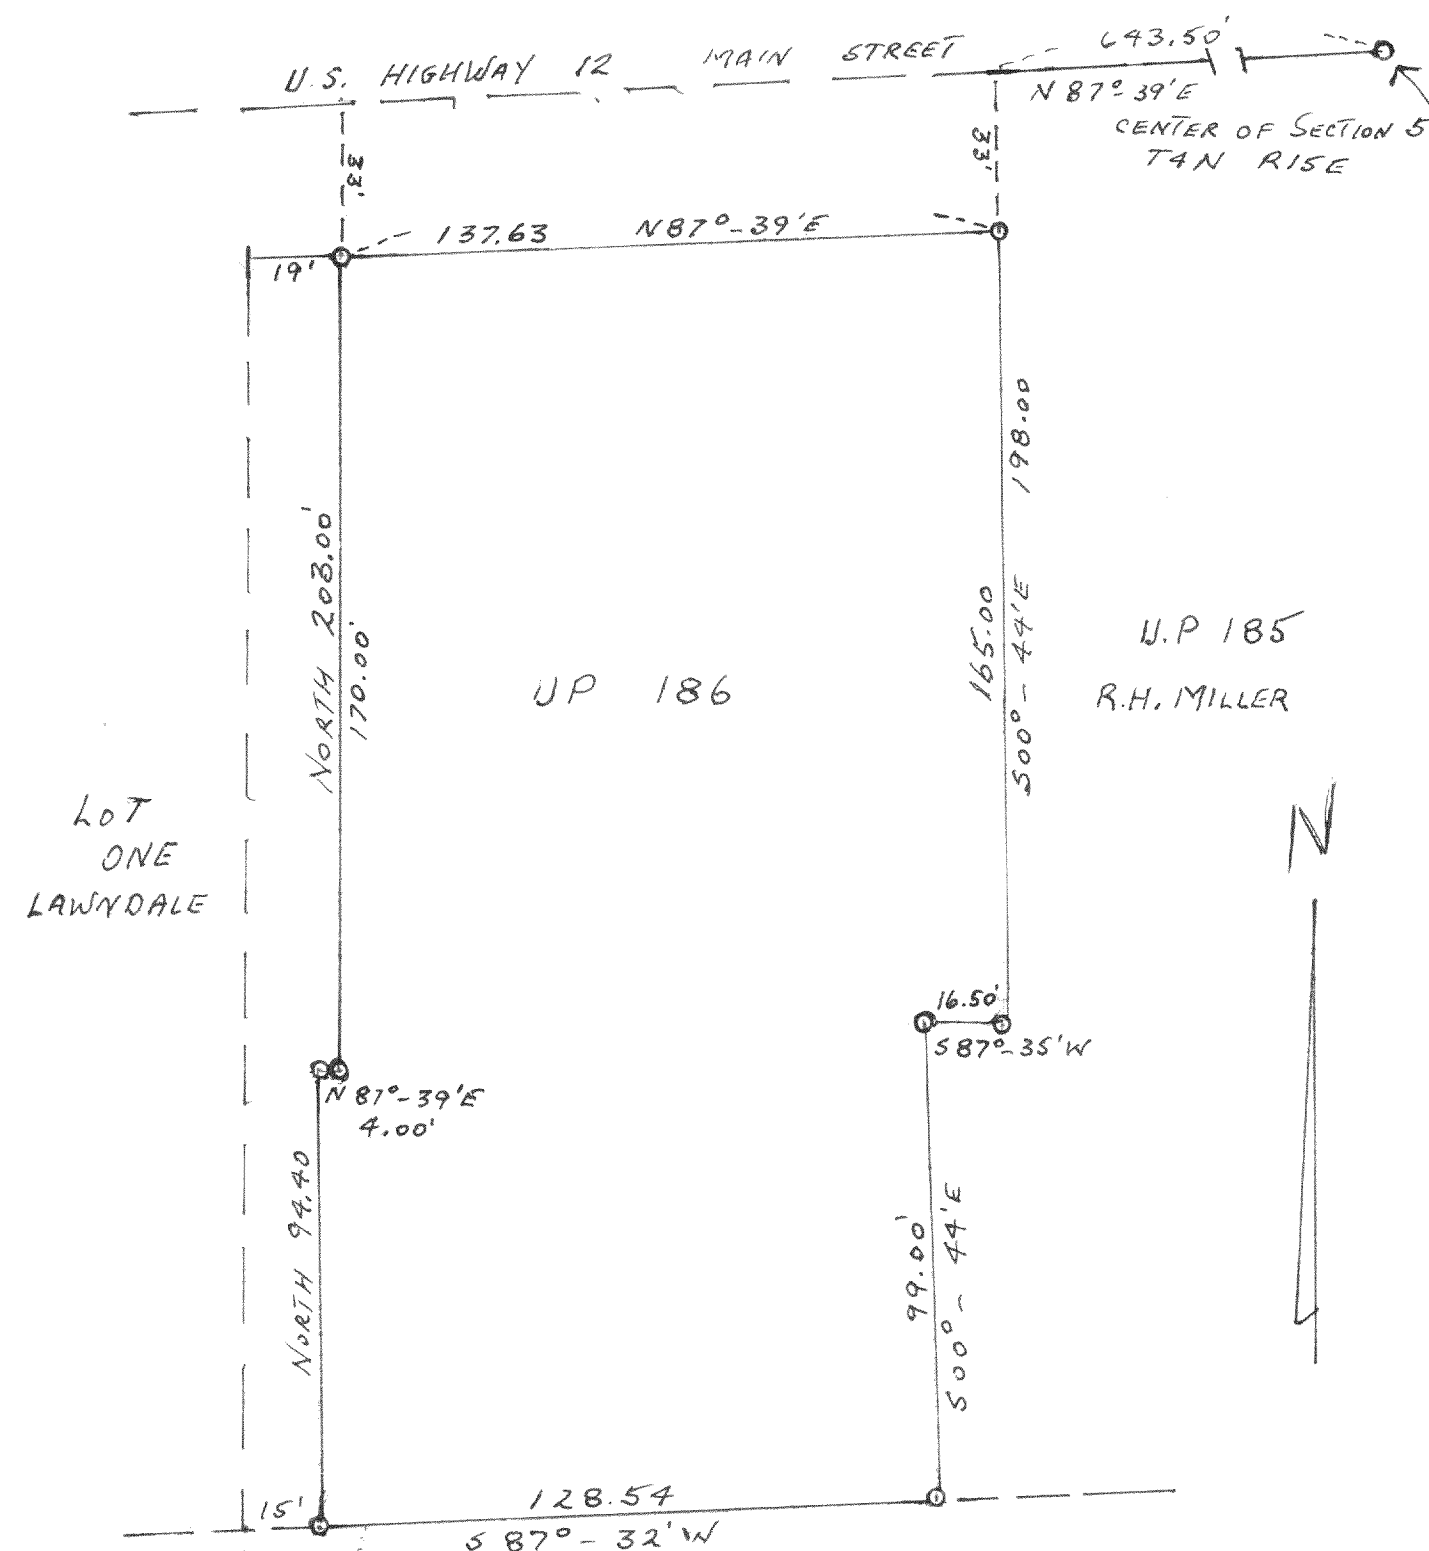