



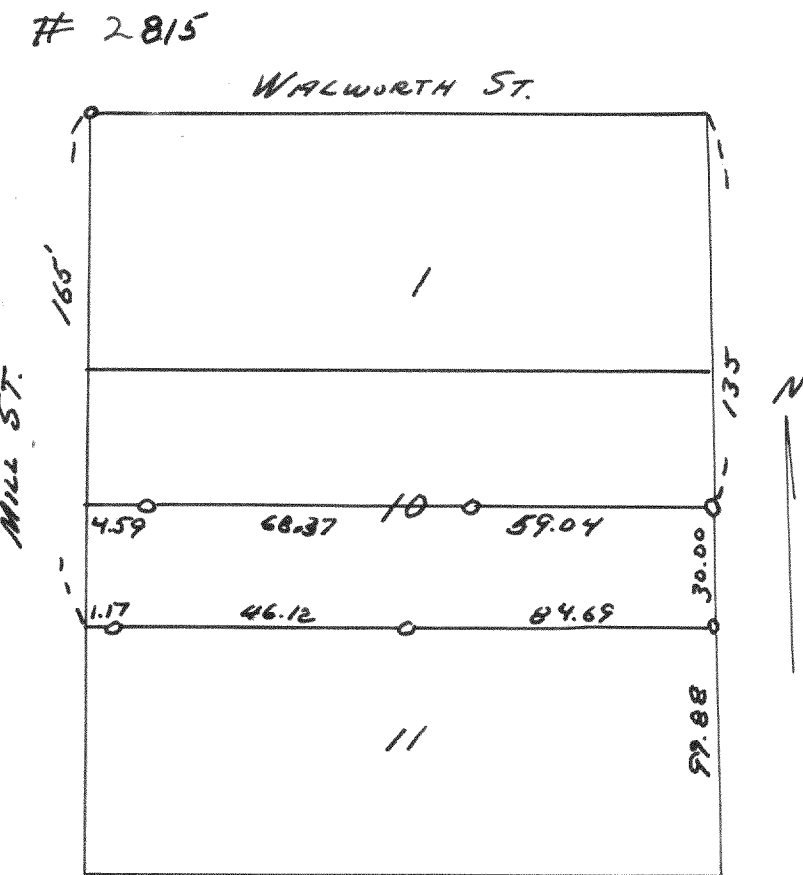


Plat of Survey of Lots 1, 10 & 11
Village of Geneva City, original
June 9, 1953 L.L.V.
C.S.


2819
Plat of Survey of Lot 1 Block 3
Indian Hills Subdivision
Village of Fontana on Geneva Lake
Oct 1953 L.L.V.
C.S.

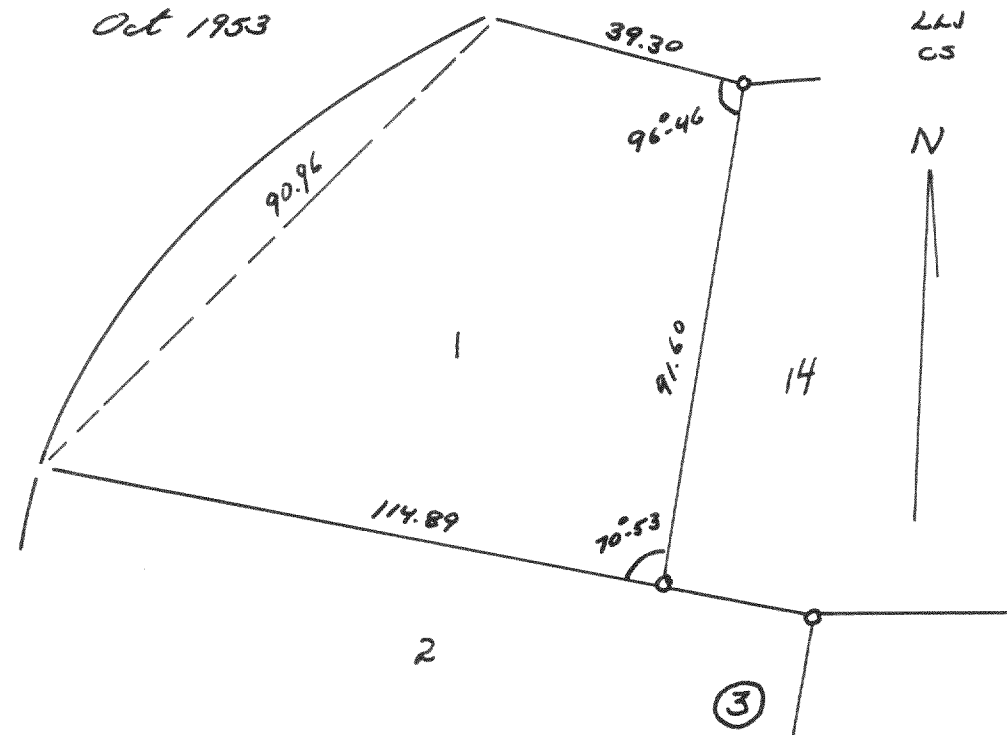

2816

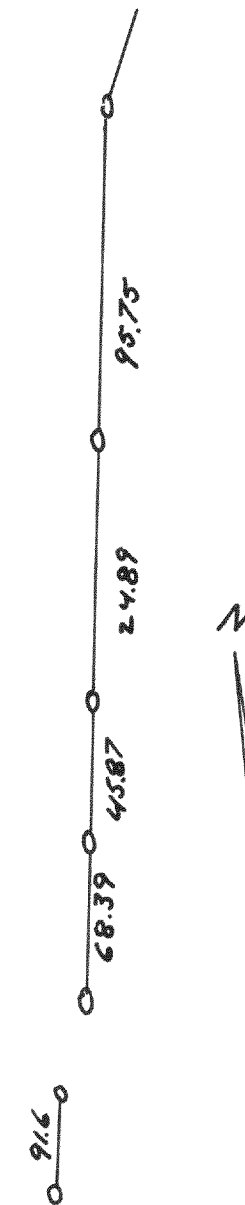


Plat of Survey of East Line of
Lot 16 Block 1 Indian Hills Sub
Village of Fontana - on - Geneva Lake
Oct 1953 L.L.V.
C.S.

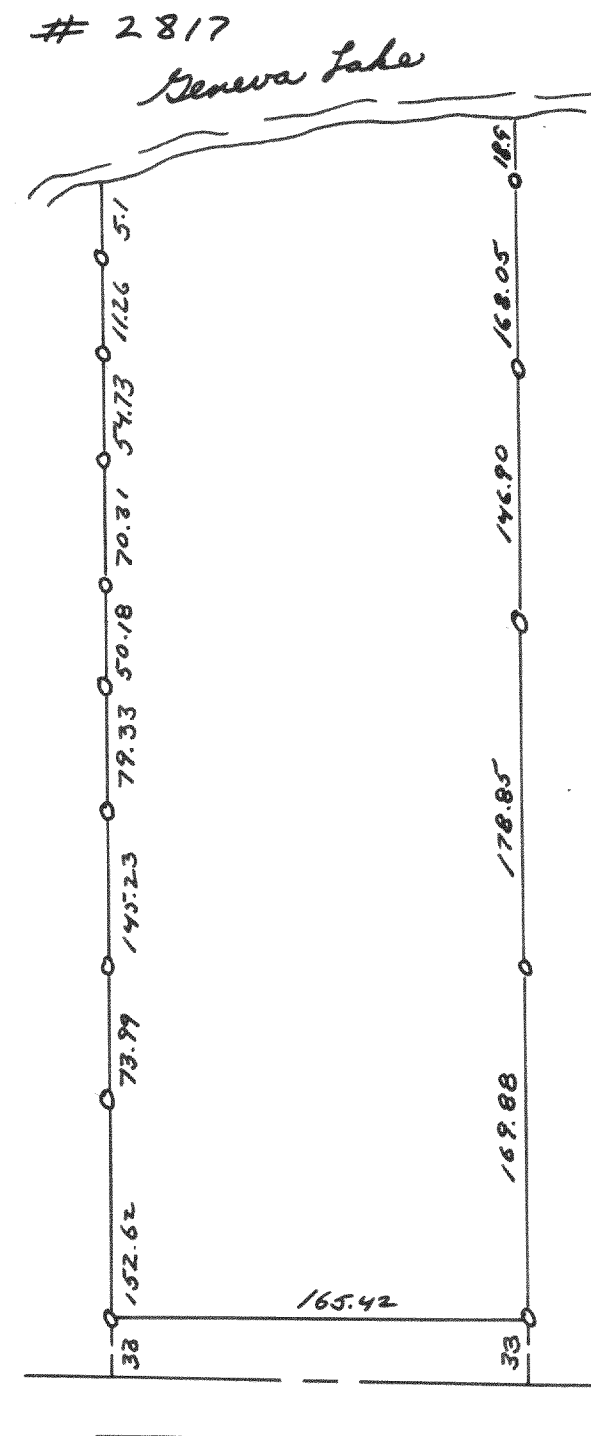


Plat of Survey of Lot 1
of Robert Gardner Sub.
Village of Fontana on Geneva Lake
Aug. 1953 L.L.V.
C.S.

2818

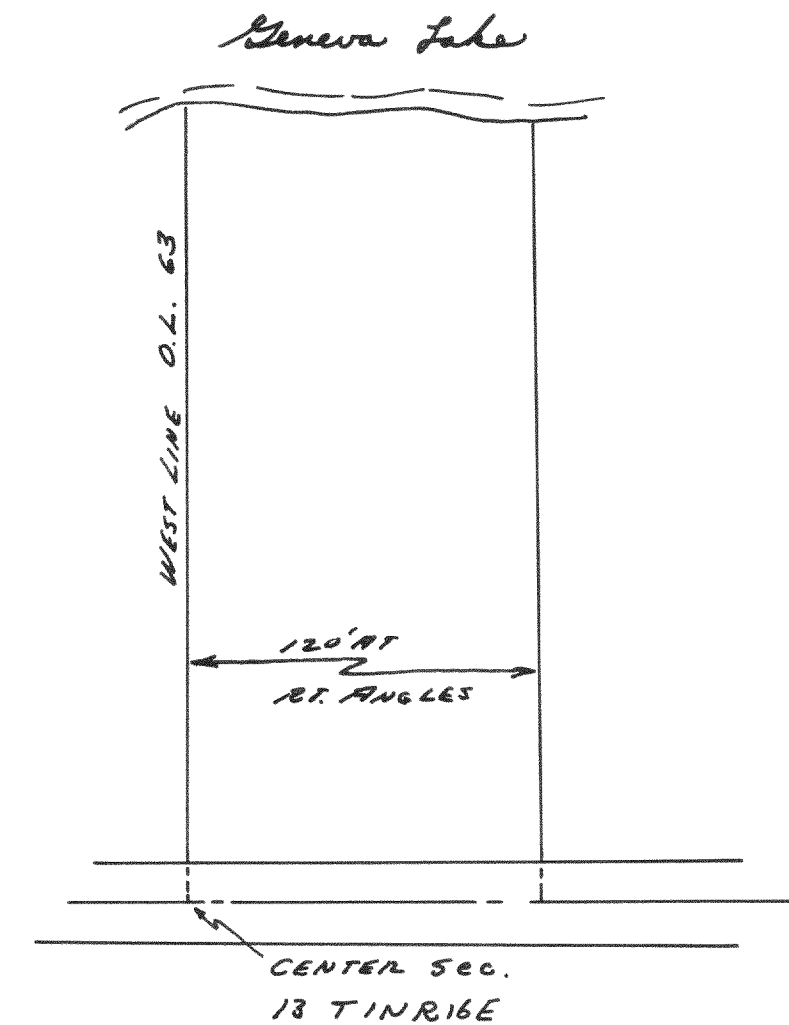

Plat of Survey of West 120 ft.
of O.L. 63 Assessor's Plat No. 1
Village of Fontana on Geneva Lake
1953 L.L.V.
C.S.

2820

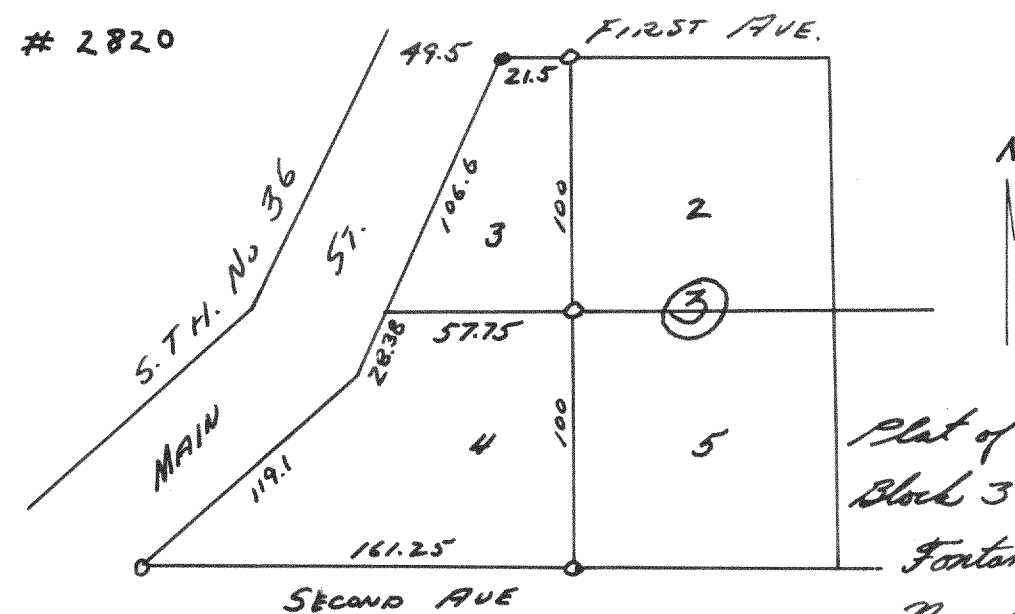

Plat of Survey of West Part of
Block 3 Original Plat Village of
Fontana on Geneva Lake
March 1953 L.L.V.
C.S.