


#4281

PLAT OF SURVEY OF
LOTS 12,219 - 12,239 INCLUSION,
LAKE COMO BEACH SUBD., LOCATED
IN T2N R17E, WALWORTH CO, WISCONSIN
SEPT. 1964


Lloyd Jensen
CO. SURVEYOR

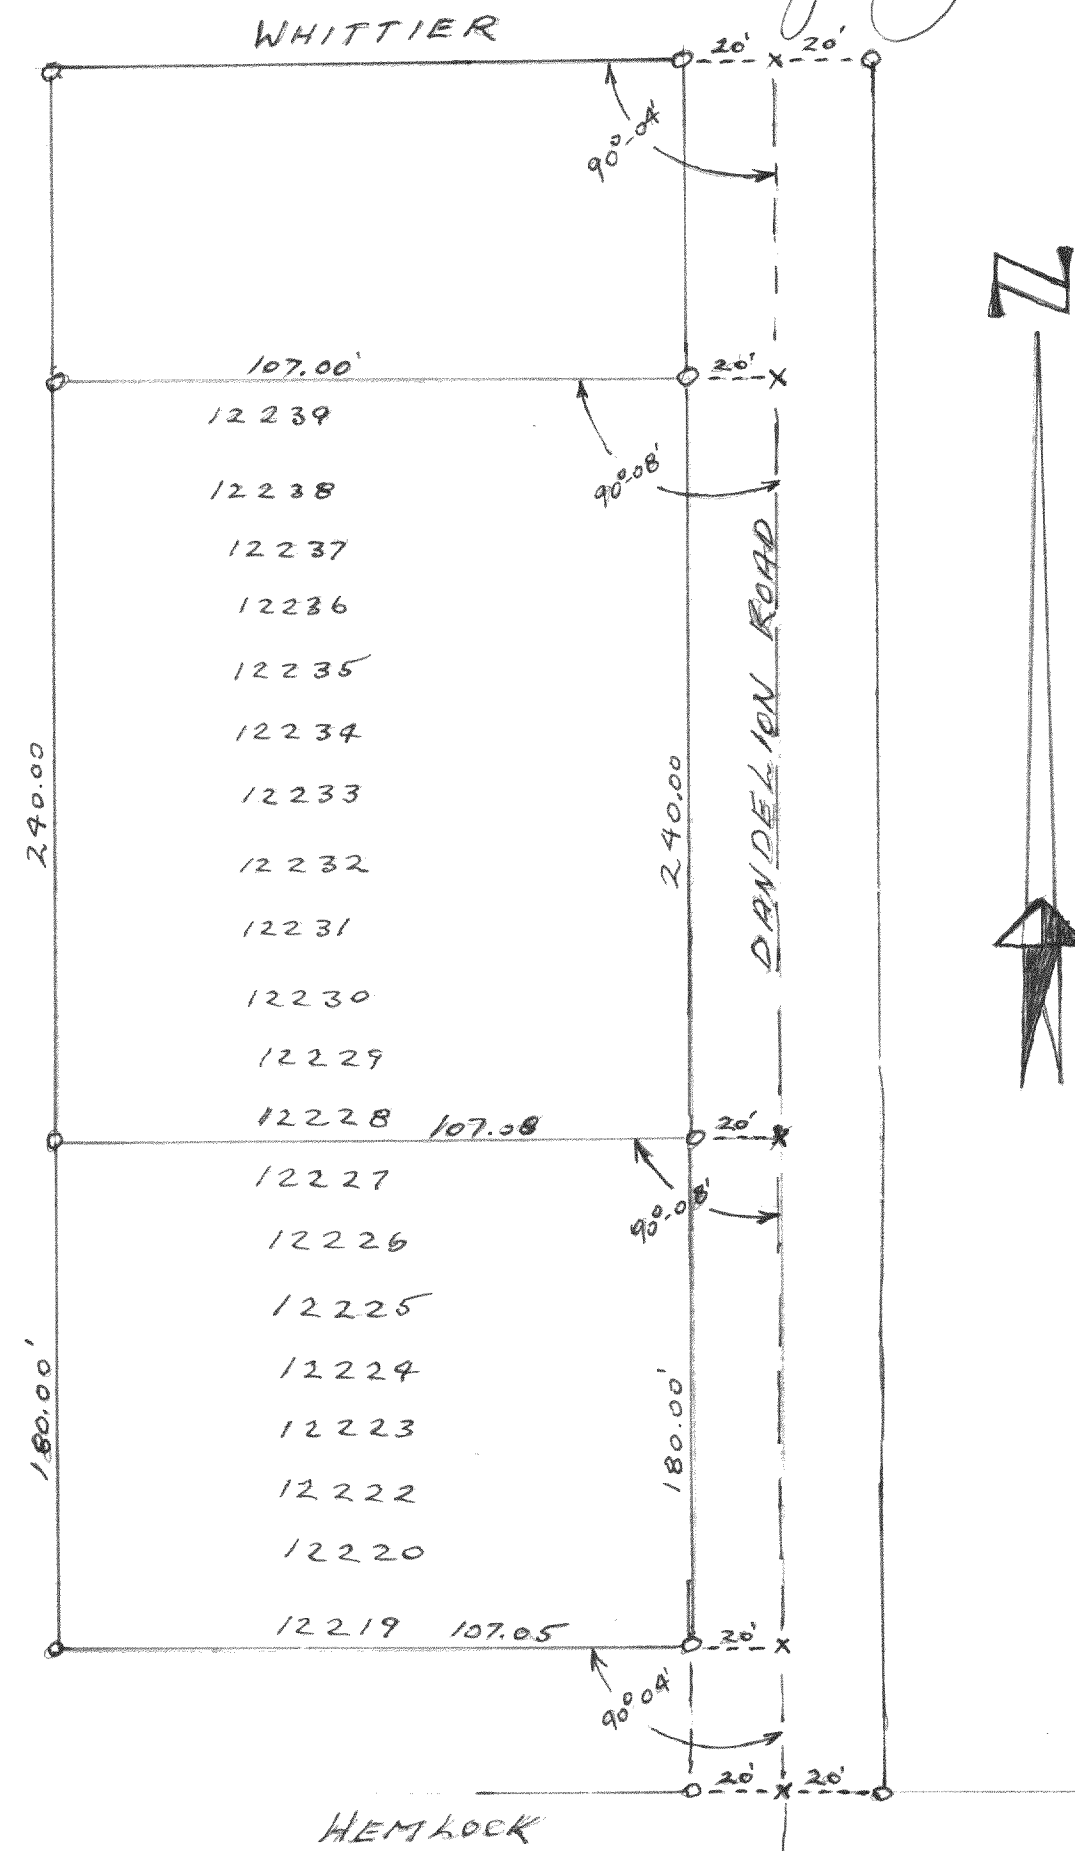


#4282

PLAT OF SURVEY OF
LAND LOCATED IN THE S 145'
W 1/2 - SE 1/4 - SE 1/4 - SW 1/4 SEC. 26,
T2N, R17E, WAL. CO. WIS
SEPT. 1964

Lloyd Jensen
CO. SURVEYOR

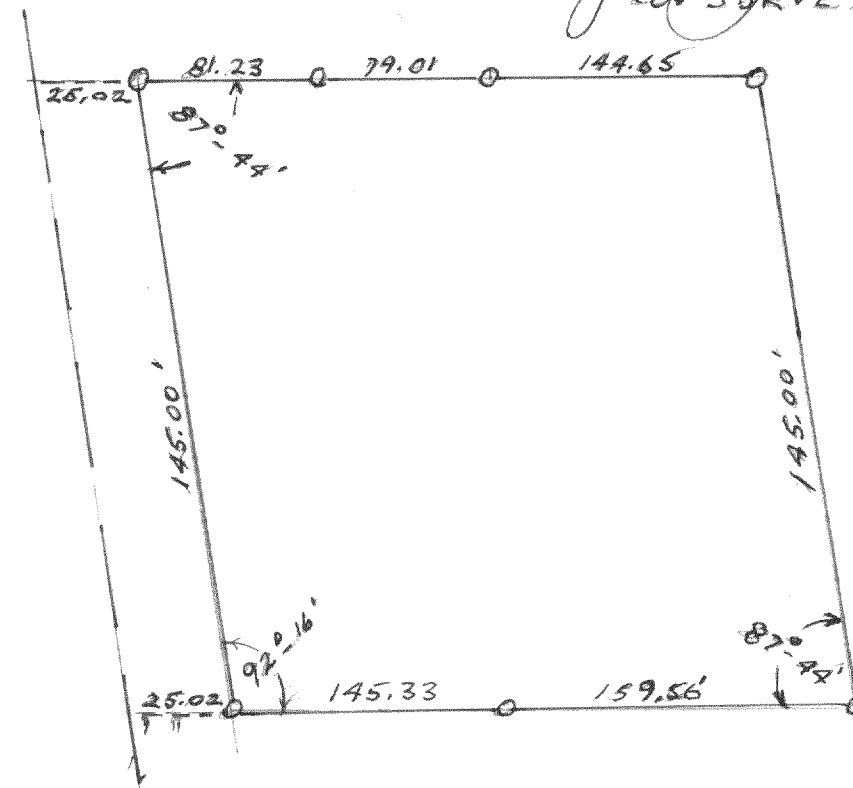

#4283

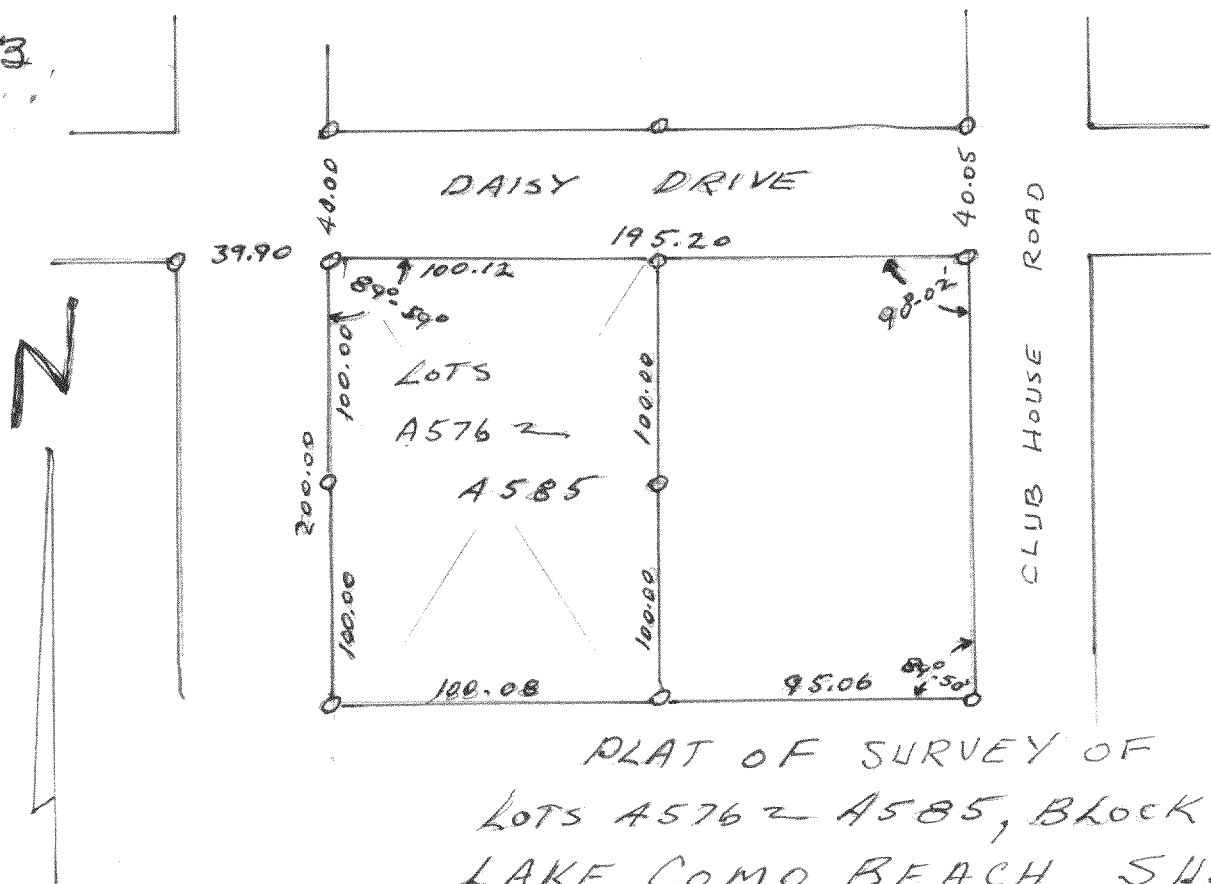

PLAT OF SURVEY OF
LOTS A576 - A585, BLOCK 79
LAKE COMO BEACH SUBD
WAL. CO. WISCONSIN
SEPT 1962

Lloyd Jensen
CO. SURVEYOR