



2821

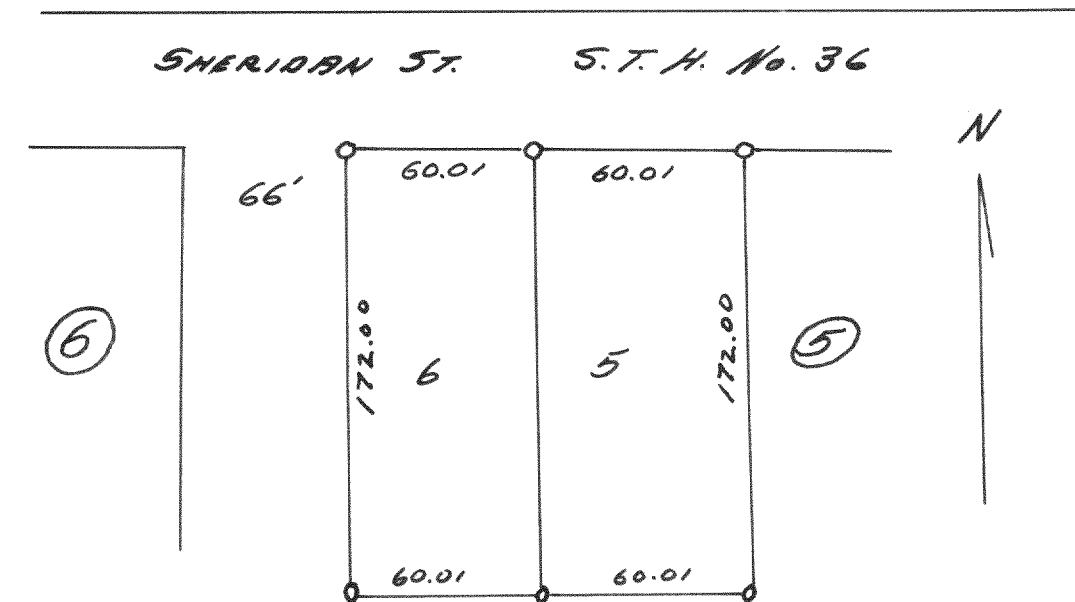

PLAT OF SURVEY OF LOTS 5 & 6
BLK 5 GENEVA LAKE CRAWFORD MFG. CO.
ADD. CITY OF LAKE GENEVA
NOV. 1953

LLJ
CS


2822

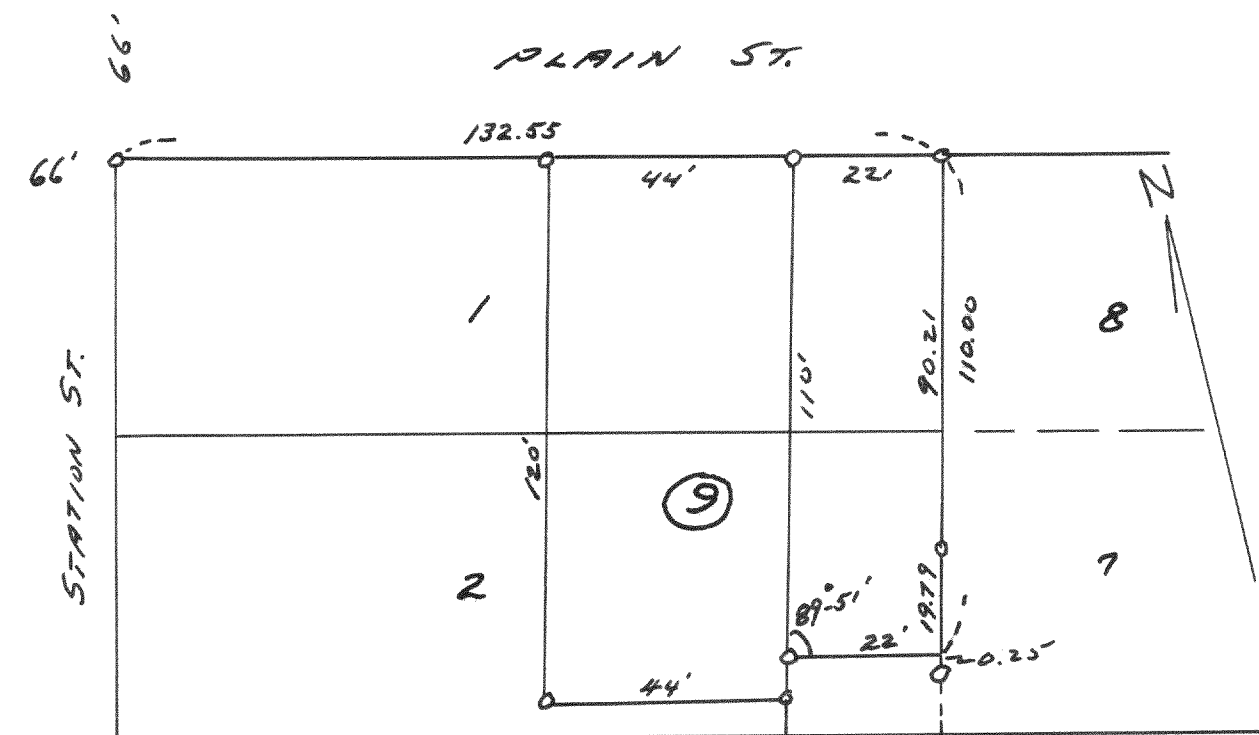

PLAT OF SURVEY OF PART OF LOTS 1 & 2 BLOCK 9
ORIGINAL PLAT VILLAGE OF SHARON
APRIL 1953

LLJ
CS


2823

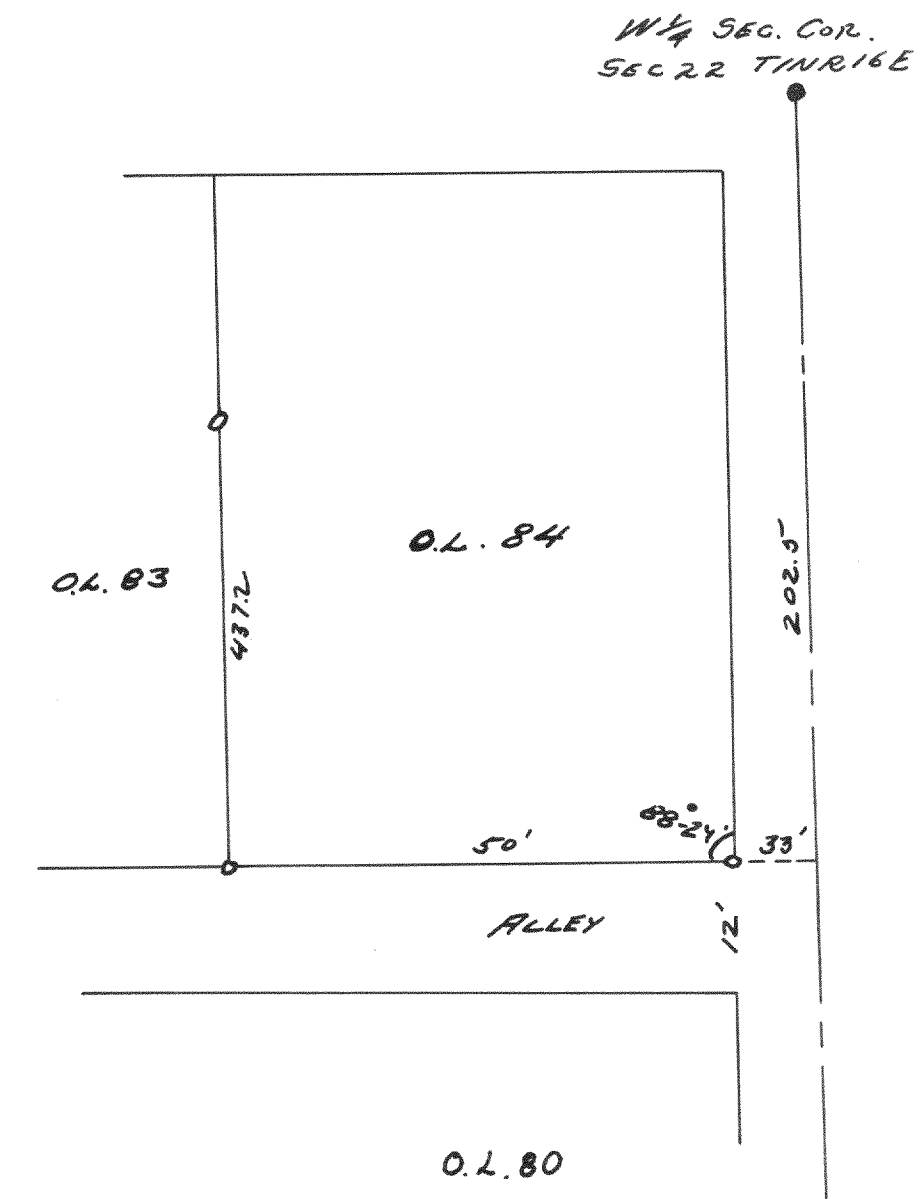

PLAT OF SURVEY OF PART
OF O.L. 84 ASSESSOR'S PLAT
VILLAGE OF WALWORTH
MAY 1953

LLJ
CS

2824

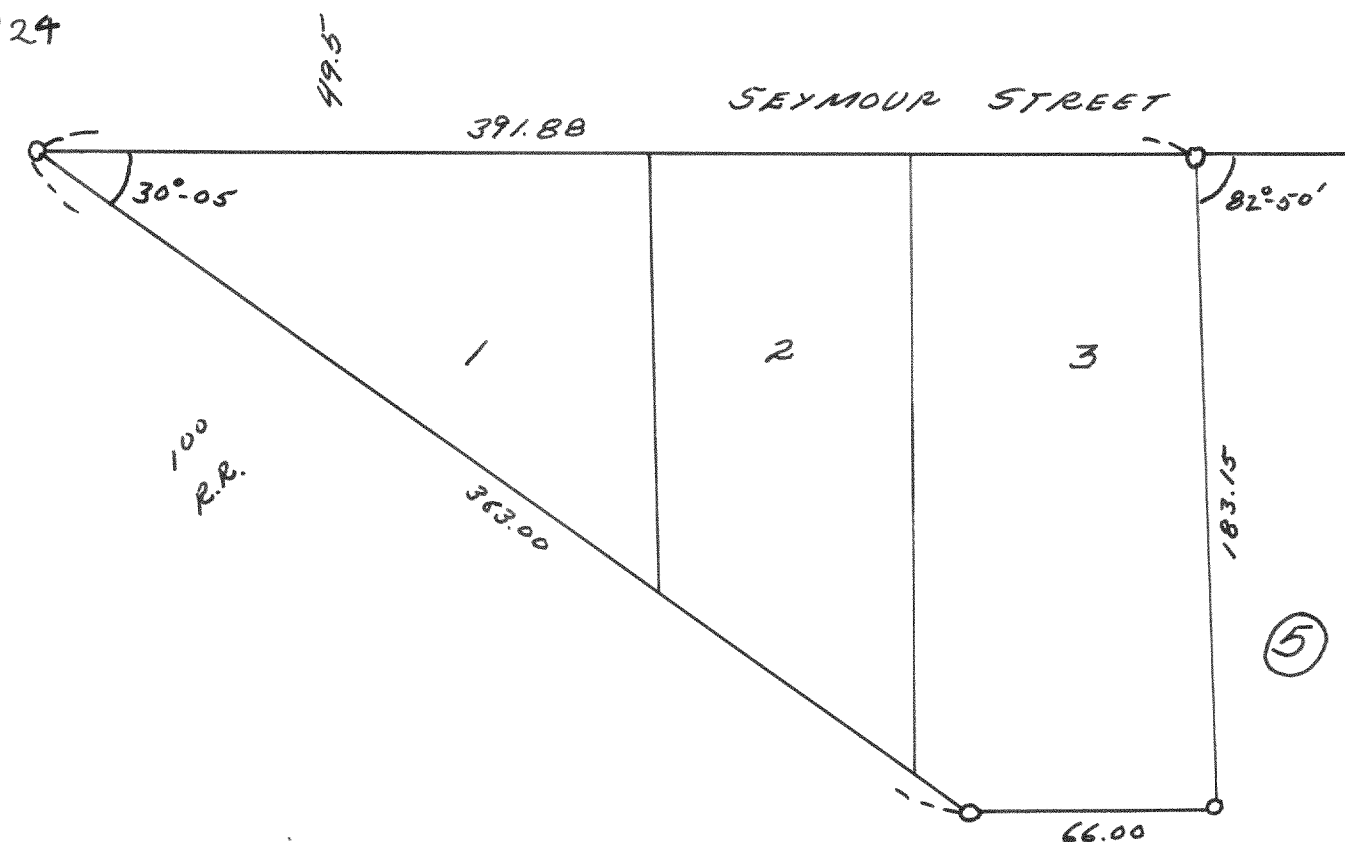

PLAT OF SURVEY OF LOTS 1-3 BLOCK 5
WISE & NELSON'S SOUTH SIDE ADD. TO VILLAGE
OF SHARON
DEC. 1953

LLJ
CS

2825

PLAT OF SURVEY OF PART OF LOT 2
BLOCK 4 BIRGES ADD. CITY OF WHITEWATER
JULY 1953

LLJ
CS

