



2826

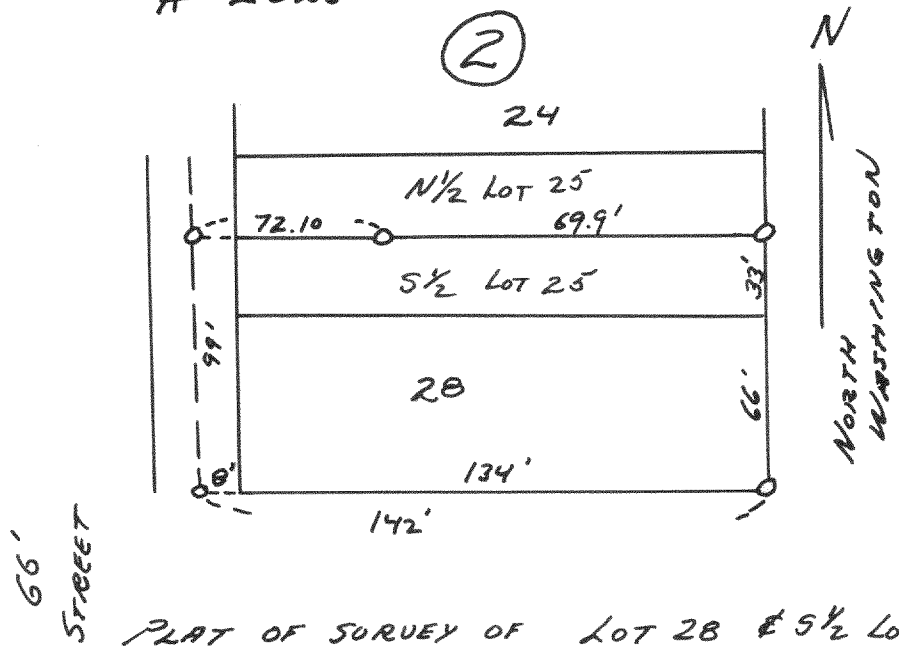


PLAT OF SURVEY OF LOT 28 & 5 1/2 LOT 25
BLK 2 HOLTON HEIGHTS ADD.
CITY OF ELKHORN
APRIL 1953
LLJ
CS

2827

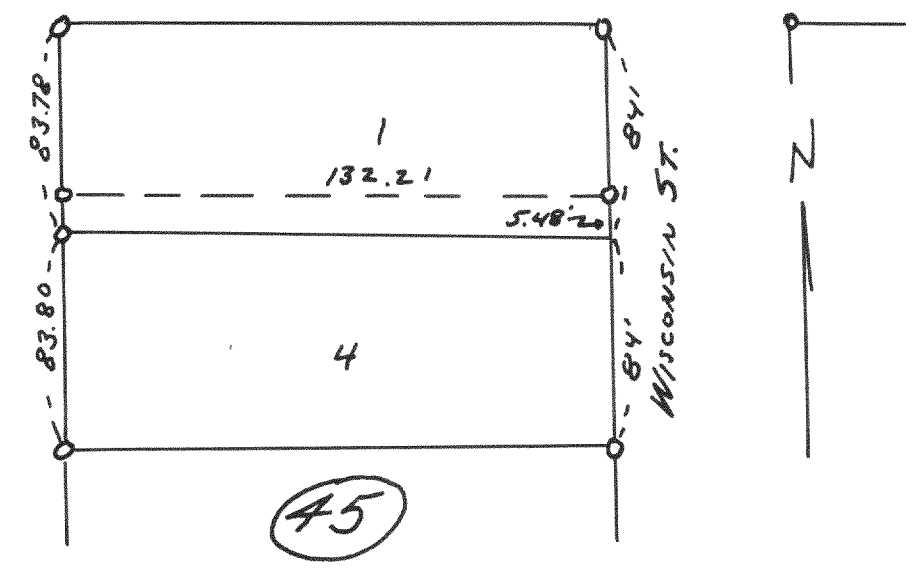


PLAT OF SURVEY OF LOTS 1 & 4
BLK. 45 DAVIS ADD. CITY
OF ELKHORN
SEPT. 1953
LLJ
CS

2828

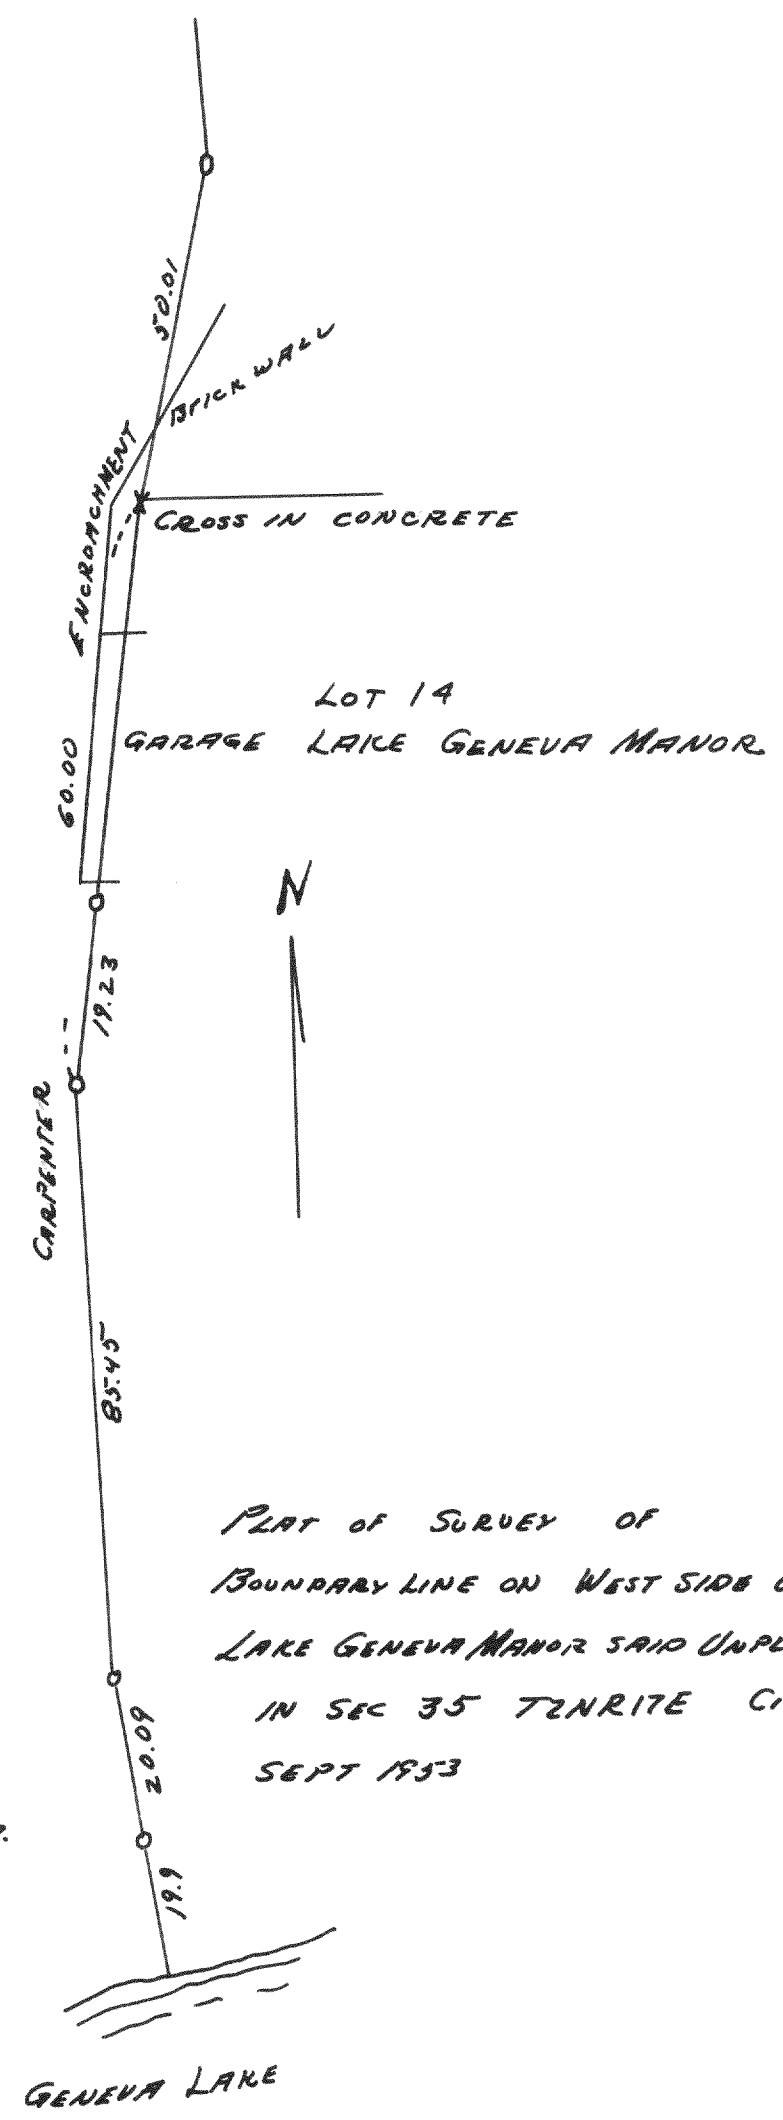


PLAT OF SURVEY OF
BOUNDARY LINE ON WEST SIDE OF
LAKE GENEVA MANOR SAID UNPLATTED LAND
IN SEC 35 T2N R17E CITY OF LAKE GENEVA
SEPT 1953
LLJ
CS

2829

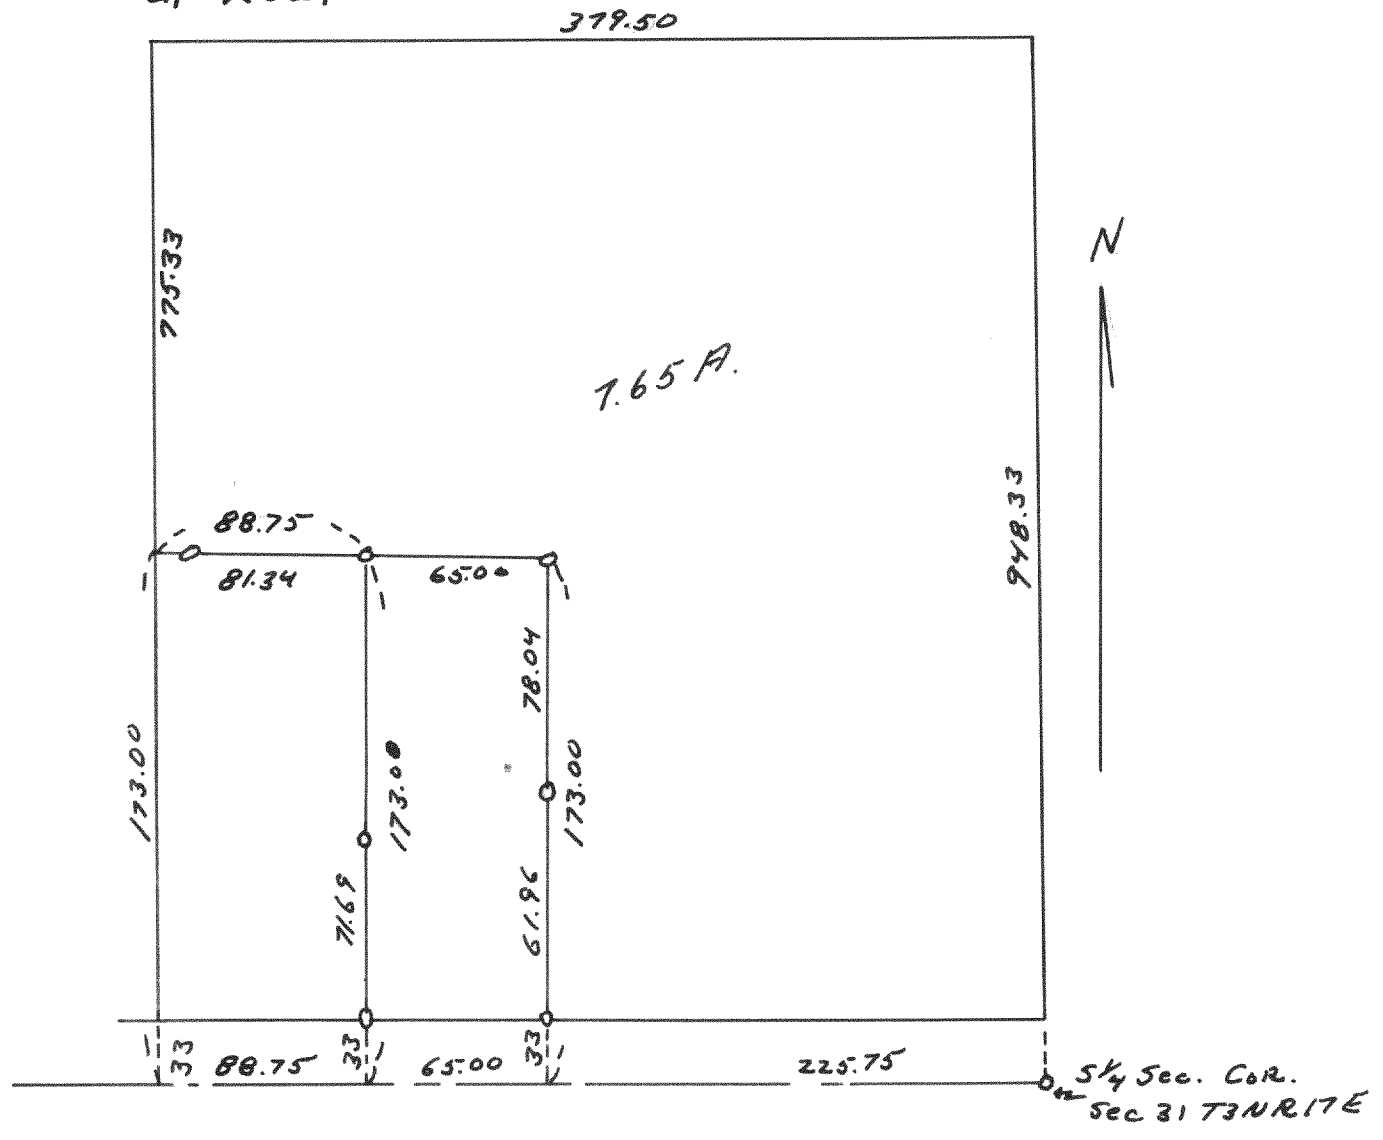

PLAT OF SURVEY OF LAND IN SW 1/4 OF SEC. 31
T3N R17E CITY OF ELKHORN JULY 1953
LLJ
CS

2830

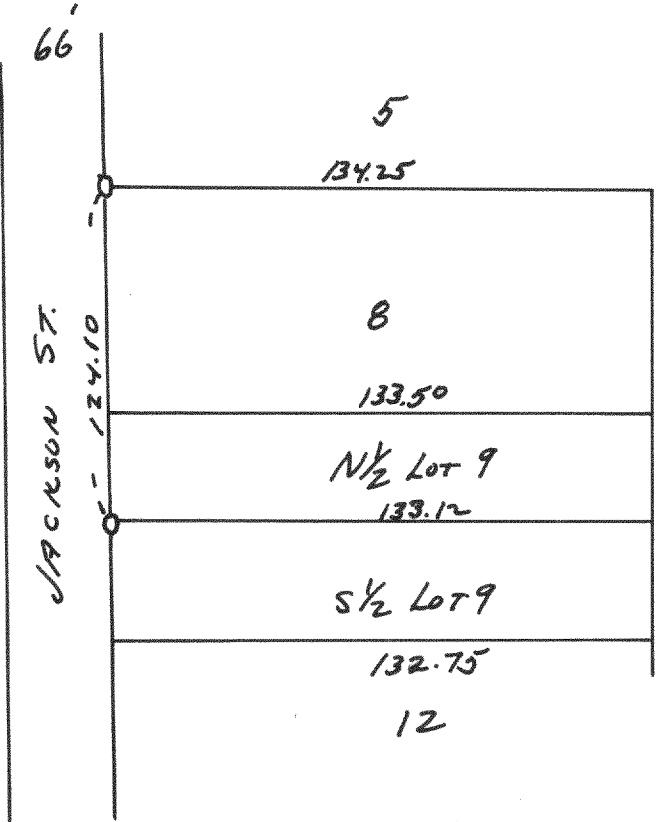

LOT 8, 1/2 LOT 9 BLK 3 ELDERKIN ADD.
CITY OF ELKHORN
APRIL 1953
LLJ
CS