


#4302

PLAT OF SURVEY OF
LOT 31 OF LYNNDALE SUBDIVISION
LOCATED IN THE NW 1/4 SEC 20, T4N,
R18E, VILLAGE OF EAST TROY
WAL. CO. WIS.

SEPT. 1964

Lloyd L. Jensen
CO. SURVEYOR

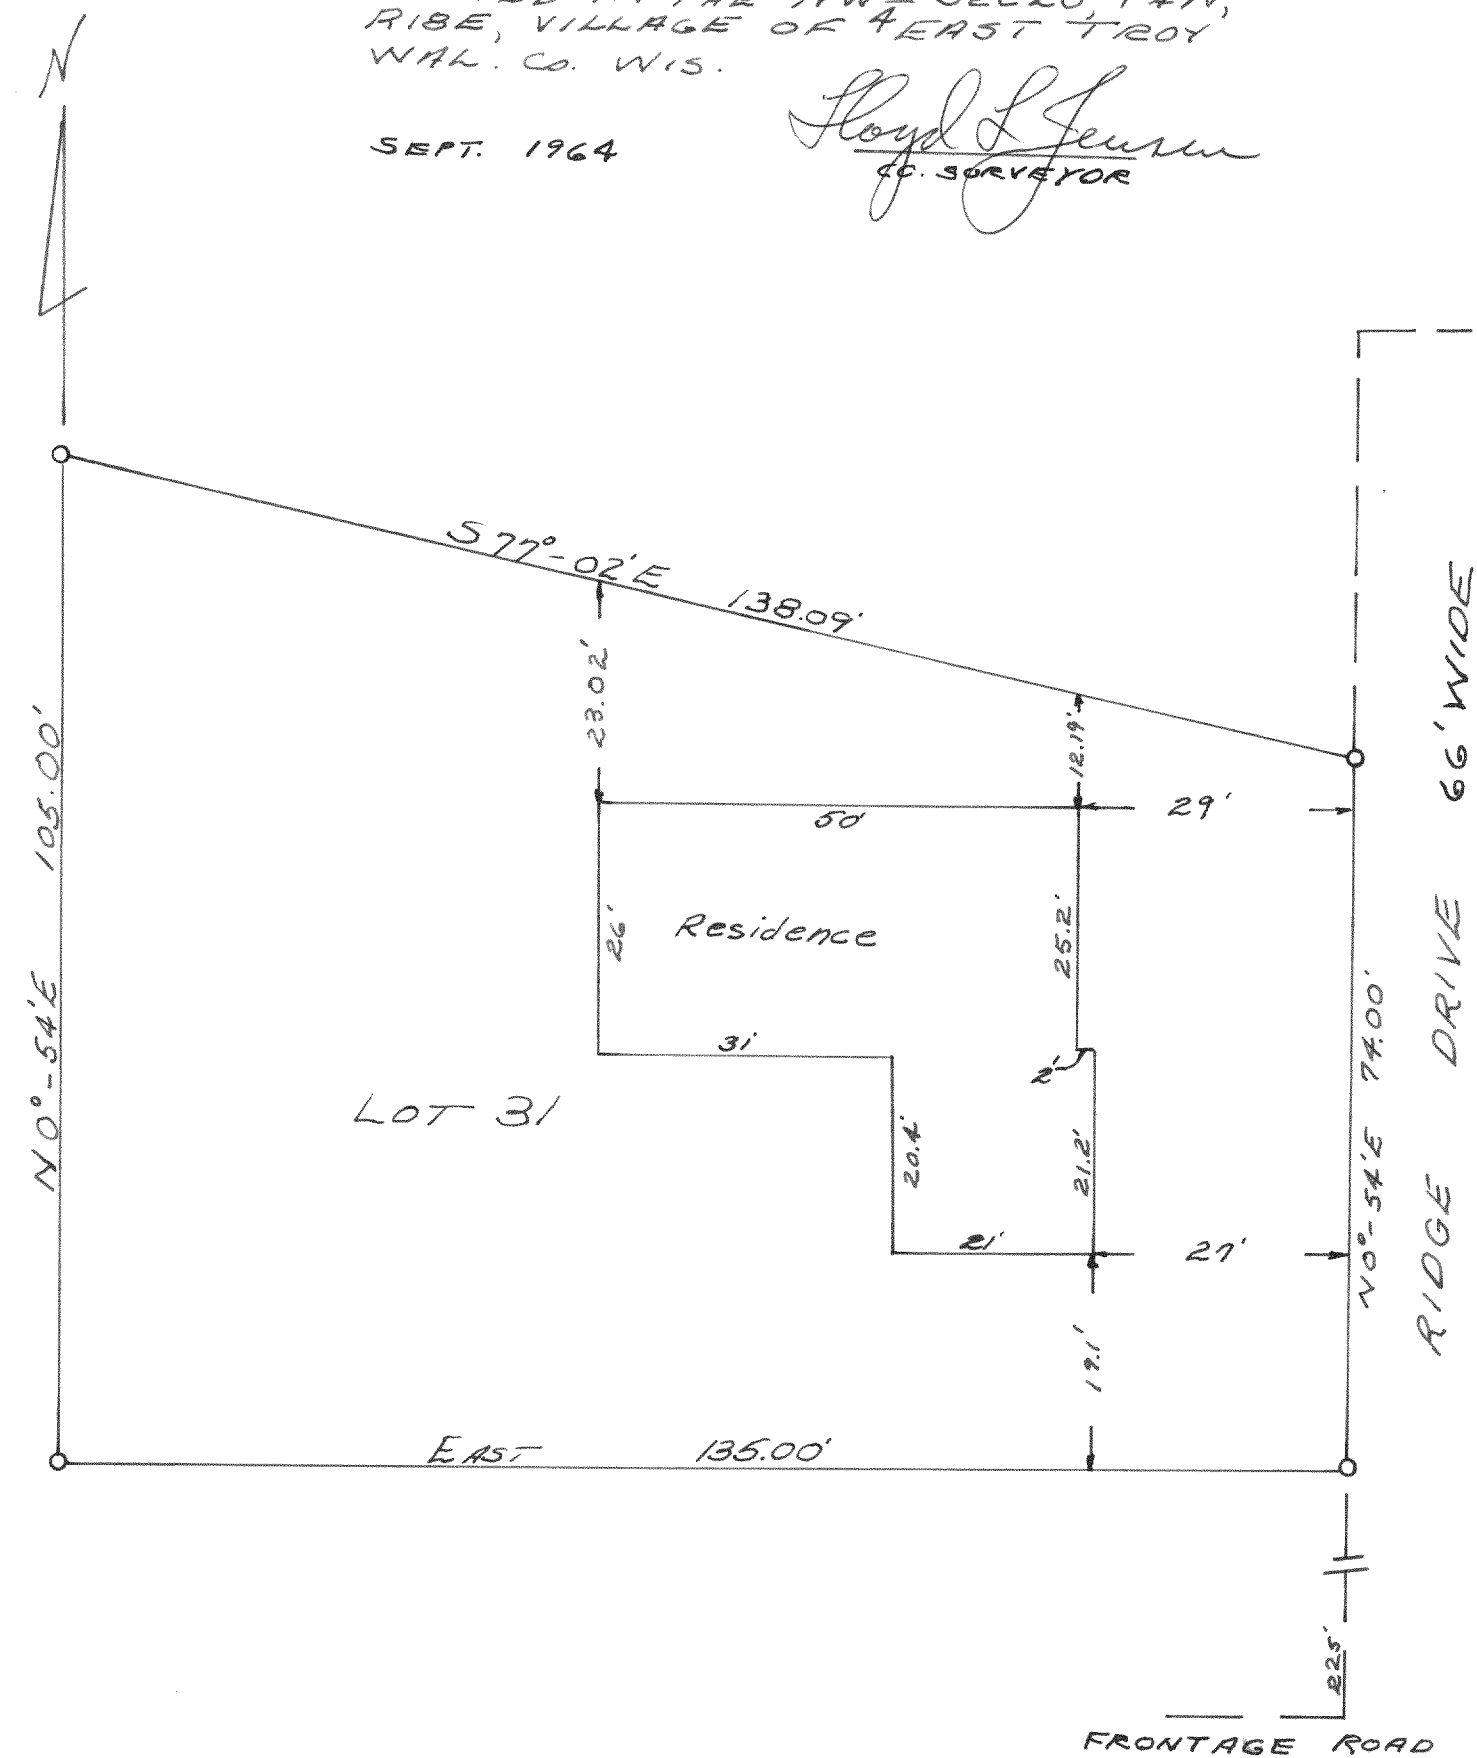

#4303

PLAT OF SURVEY OF
LOT LOCATED IN NE 1/4 OF SECTION
9 - T4N, R18E, WALWORTH
COUNTY, WISCONSIN.

OCT. 12, 1964

Lloyd L. Jensen
CO. SURVEYOR

