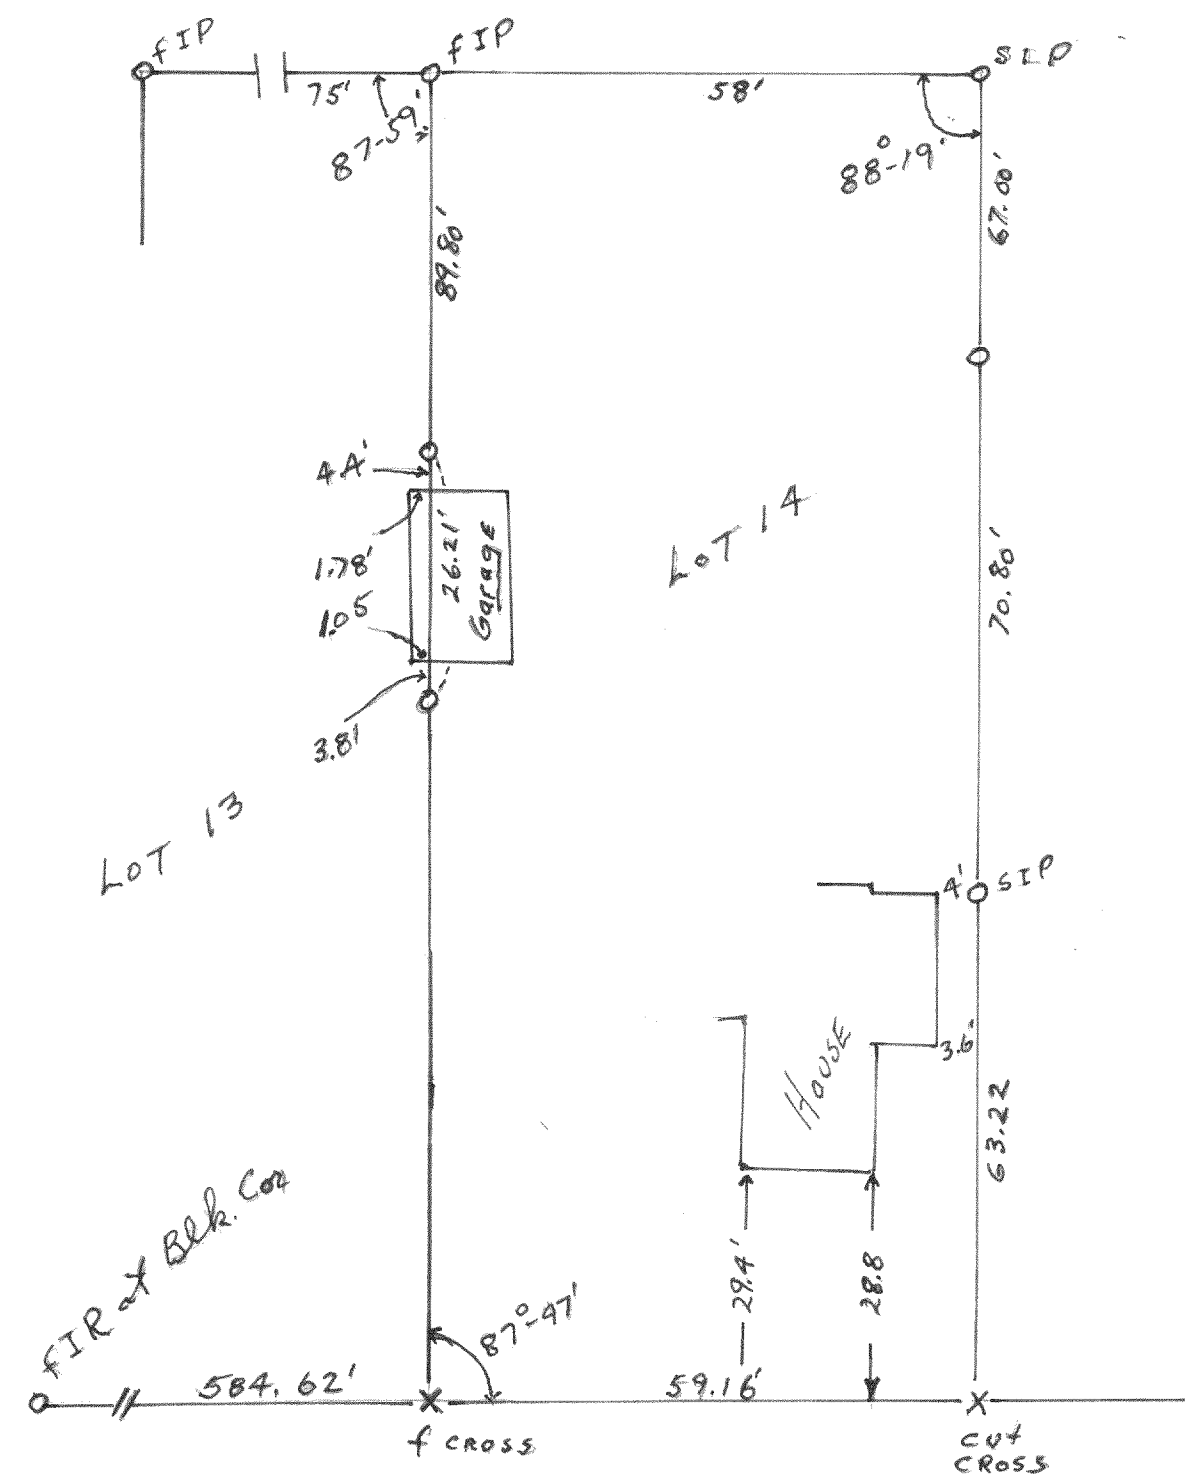


4321


SEYMOUR ST.

Plat of SURVEY of Lot 14 BLOCK 4
of CITIZENS ADDITION TO VILLAGE
OF SHARON.

Sept. 1962

Lloyd Jensen
COUNTY SURVEYOR

4322

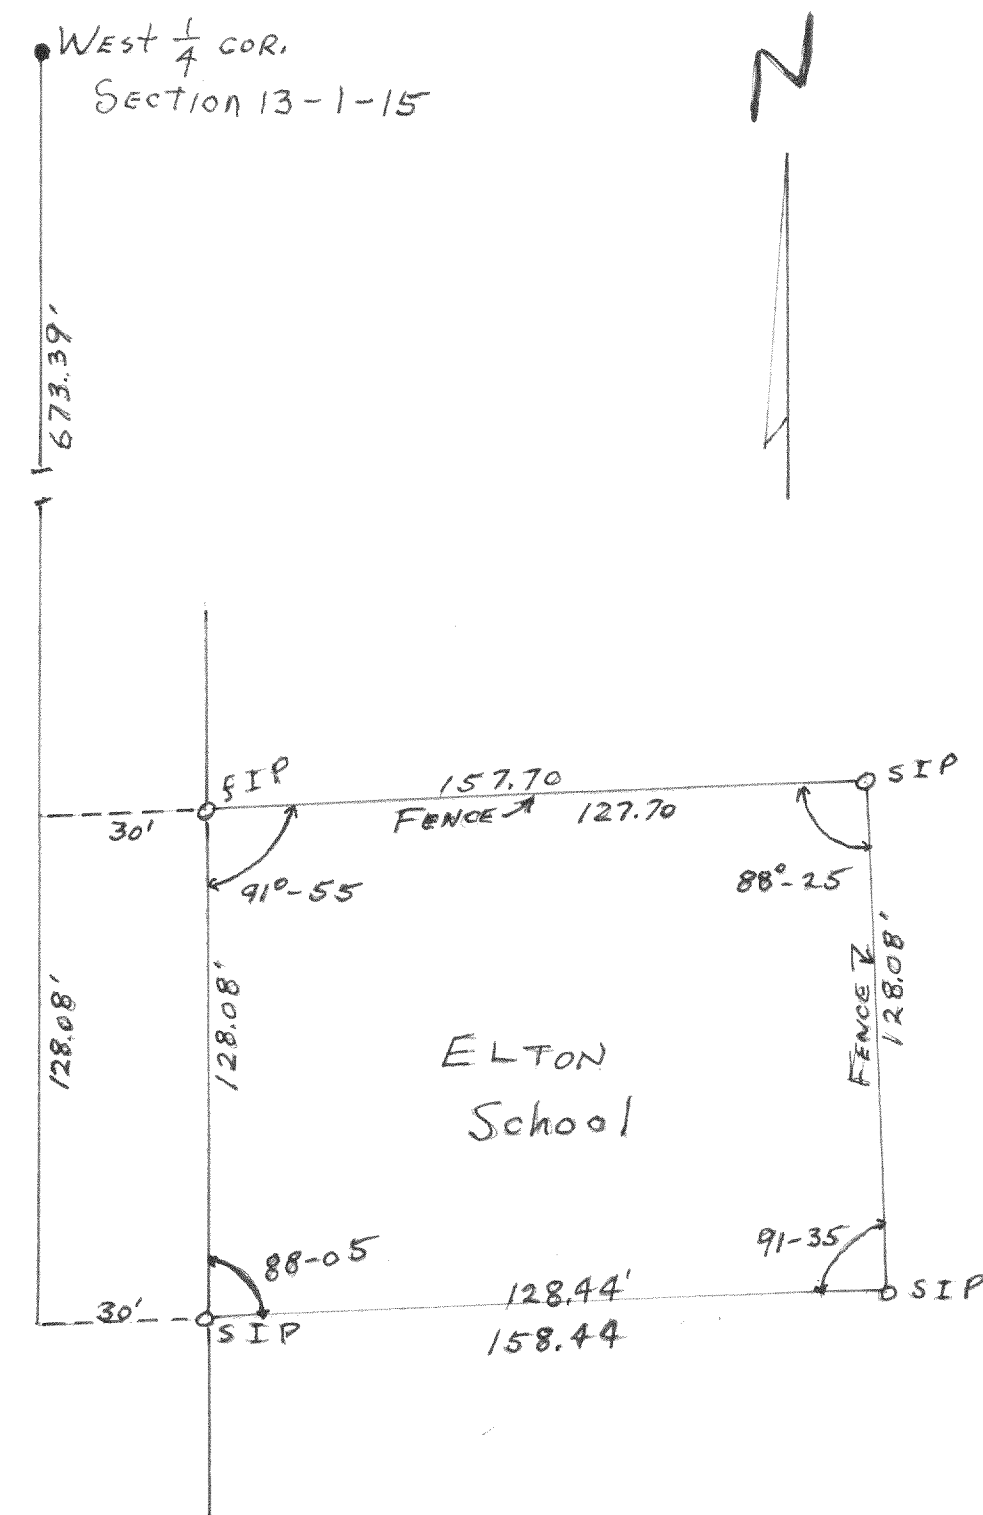

Plat of SURVEY of land owned
by Elton School in the NE $\frac{1}{4}$
of Section 13, T1N R1E

Oct. 8, 1964 Lloyd Jensen
COUNTY SURVEYOR