



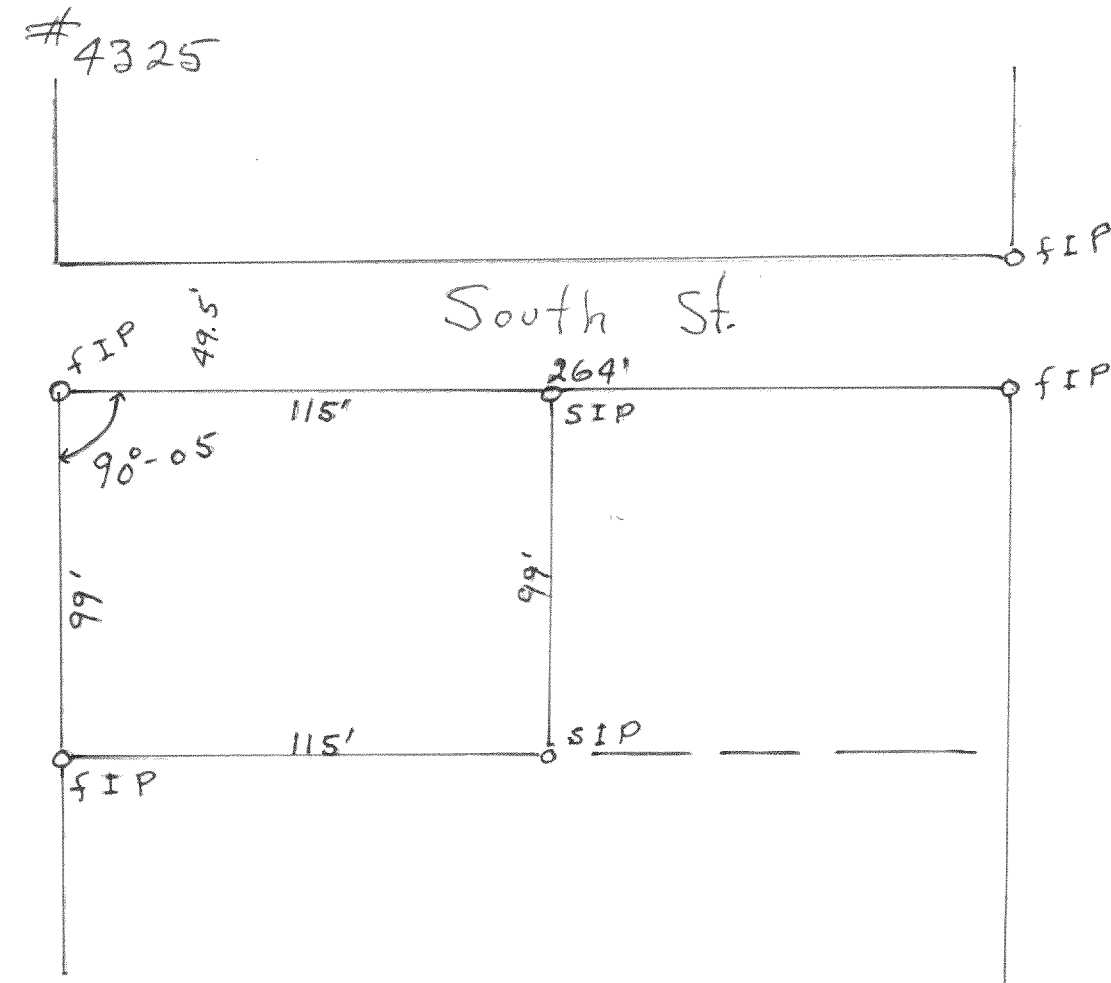

Plat of SURVEY of part of Lot 1
 B1K 18 of original plat of
 East TROY
 July 2, 1957
 Lloyd Jensen
 County Surveyor

#4326

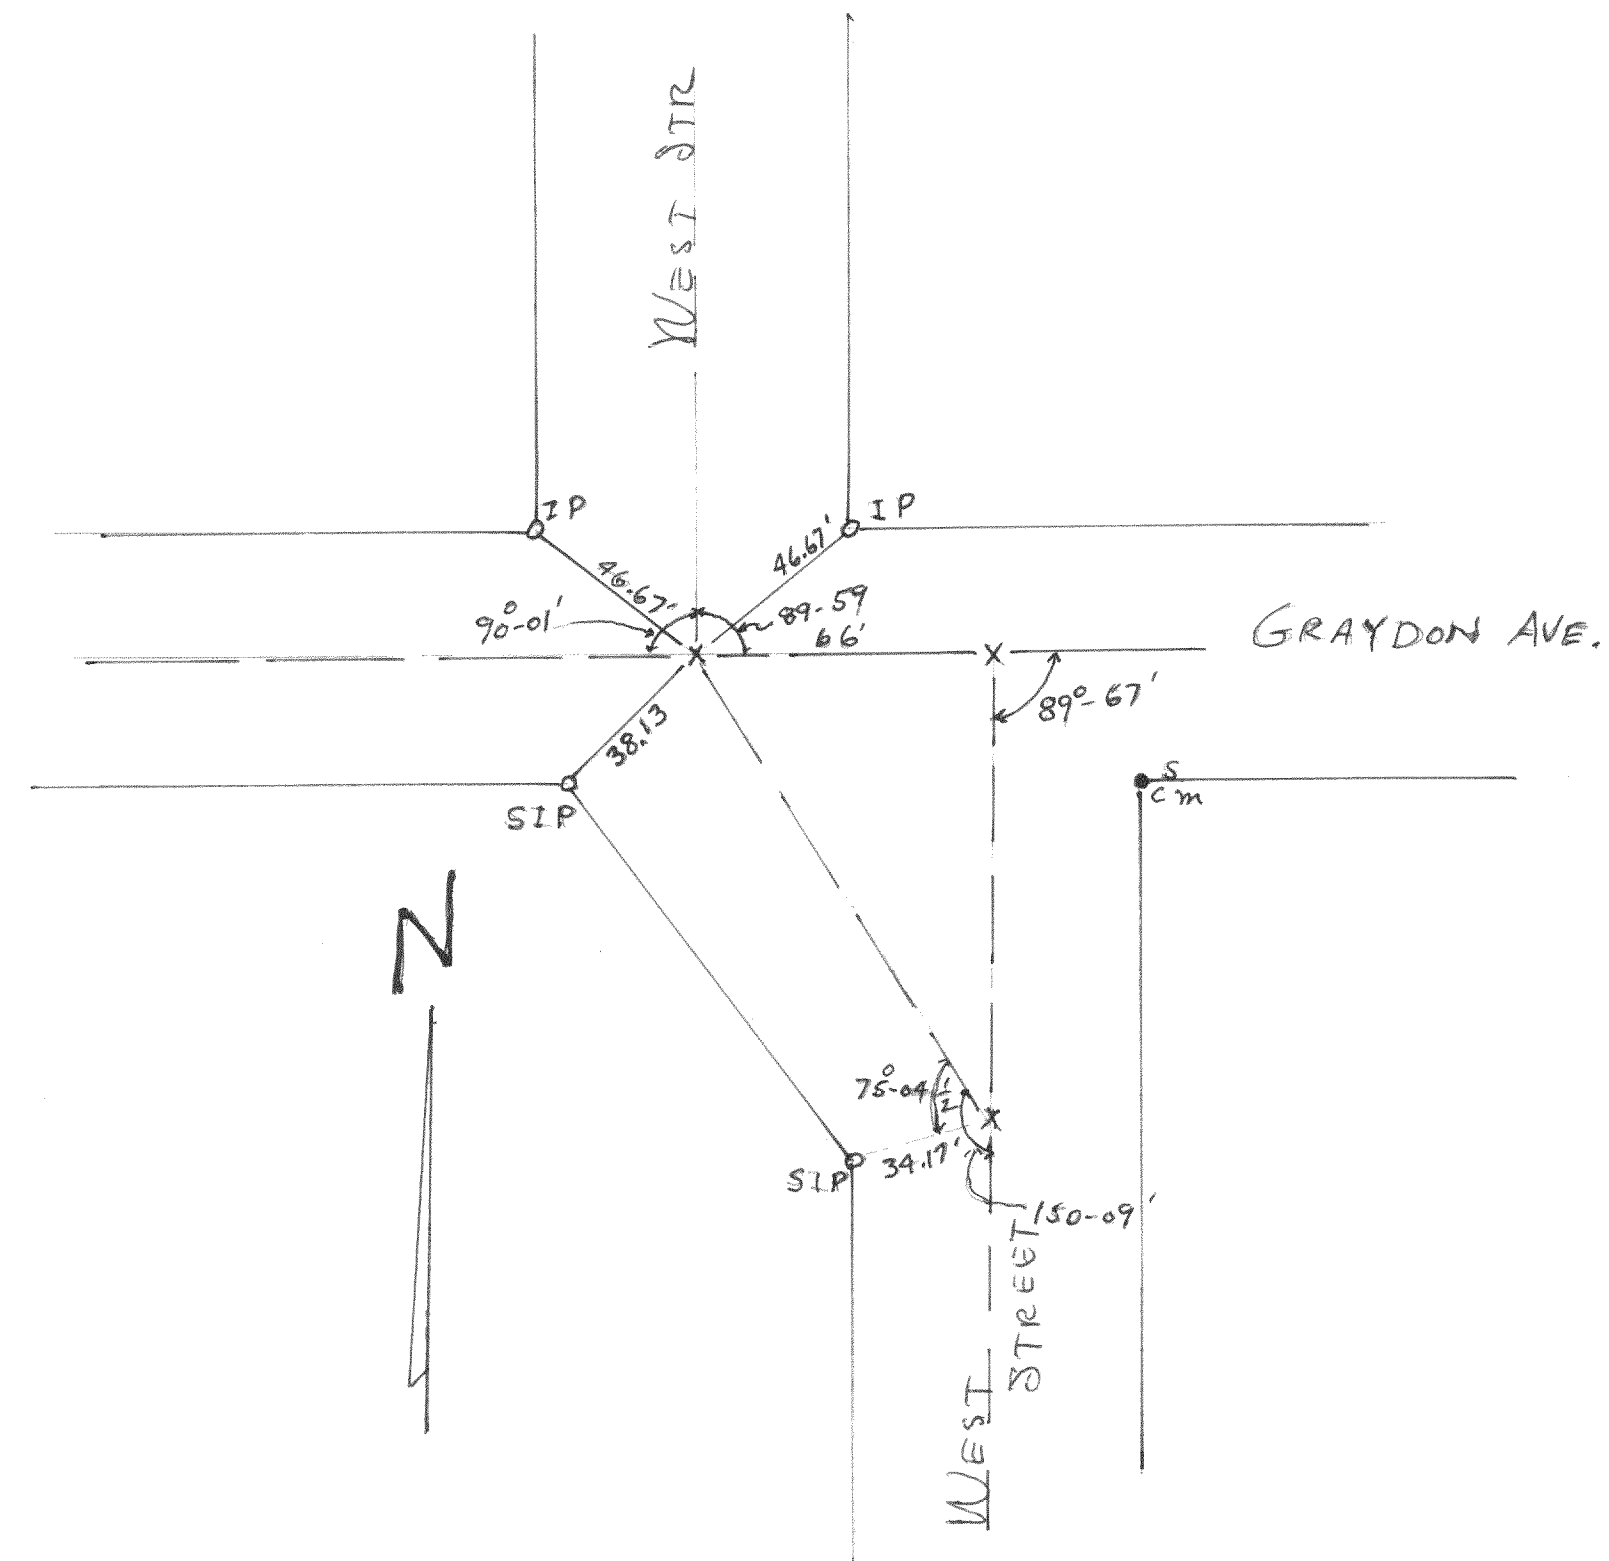

Plat of survey of the intersection
 of Graydon Ave. and West St.
 in the Village of East Troy, Wis

July 1962

Lloyd Jensen
 County Surveyor