



#4329

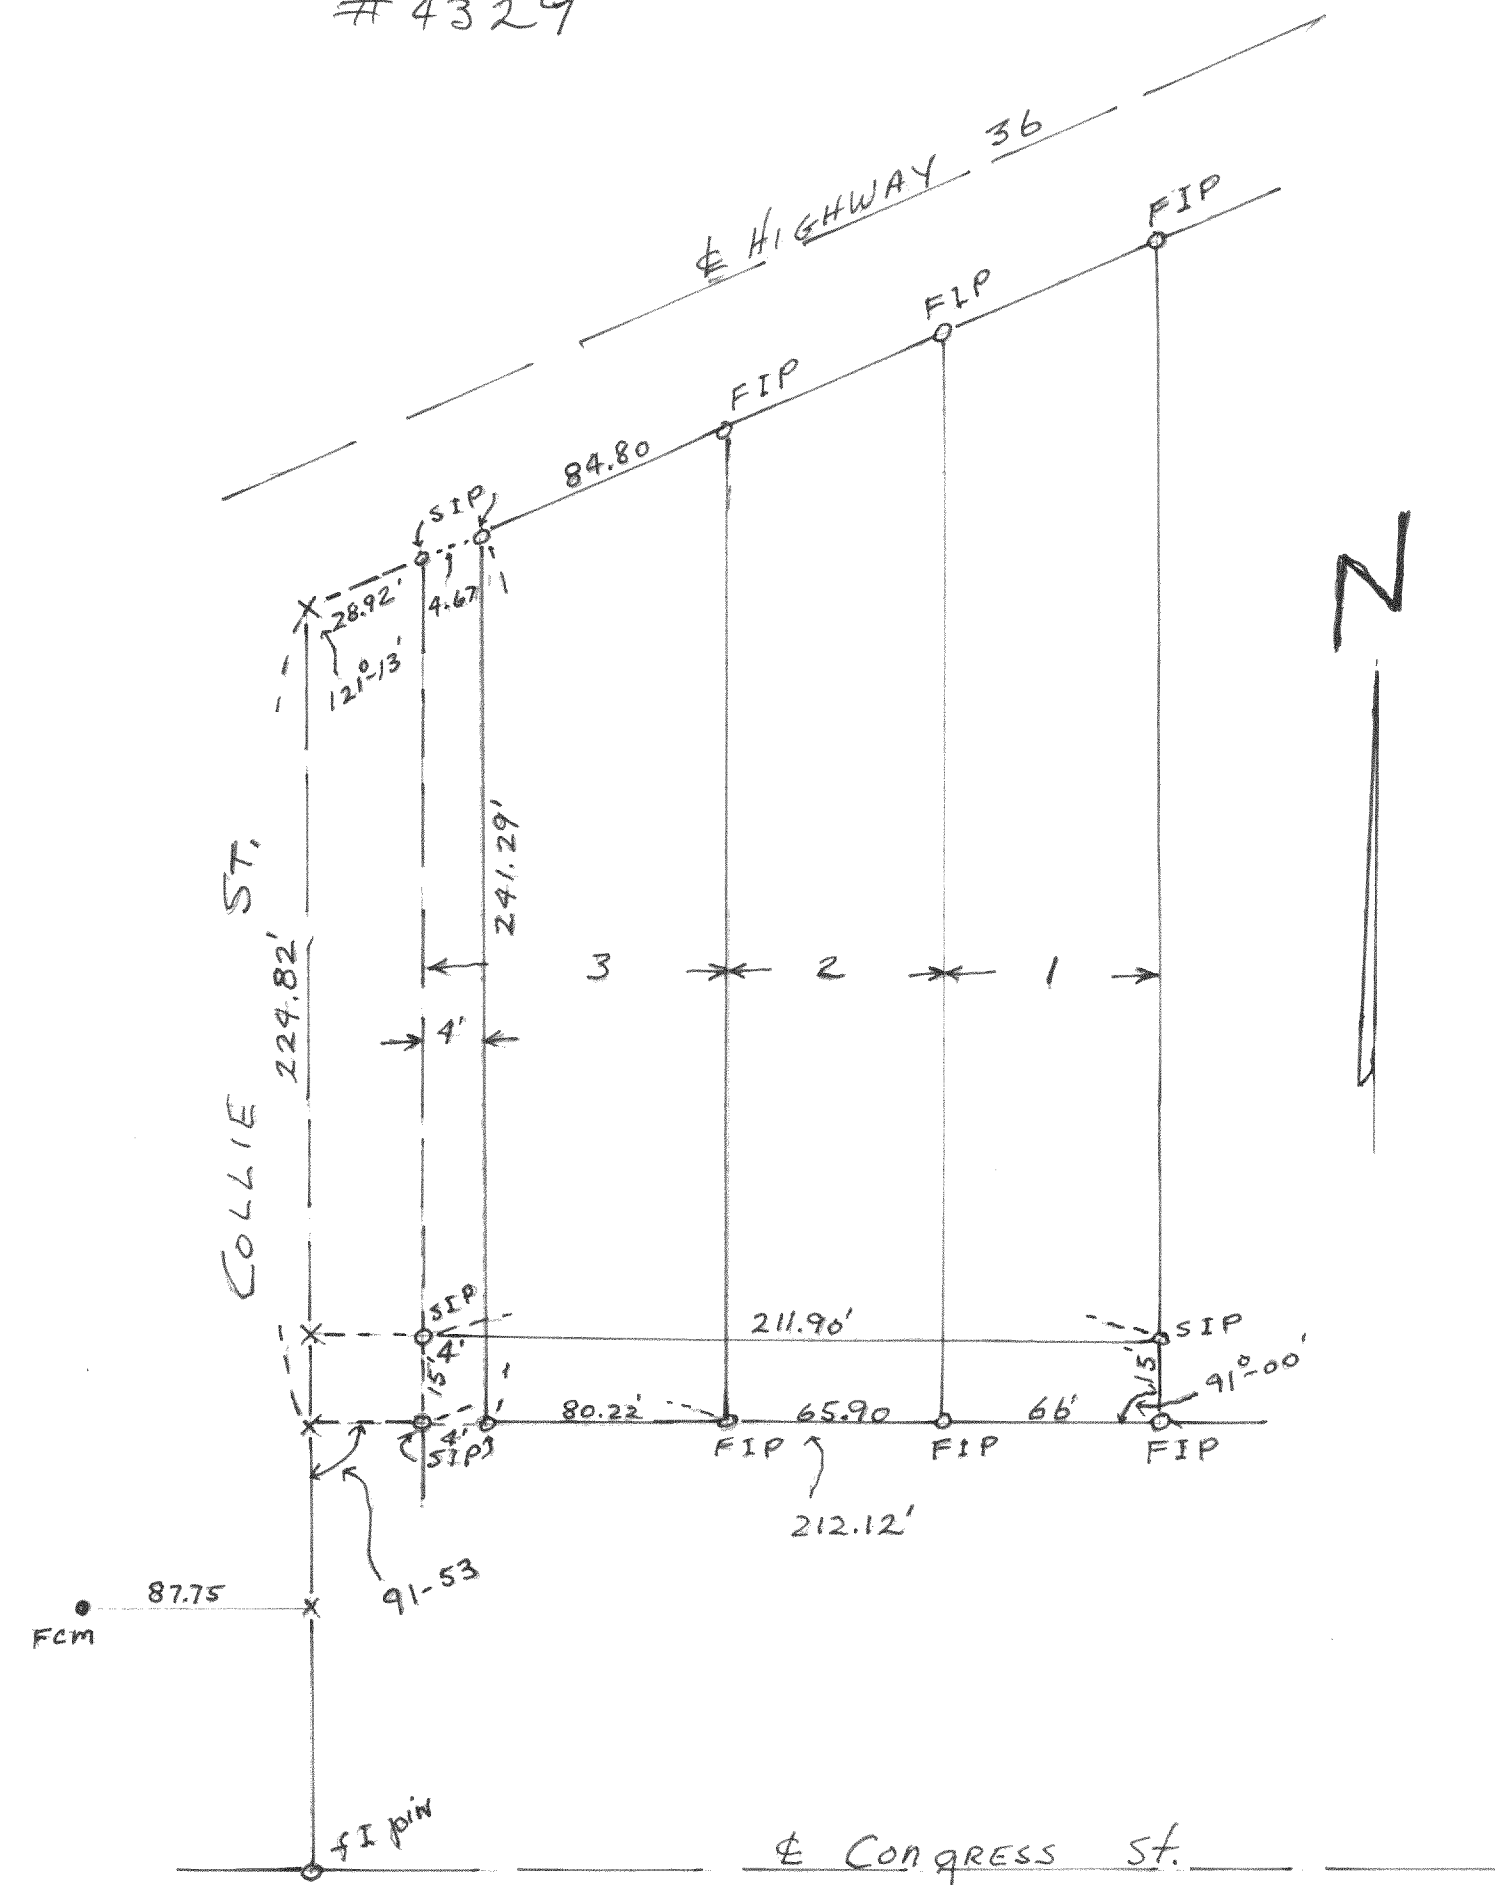

SURVEY to MARK the South 15 feet of
lots 1, 2 & 3 of Dodge Subd. in Wms Bay
Wis. for a STORM SEWER EASEMENT.
DEC. 1964
Floyd Jensen
COUNTY SURVEYOR

#4330

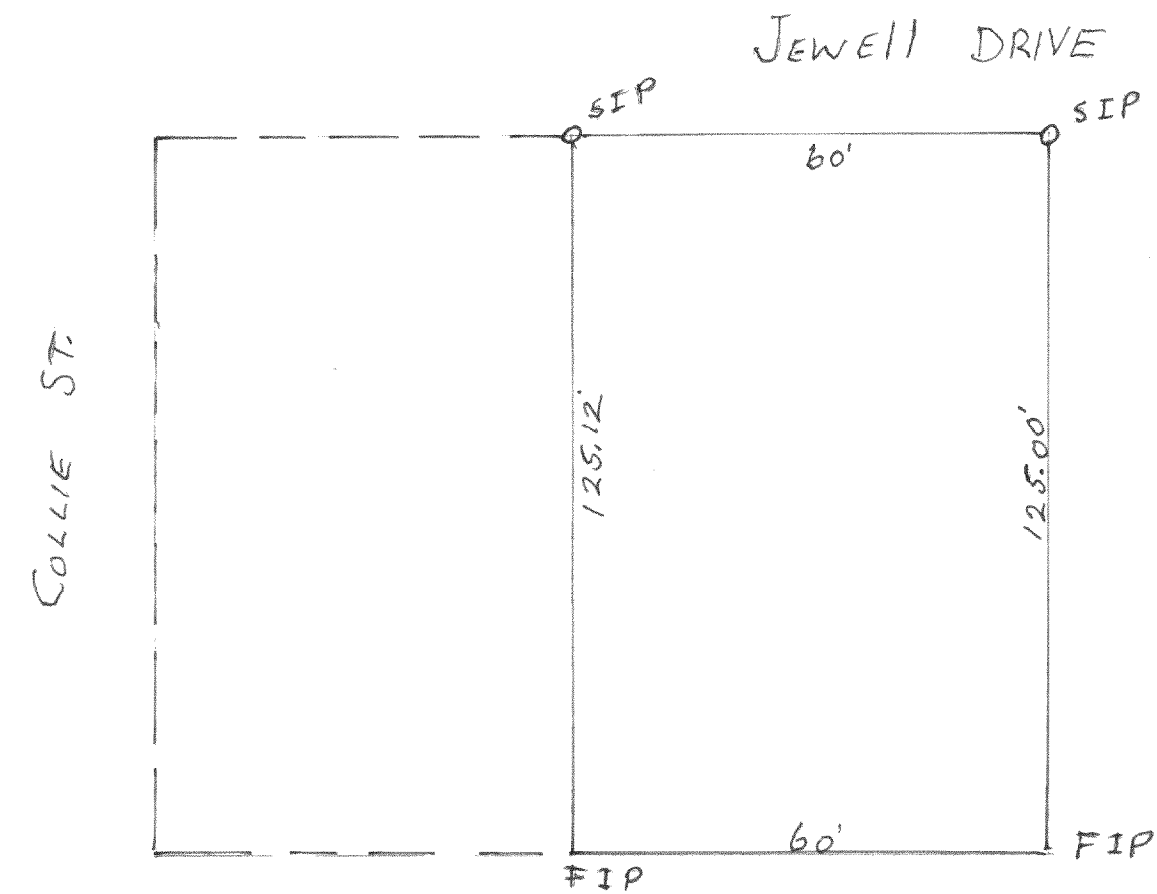

Plat of SURVEY of Lot 15 of
Lackey Brothers Subd in the
Village of Wms Bay Wis.
JAN. 15, 1965

Floyd Jensen
COUNTY SURVEYOR