


518

#4340

PLAT OF SURVEY
OF

LAND IN NE $\frac{1}{4}$ SEC. 15 T14N R17E
WAL. CO. WIS.
May 1965


Lloyd L. Jensen
LLOYD L. JENSEN
CO. SURVEYOR

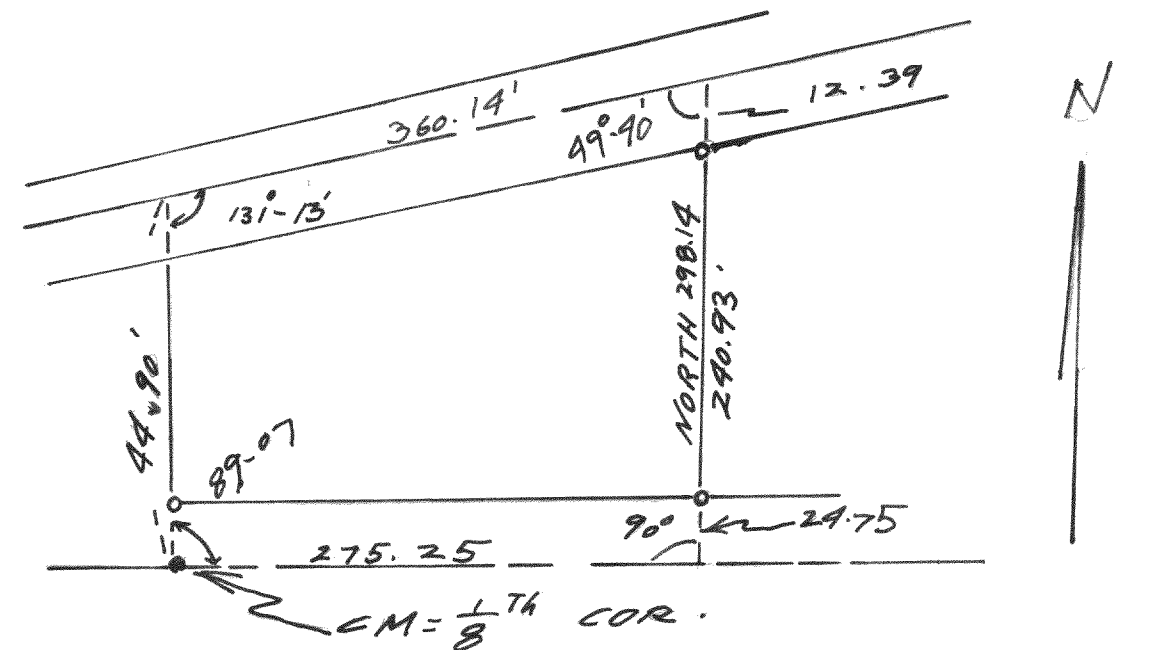

#4341

SURVEY OF PART OF BLOCK
ONE OF ORIGINAL PLAT OF
THE VILLAGE OF EAST TROY
WISCONSIN.
JUNE 1965

Lloyd L. Jensen
LLOYD L. JENSEN
COUNTY SURVEYOR

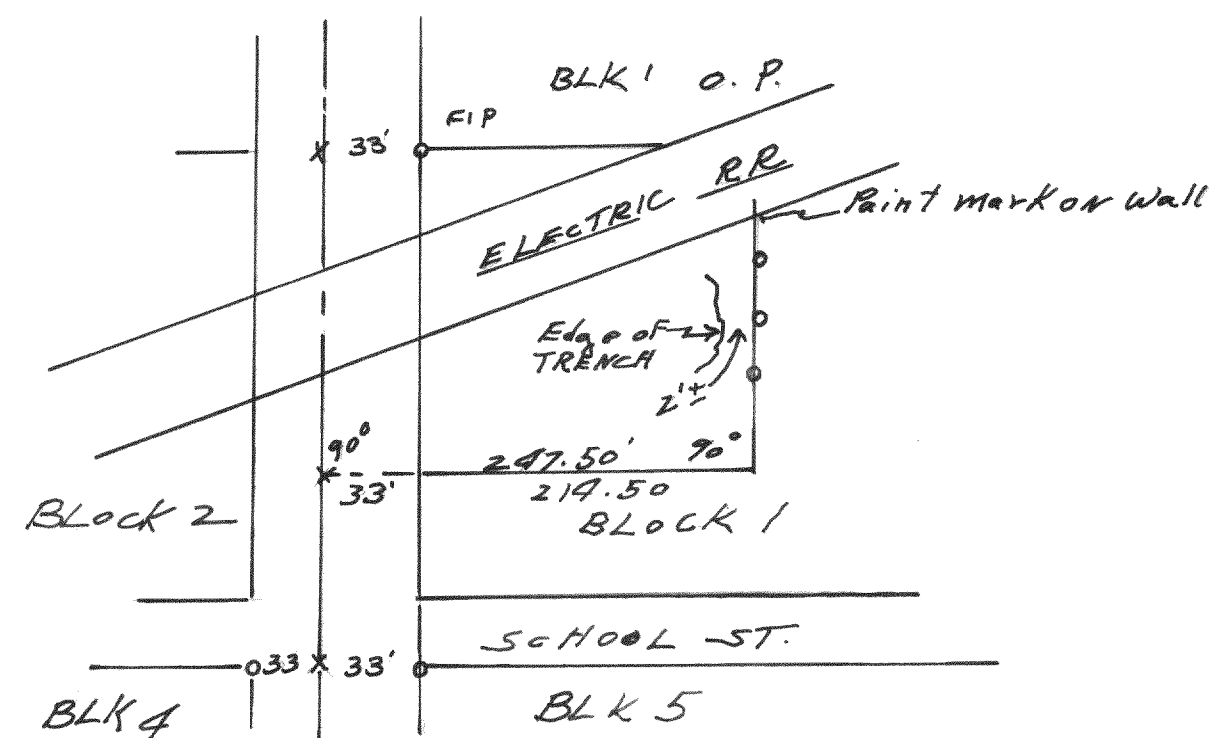

#4342

PLAT OF SURVEY
OF

LAND IN THE NW $\frac{1}{4}$ OF SECTION 30
T4N R18E - VILLAGE OF EAST TROY
WAL. CO. WIS.
Jan 15, 1966

Lloyd L. Jensen
LLOYD L. JENSEN
CO. SURVEYOR

