


43 43

PLAT OF SURVEY OF LOT 20+23
LOCKWOOD SUBD. WILLIAMS BAY, WIS.
OCT. 1965

Lloyd Jensen
CO. SURVEYOR

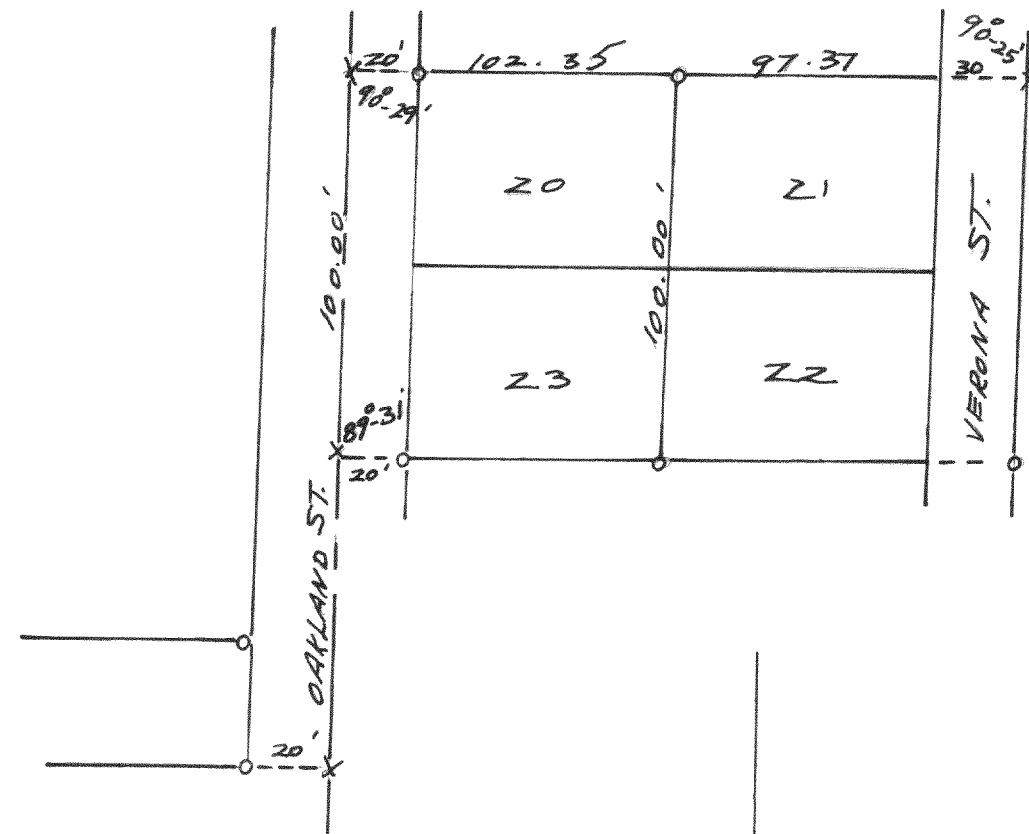

4344

519

SURVEY - PROPOSED SOUTH STREET
FROM WILLOW SHORES TO EBERTS SUBD.
VILLAGE OF EAST TROY

JAN. 1965

Floyd S. Jensen
Co. SURVEYOR

