


520
#4345

PLAT OF SURVEY OF LOT 210
3rd ADD. TO CEDAR POINT PARK
WILLIAMS BAY, WIS.
AUG 1965


Lloyd L. Jensen
LLOYD L. JENSEN
CO. SURVEYOR

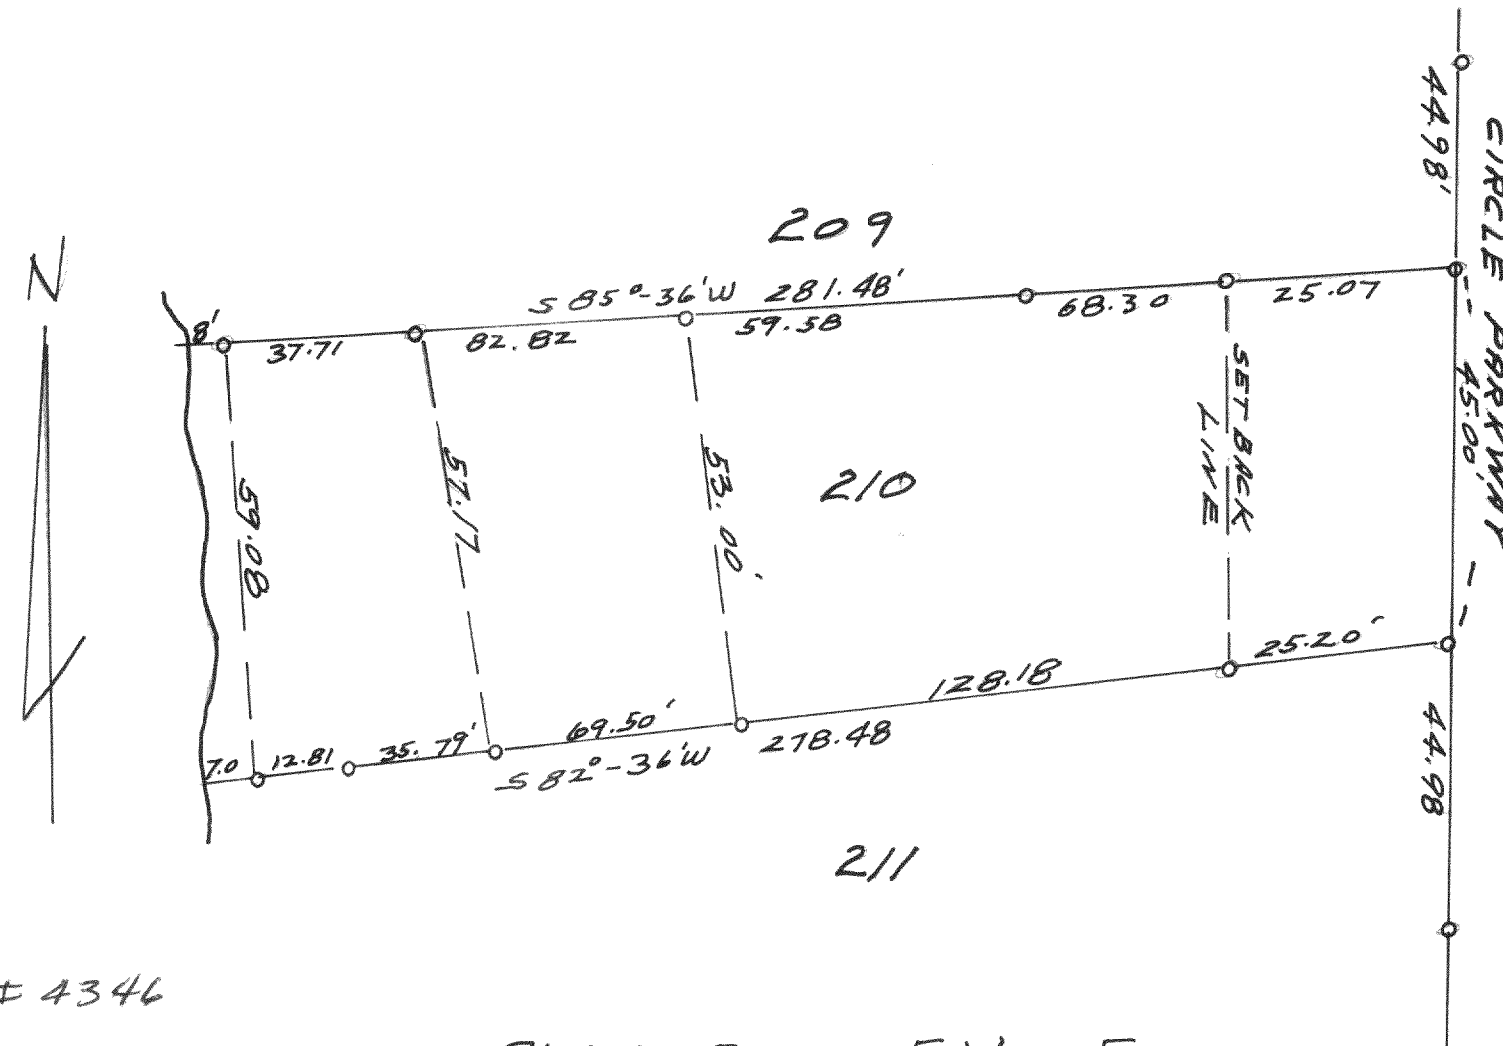

#4346

PLAT OF SURVEY OF
PART OF BLK 3 ORIGINAL PLAT OF
WILLIAMS BAY, WAL. CO. WIS.
OCT 1965


Lloyd L. Jensen
CO. SURVEYOR

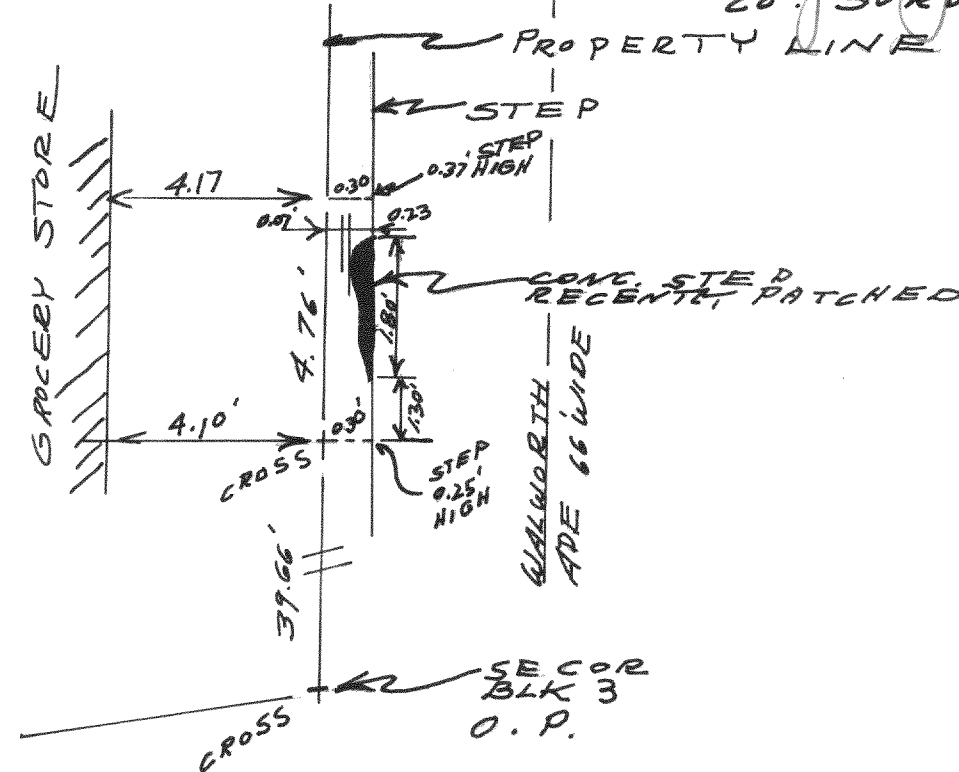

4347

PLAT OF SURVEY OF THE W. 92.00' OF LOT 3 AND THE
NORTH 63.00' AND THE WEST 92.00' OF LOT 4, BLK 1,
ORIGINAL PLAT OF THE VILLAGE WILLIAMS BAY
WAL. COUNTY, WIS.
AUG 1965

Lloyd L. Jensen
LLOYD L. JENSEN
CO. SURVEYOR

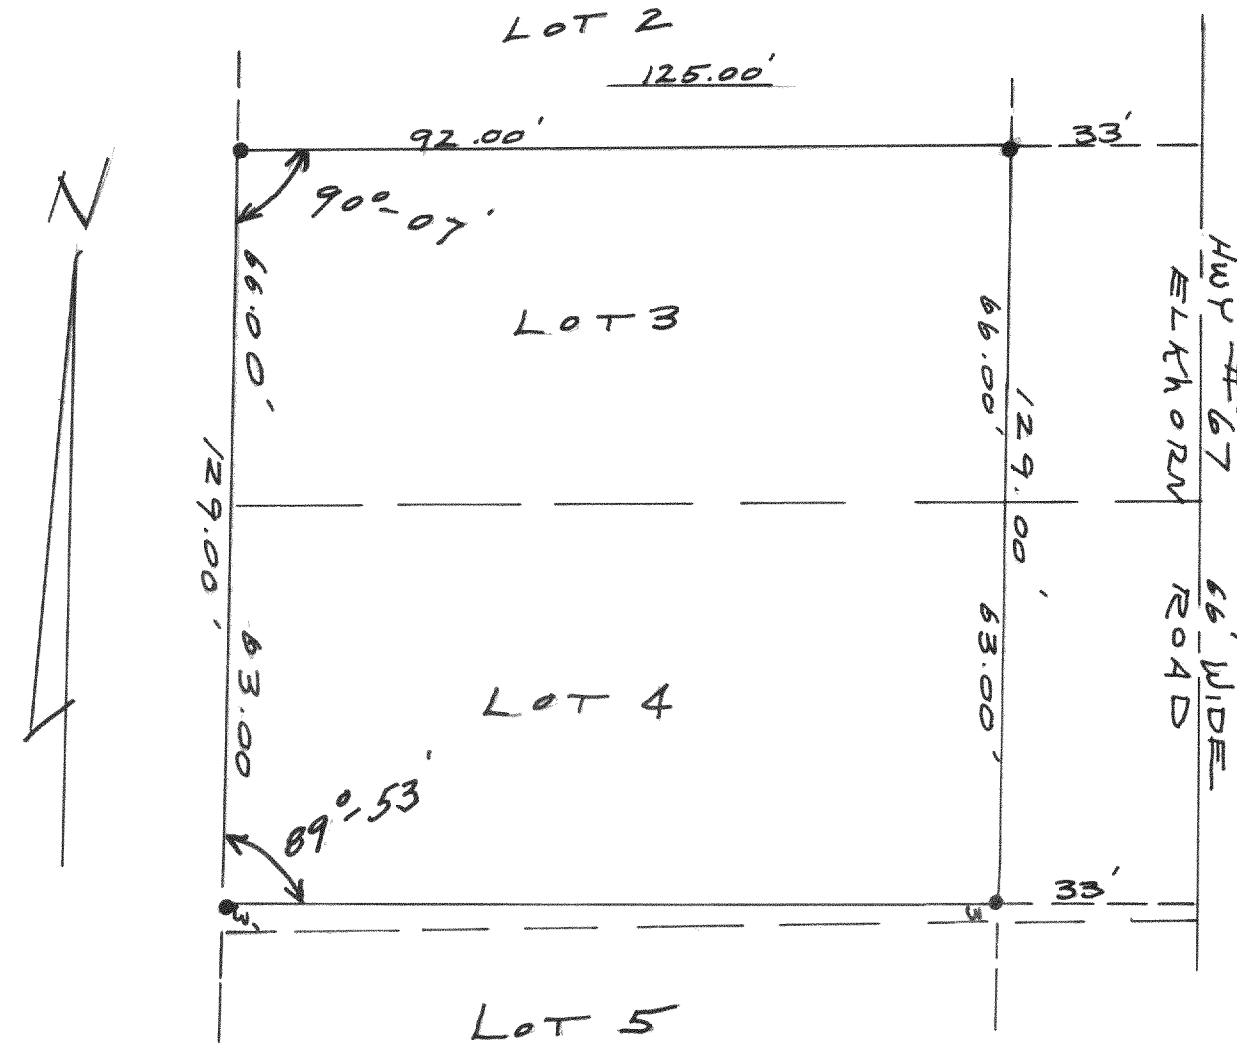

#4348

PLAT OF SURVEY OF LOT 2, E. 120' OF LOT 3,
OBSERVATORY SUBD. SEC 1, T1N R16E
WILLIAMS BAY, WAL. CO. WIS.
JAN. 1966

Lloyd L. Jensen
LLOYD L. JENSEN
CO. SURVEYOR

