


#4358

PLAT OF SURVEY OF

$N\frac{1}{2}$ LOTS 11 AND 12, THE EAST 20' OF
LOT 10, $W\frac{1}{2}$ - $S\frac{1}{2}$ LOT 11, WEST 7' $E\frac{1}{2}$ - $S\frac{1}{2}$
LOT 11 - ALL IN BLK 12 O.P. CITY OF
LAKE GENEVA, WAL. CO. WIS.

JULY 1965

Lloyd L. Jensen
CO. SURVEYOR

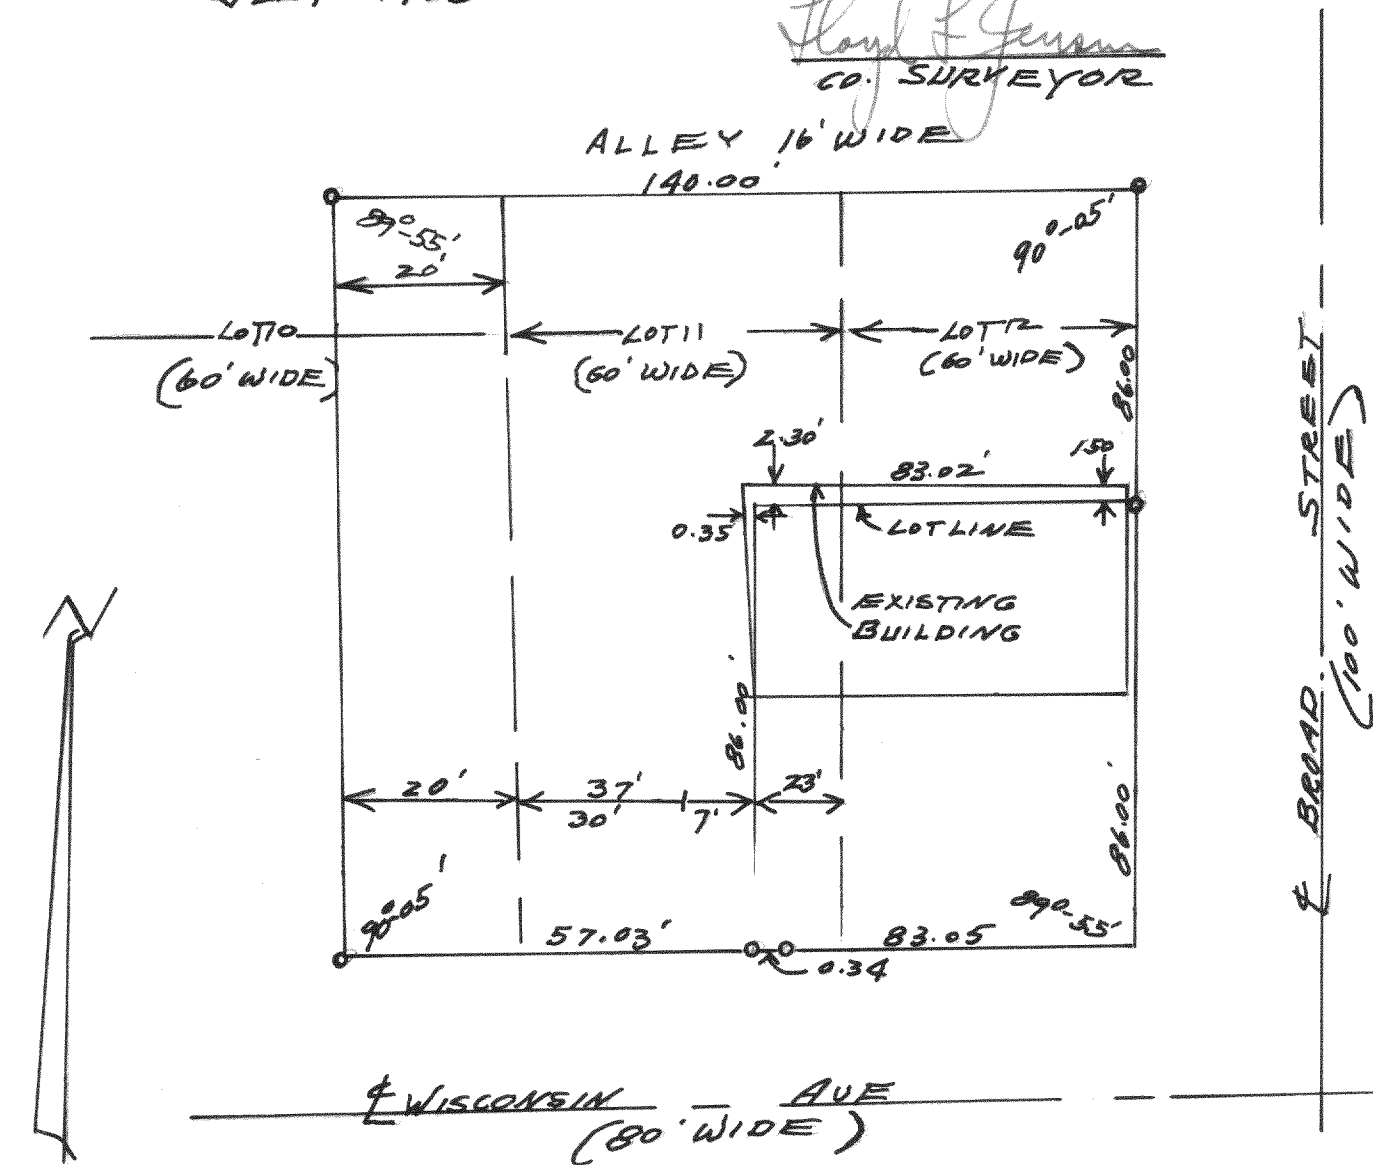


#4359

PLAT OF SURVEY OF

LOT 23 SUMMER HAVEN, Village
OF Williams Bay, Wal. Co. Wis.

May 1965

Lloyd L. Jensen
CO. SURVEYOR

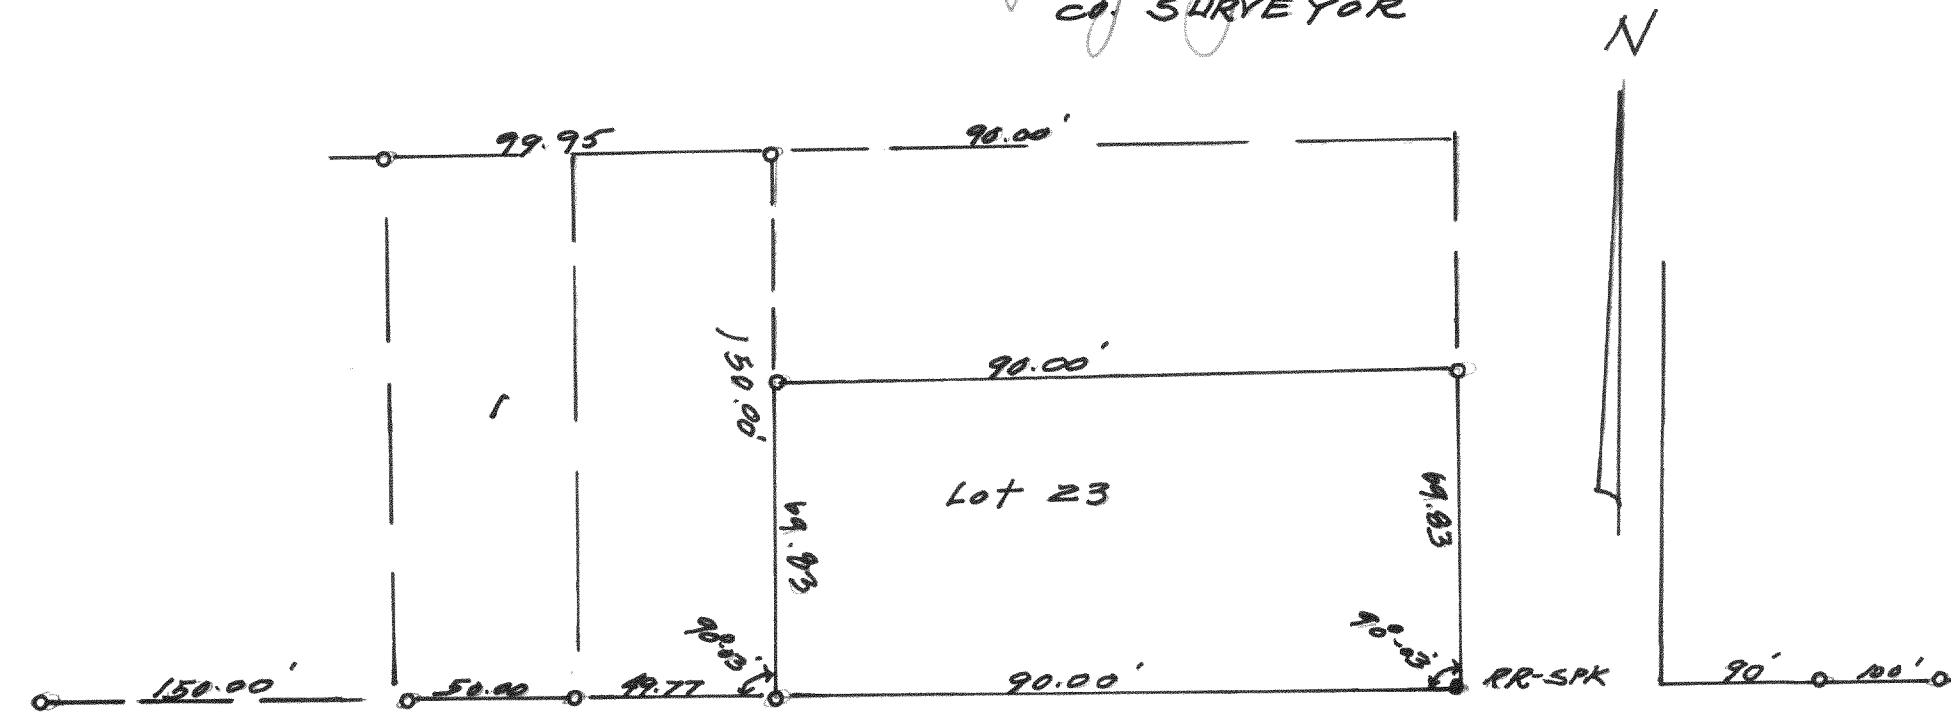

#4360

PLAT OF SURVEY OF LAND IN $E\frac{1}{2}$ NE $\frac{1}{4}$ 1-1-16
VILLAGE OF WILLIAMS BAY, WAL. CO. WIS.

Nov. 1963

Lloyd L. Jensen
CO. SURVEYOR

