



2849

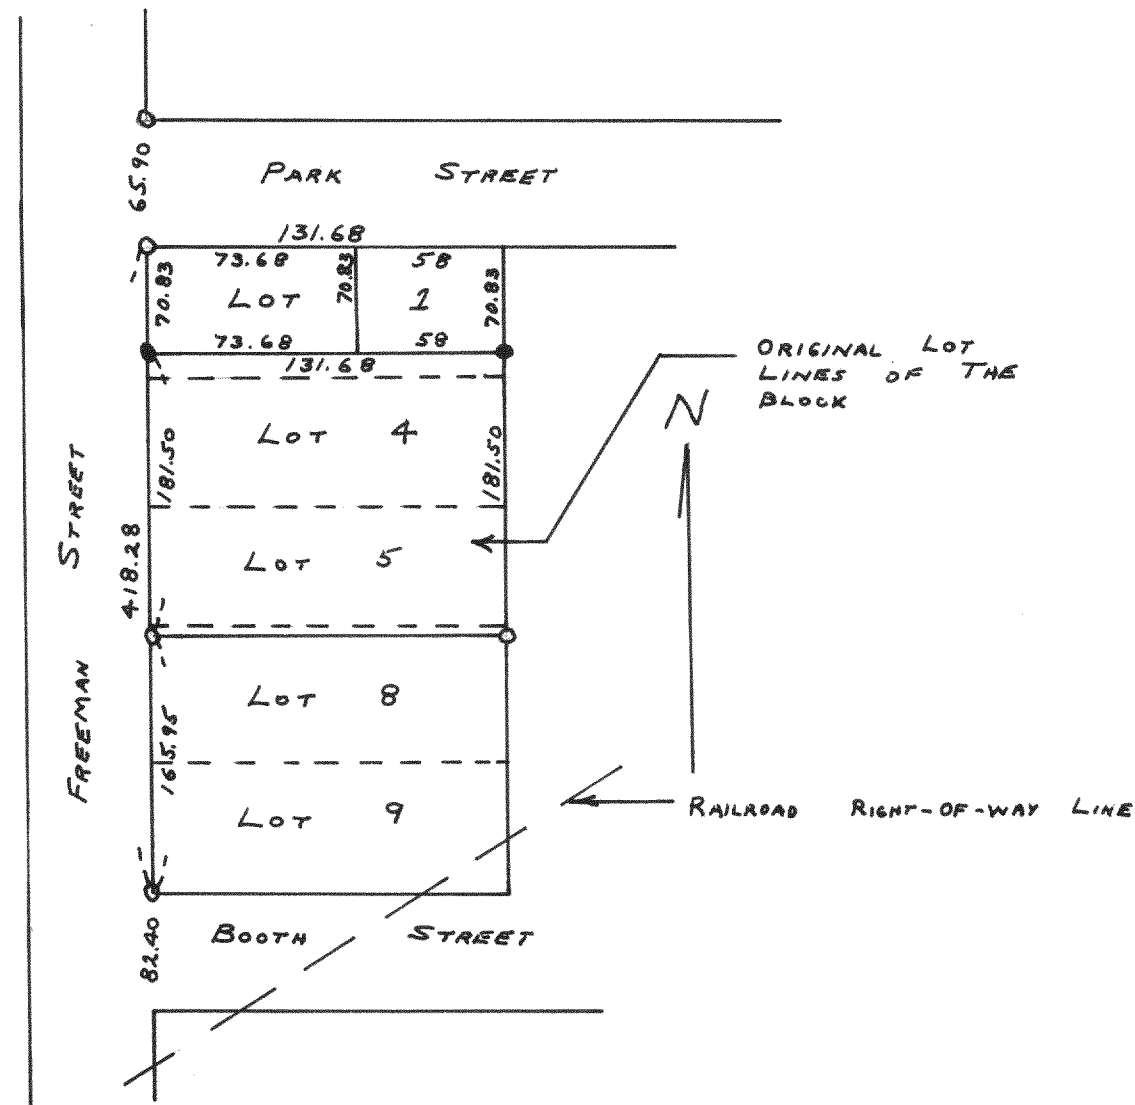

PLAT OF SURVEY OF LOTS 1, 4 AND 5
OF FREEMAN'S ADDITION IN THE VILLAGE
OF GENOA CITY, WISCONSIN.

#2851

JANUARY 1954 LLOYD L. JENSEN SA
COUNTY SURVEYOR

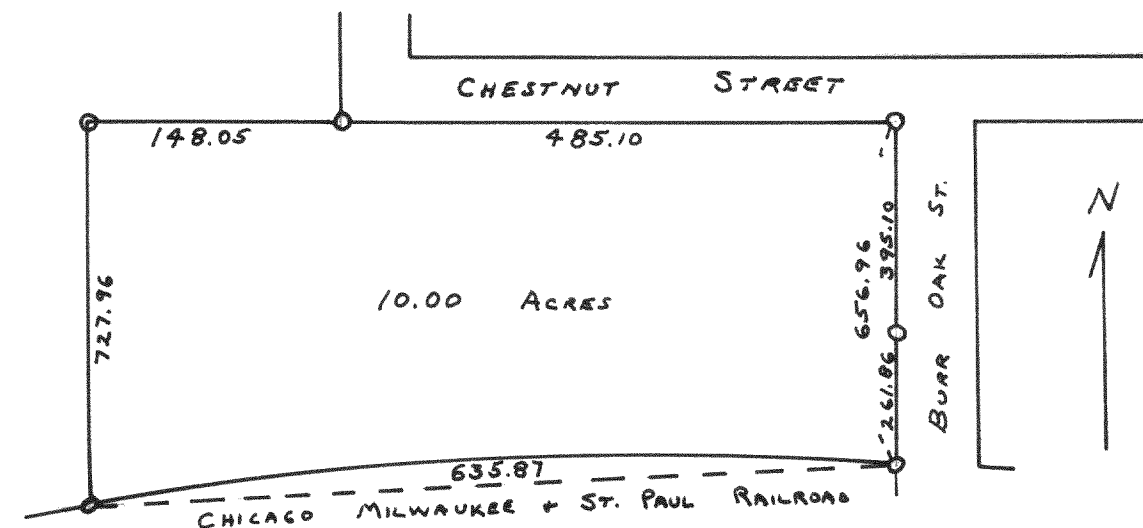


A PARCEL OF LAND LOCATED IN JUSTUS CARPENTER'S
ADDITION AND THE SOUTHWEST $\frac{1}{4}$ OF SECTION 22, T5N, R16E,
VILLAGE OF PALMYRA, JEFFERSON COUNTY, WISCONSIN.

JULY 1954



LLOYD L. JENSEN SA
COUNTY SURVEYOR

2850

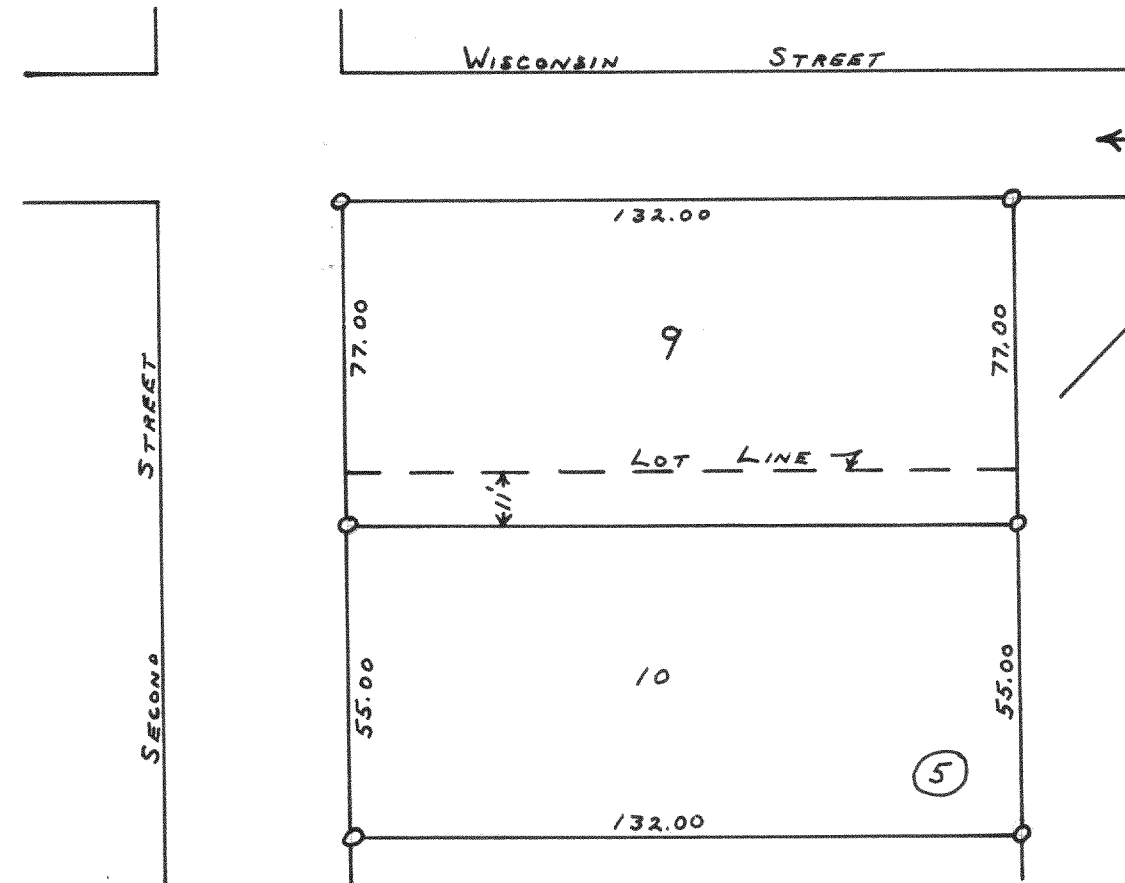

LOTS 9 AND 10, BLOCK 5 OF HIGGINS
ADDITION TO THE VILLAGE OF PALMYRA,
JEFFERSON COUNTY, WISCONSIN
JULY 1954 LLOYD L. JENSEN SA.
COUNTY SURVEYOR

2853

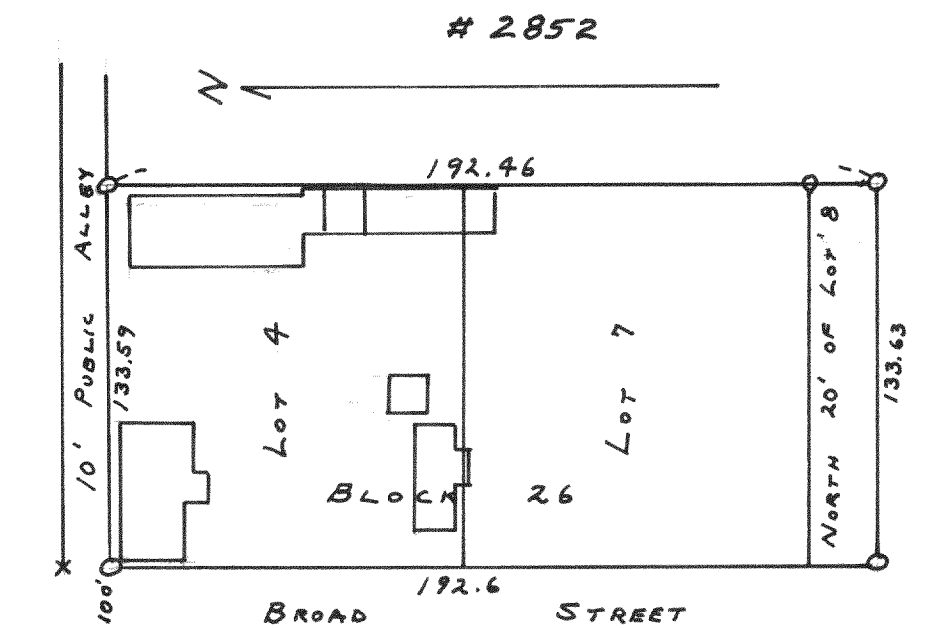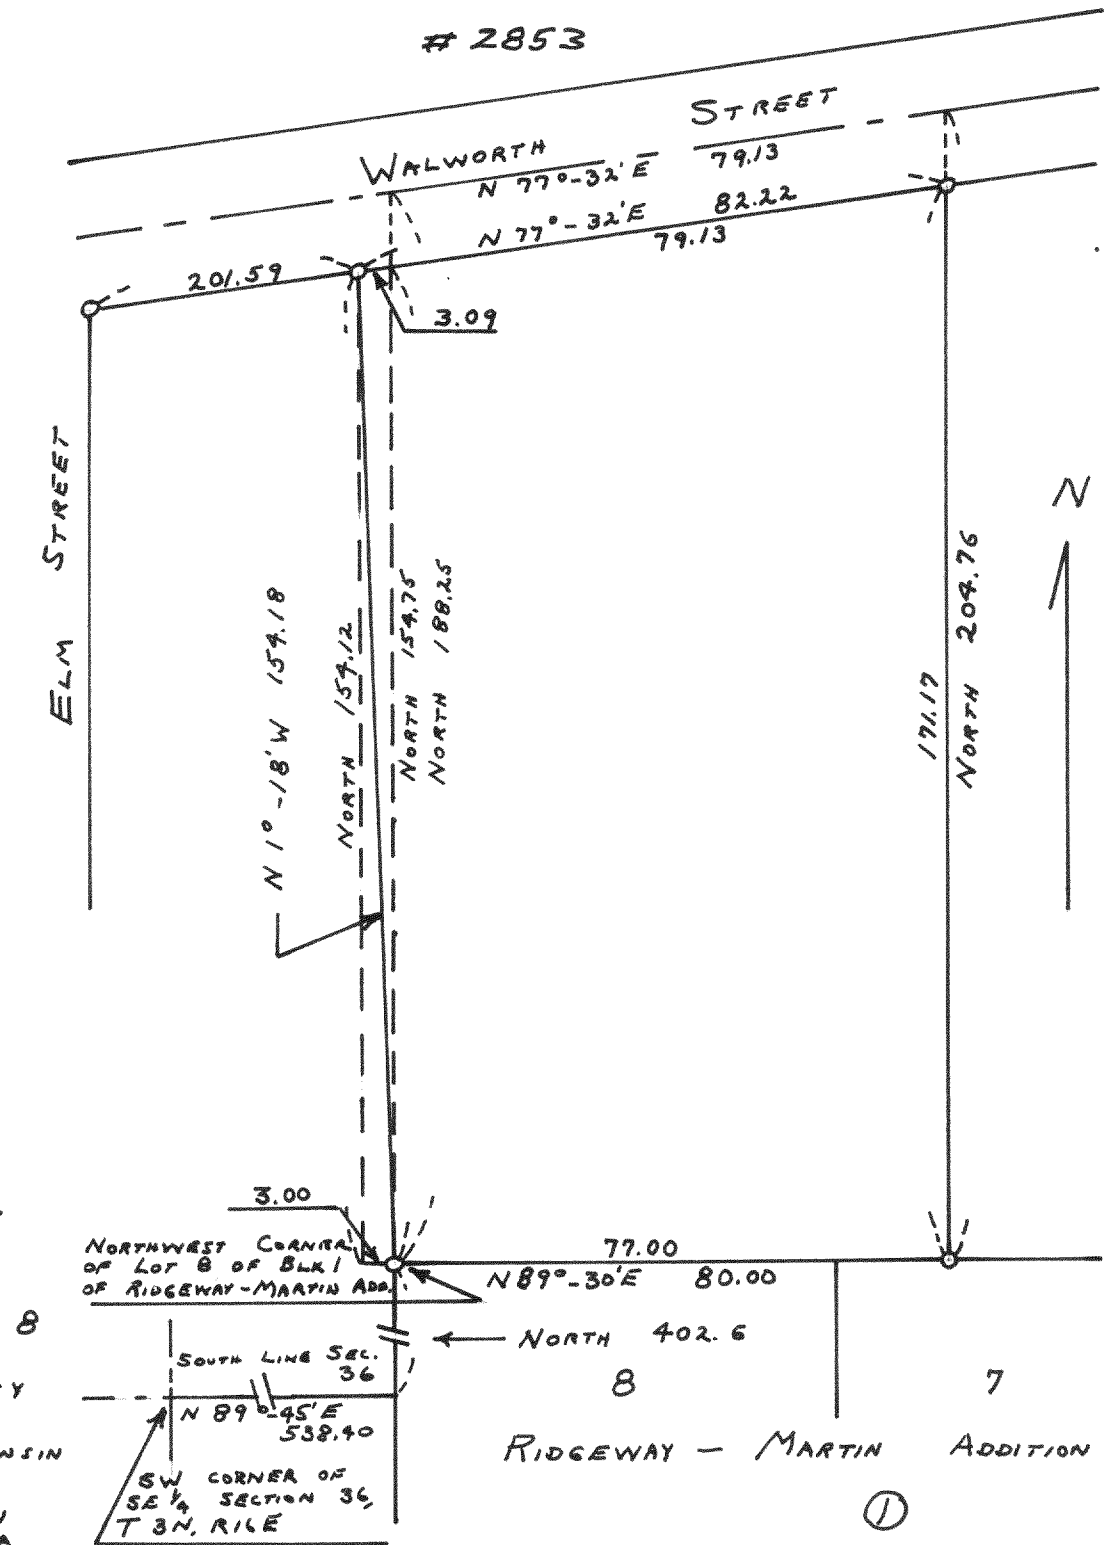

LOTS 4, 7 AND NORTH 20' OF LOT 8
BLOCK 26, ORIGINAL PLAT OF CITY
OF ELKHORN WALWORTH COUNTY, WISCONSIN
OCTOBER 1954 LLOYD L. JENSEN SA
COUNTY SURVEYOR

PLAT OF SURVEY OF LAND LOCATED
IN THE SE $\frac{1}{4}$ OF SECTION 36, T3N, R16E
CITY OF ELKHORN, WALWORTH COUNTY,
WISCONSIN.

FEBRUARY 1954

LLOYD L. JENSEN SA
COUNTY SURVEYOR