

4363

PLAT OF SURVEY
OF

A PARCEL LOCATED IN
SEC. 24 T4N R16E WAL. CO. WIS.
OCT. 1965


Lloyd L. Jensen
LLOYD L. JENSEN
CO. SURVEYOR



4364

PLAT OF SURVEY
OF
LOT 45 OF THE BIRCHE 1ST ADD
SEC 9 E10 T1N R17E WAL. CO. WIS.
OCT 1965

Lloyd L. Jensen
CO. SURVEYOR

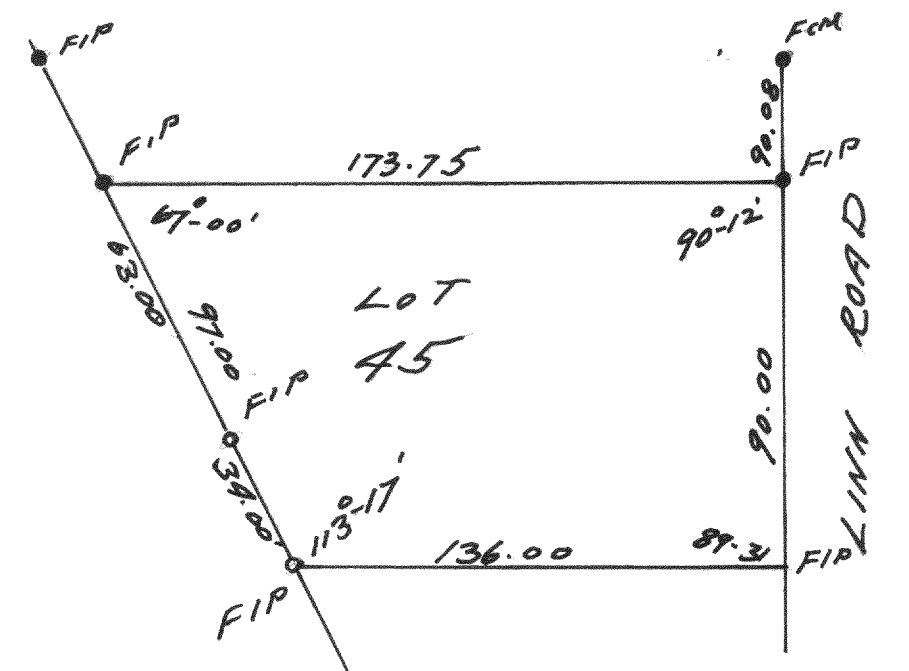


4365

531

PLAT OF SURVEY
OF

LOT #9 & THE WEST 10' OF LOT #10
1ST ADD. TO LAUDERDALE PARK
SEC. 25, T4N R16E WAL. CO. WIS.
JUNE 1965

Lloyd L. Jensen
CO. SURVEYOR

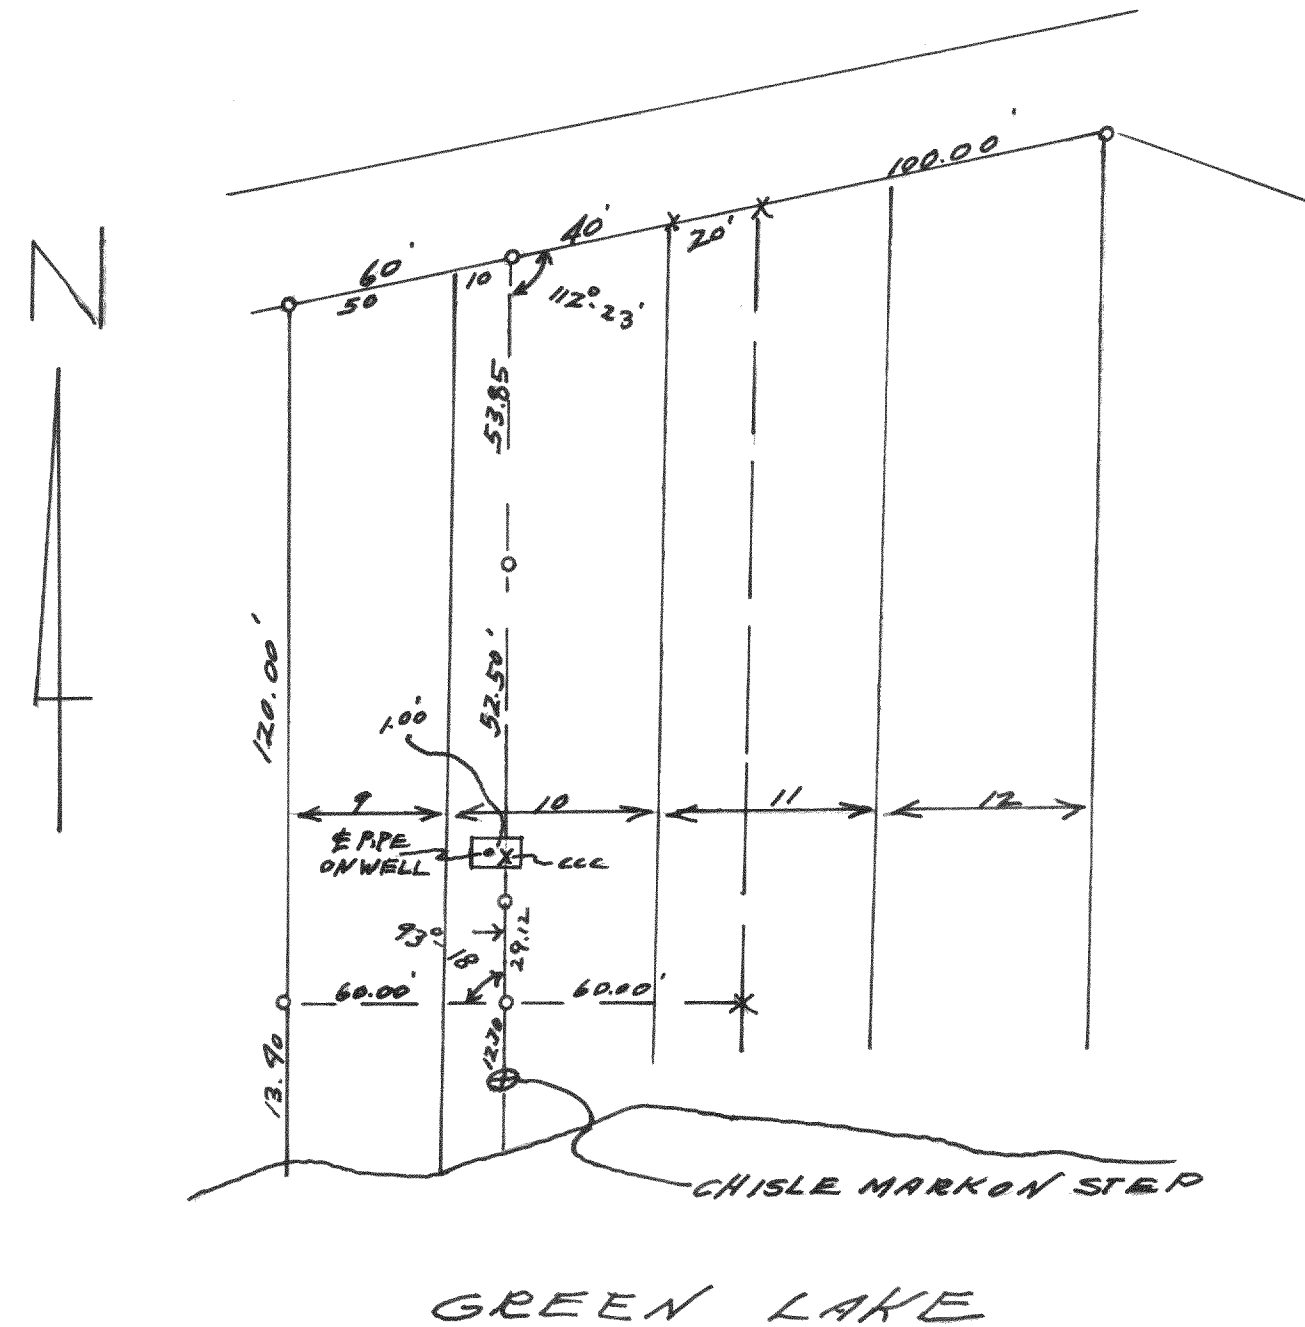

GREEN LAKE