


532

~~#~~ 4366

PLAT OF SURVEY
OF

LOT 30 LAKE GENEVA HIGHLANDS
SEC 8 & 9 T1N R17E WAL. CO. WIS.
SEPT 1965

Lloyd L Jensen
CO. SURVEYOR

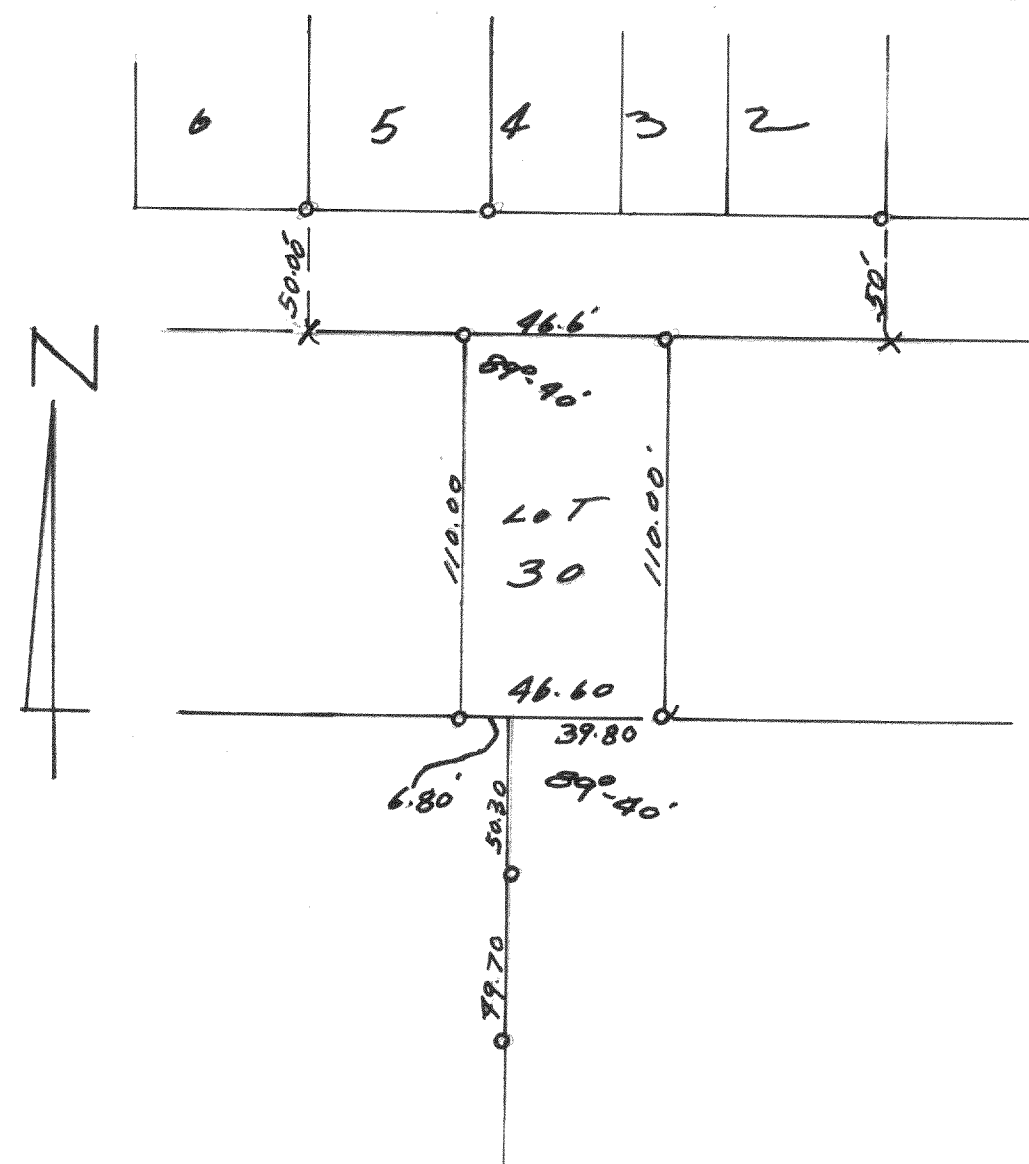


4368

PLAT OF SURVEY
OF

LOT 44 LAKE GENEVA KNOLL SUBD.
SEC 33, T2N R17E WAL. CO. WIS.
MAY 1965

Lloyd L Jensen
L. L. JENSEN CO. SURVEYOR

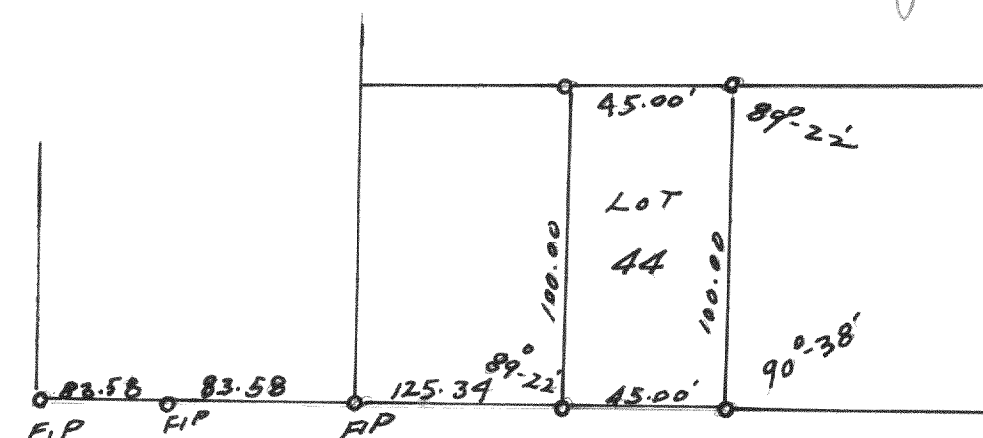

~~II~~ 4367

PLAT OF SURVEY
OF

TEN ACRE PARCEL LOCATED IN THE
SW $\frac{1}{4}$ OF SEC 29, T1N R1E WAL. CO. WIS.
AUG 1965

Lloyd L Jensen
Lloyd L. Jensen
Co. SURVEYOR

