


#4372 PLAT OF SURVEY
OF

LOTS 6625 ~ 6630 BLK 114
LAKE COMO BEACH SUBD.
SEC 28, T2N R1E WAL. CO. WIS.


AUG. 1965

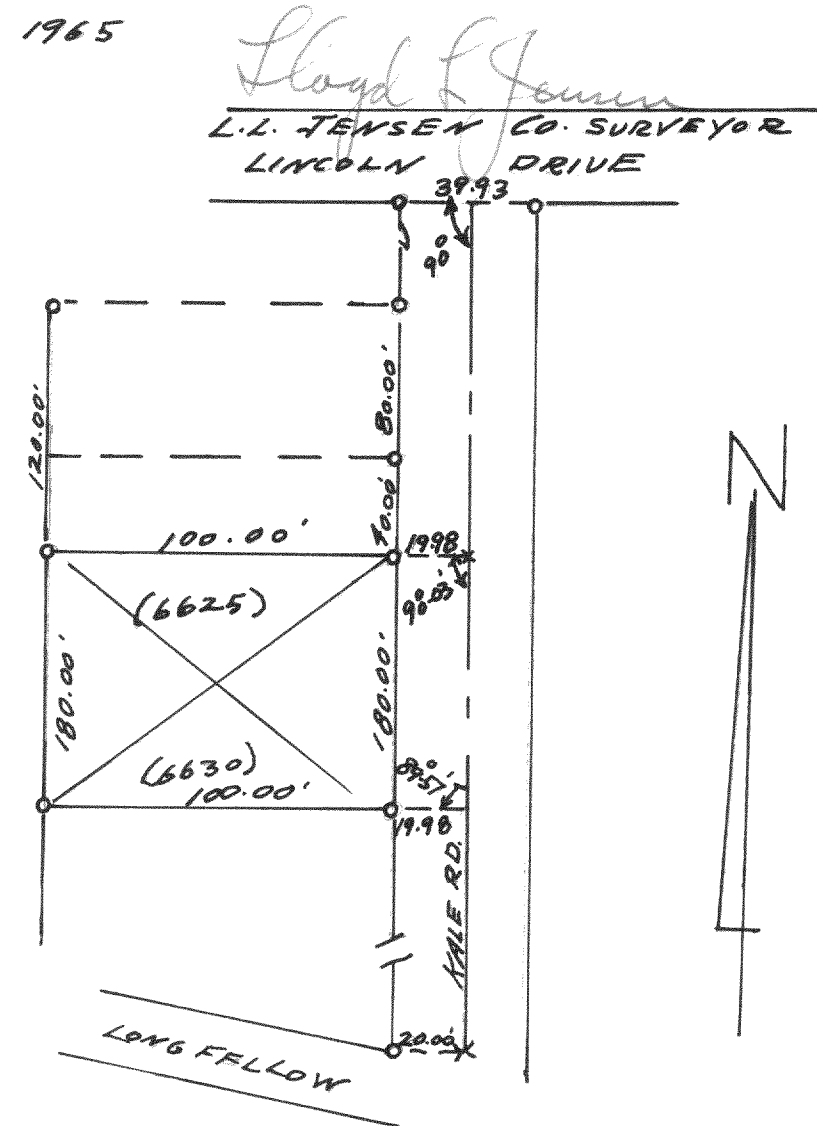

#4373 PLAT OF SURVEY
OF

LOTS 9768-9770 BLK 179
LAKE COMO BEACH SUBD.
SEC 28, T2N R1E WAL. CO. WIS.

AUG 1965

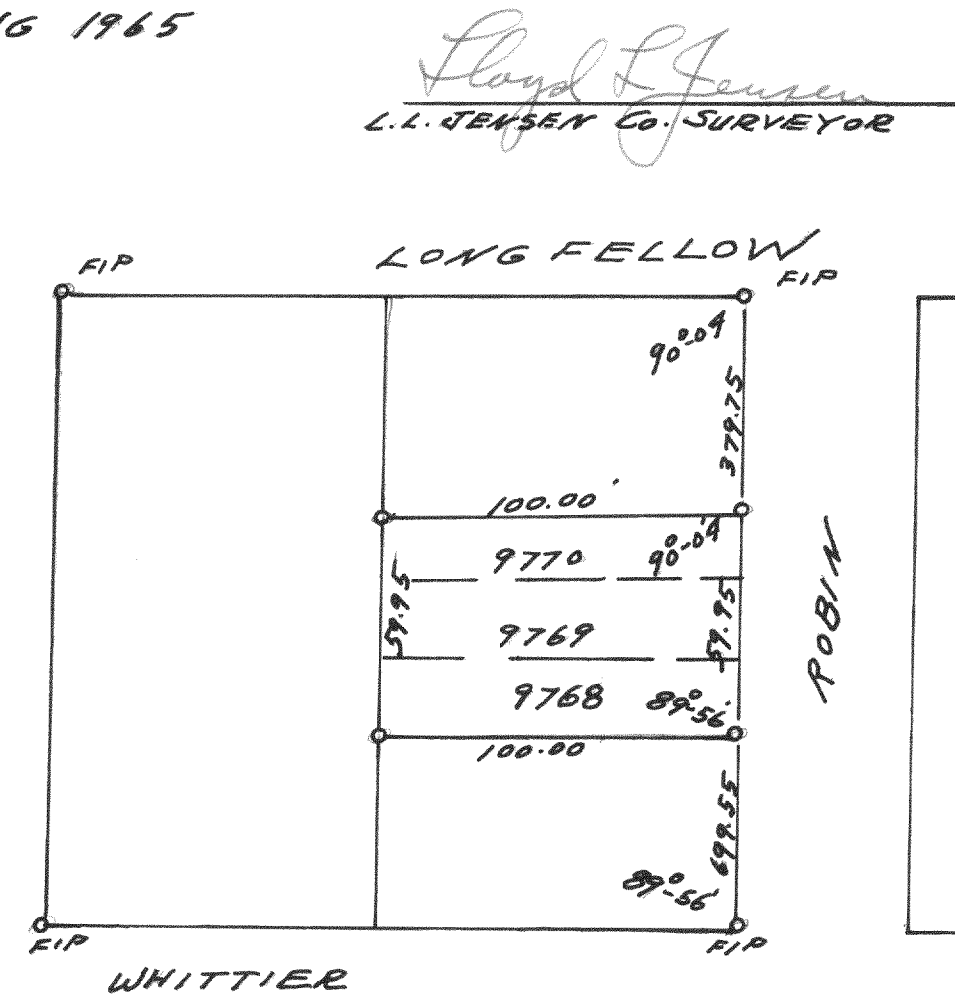


PLAT OF SURVEY
OF

A PARCEL IN THE NE $\frac{1}{4}$ SEC. 19
T2N R1E WAL. CO. WIS.

AUG 1965

#4374

Lloyd L. Jensen
L.L. JENSEN CO. SURVEYOR

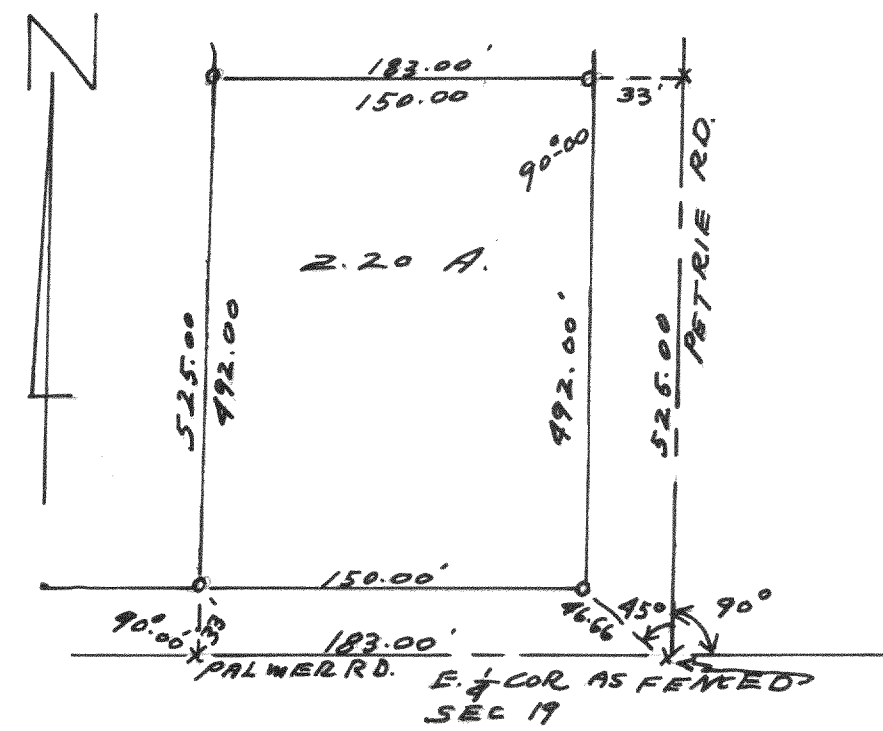

#4375

PLAT OF SURVEY
OF

A PARCEL IN THE NE $\frac{1}{4}$ OF
SEC 21 T2N R1E WAL. CO. WIS.

JULY 1965

Lloyd L. Jensen
L.L. JENSEN CO. SURVEYOR

