

#4376 PLAT OF SURVEY

OF


LOTS 4746-4753 BLK 83

LAKE COMO BEACH SUBD.

T2N R1E WAL. CO. WIS.

JUNE 1965

Lloyd L. Jensen
 LLOYD L. JENSEN CO. SURVEYOR

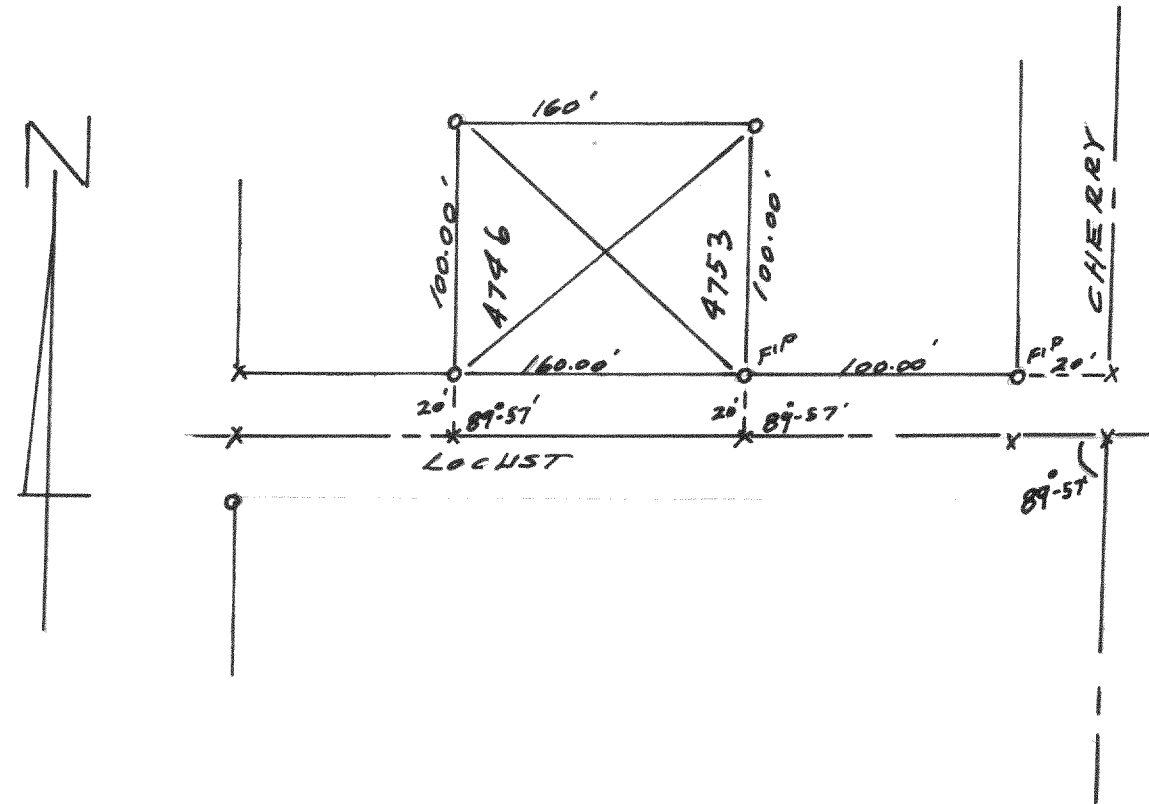

#4377


PLAT OF SURVEY

OF

LAND LOCATED IN THE SW $\frac{1}{4}$ OF
 SEC 19 T3N R1E WAL. CO. WIS.

JUNE 1965

Lloyd L. Jensen
 CO. SURVEYOR

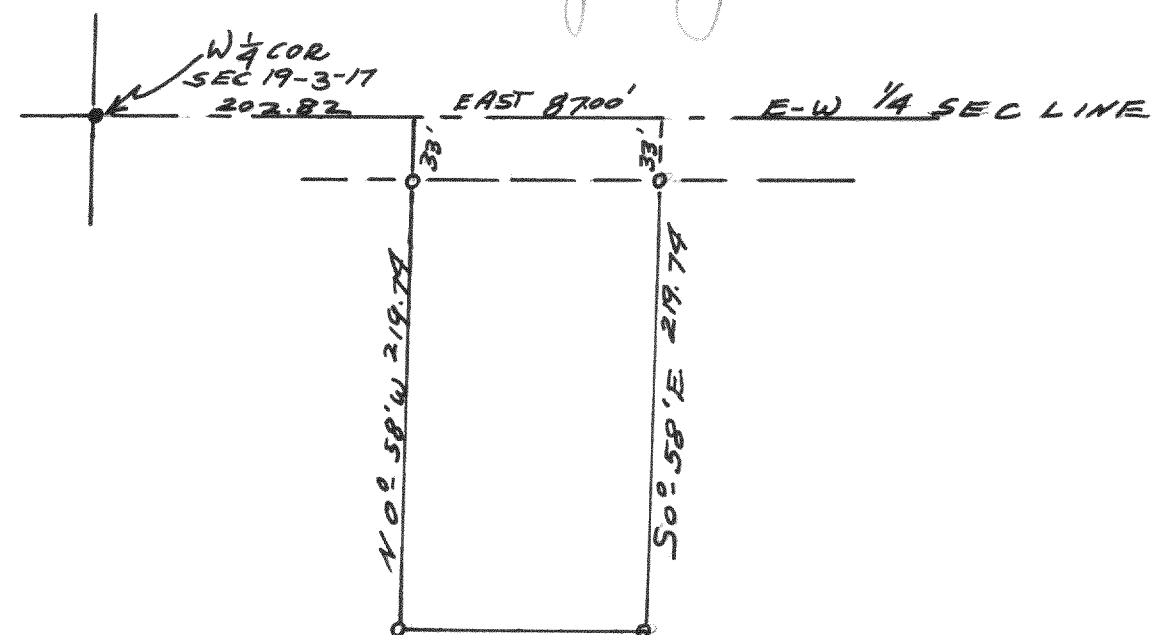

#4378 PLAT OF SURVEY

OF

A PARCEL IN THE SE $\frac{1}{4}$ OF
 SECTION 12 & THE NE $\frac{1}{4}$ OF
 SECTION 13, T4N R1E
 WAL CO WIS.

JULY 1965

Lloyd L. Jensen
 Lloyd L. Jensen Co. Surveyor

