

4384


PLAT OF SURVEY

OF

LOTS 3, 4, & 5, BLOCK 4
MIRAMAR SUBDIVISION IN
SECTIONS 10 & 11, T4N R1E
WAL. CO. WIS.

AUG 1965

Lloyd L. Jensen
LLOYD L. JENSEN
CO. SURVEYOR

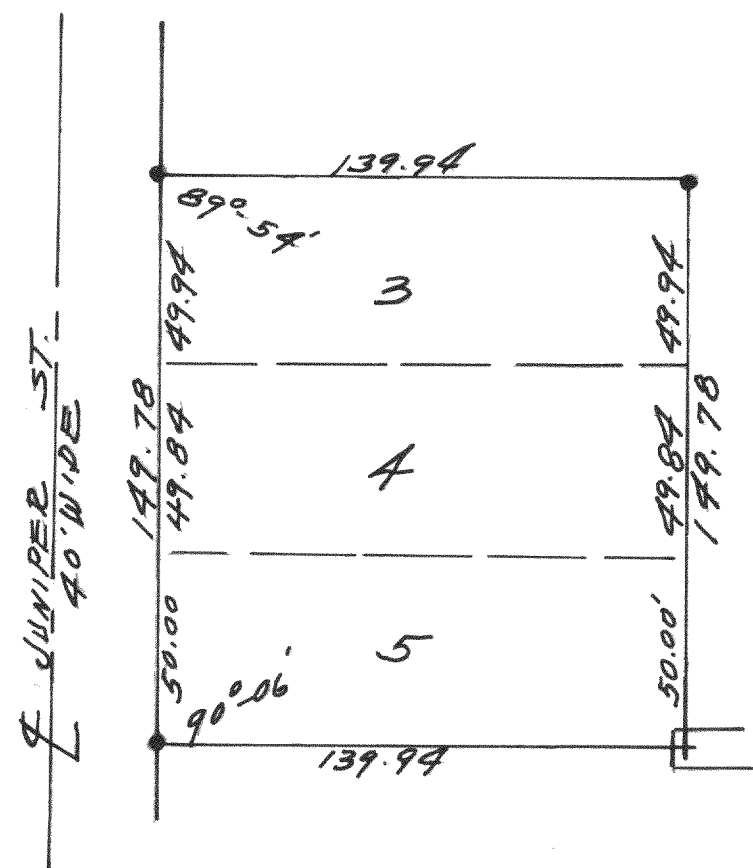

4385

PLAT OF SURVEY

OF

LOTS 1 + 2 BLK 22 MIRAMAR
SUBD. ADD. #1 IN THE NW $\frac{1}{4}$ SEC 10,
T4N R1E WAL. CO. WIS.

MAY 1965

Lloyd L. Jensen
LLOYD L. JENSEN
CO. SURVEYOR

