


~~#~~ 4396

PLAT OF SURVEY
OF

LOT 7 BLOCK 4 HARBOR
VIEW SUBDIVISION LOCATED
IN SECTION 6, T1N-R17E,
WALWORTH COUNTY, WISCONSIN.

SEPT. 1965

Lloyd L. Larson
CO. SURVEYOR

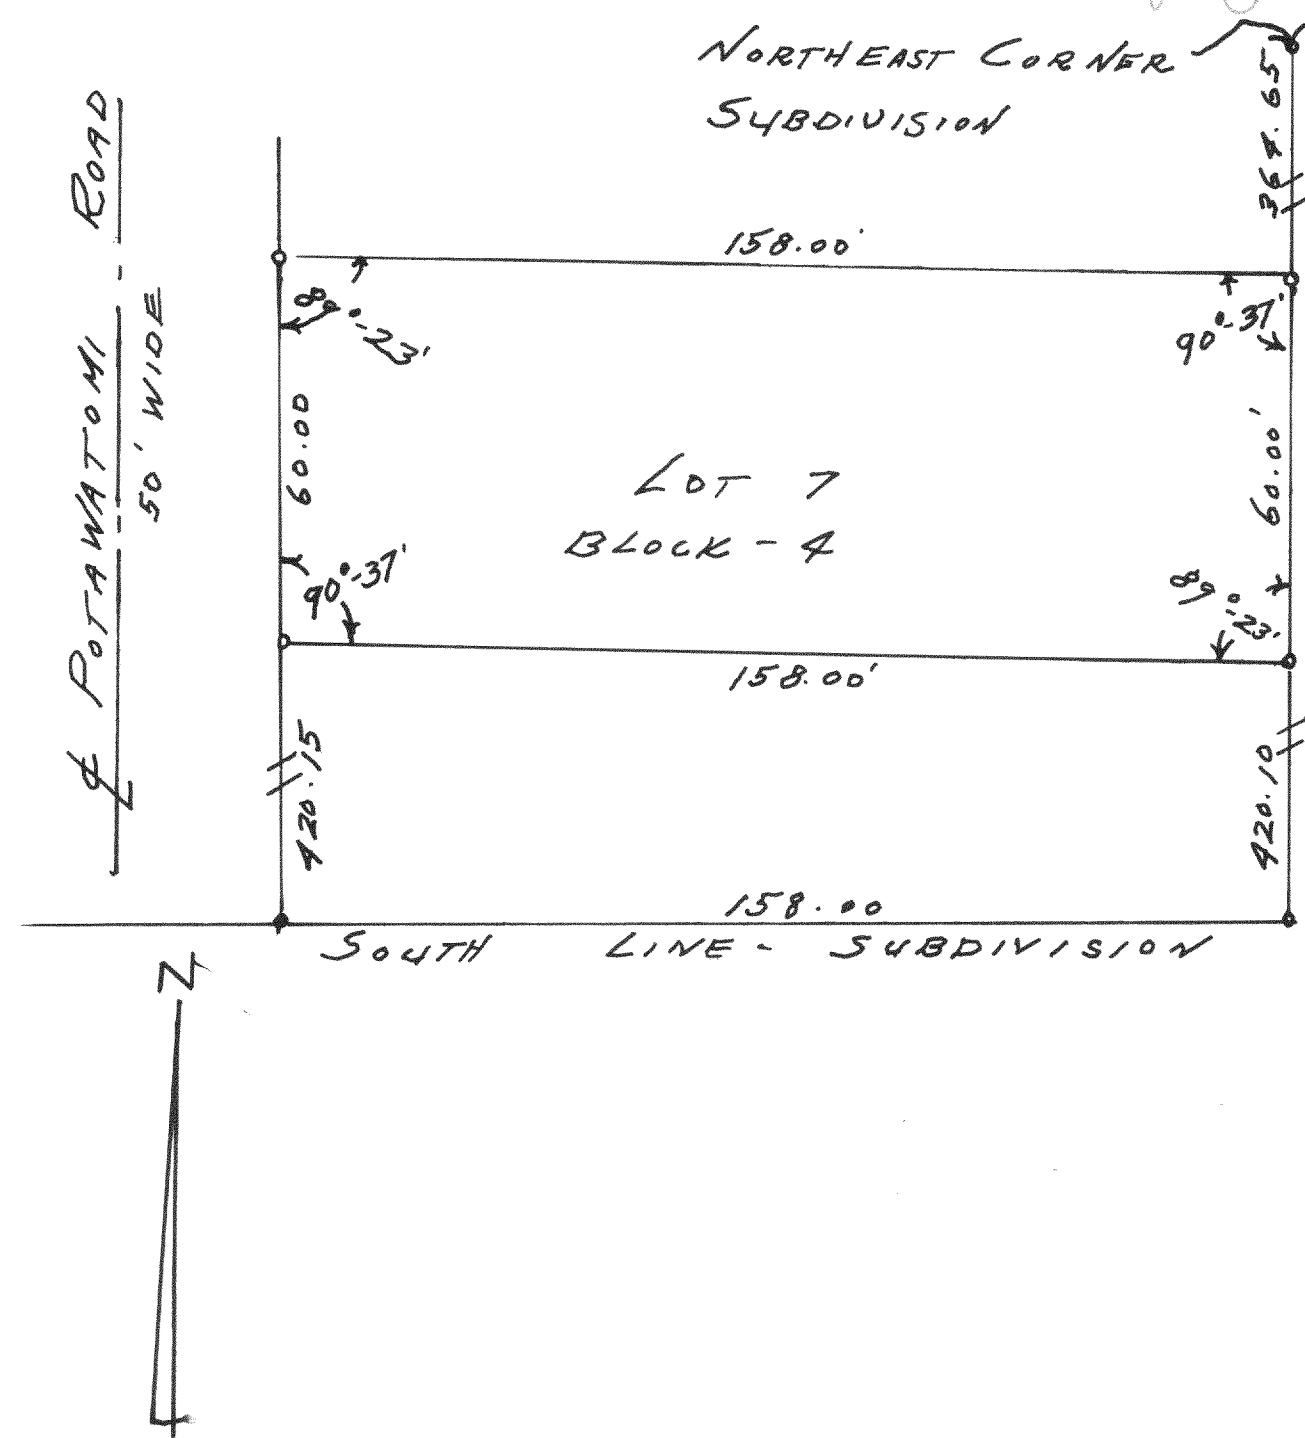

#4397

PLAT OF SURVEY
OF

DEC. 1965

Lloyd F. Bence
CO. SURVEYOR

