

#4398


PLAT OF SURVEY

LOTS 7074 - 7075 - 7076 BLOCK 121
LAKE COMO BEACH SUBDIVISION
WALWORTH COUNTY, WISCONSIN.

AUGUST 1965

Lloyd L. Jensen
CO. SURVEYOR

LINCOLN DRIVE

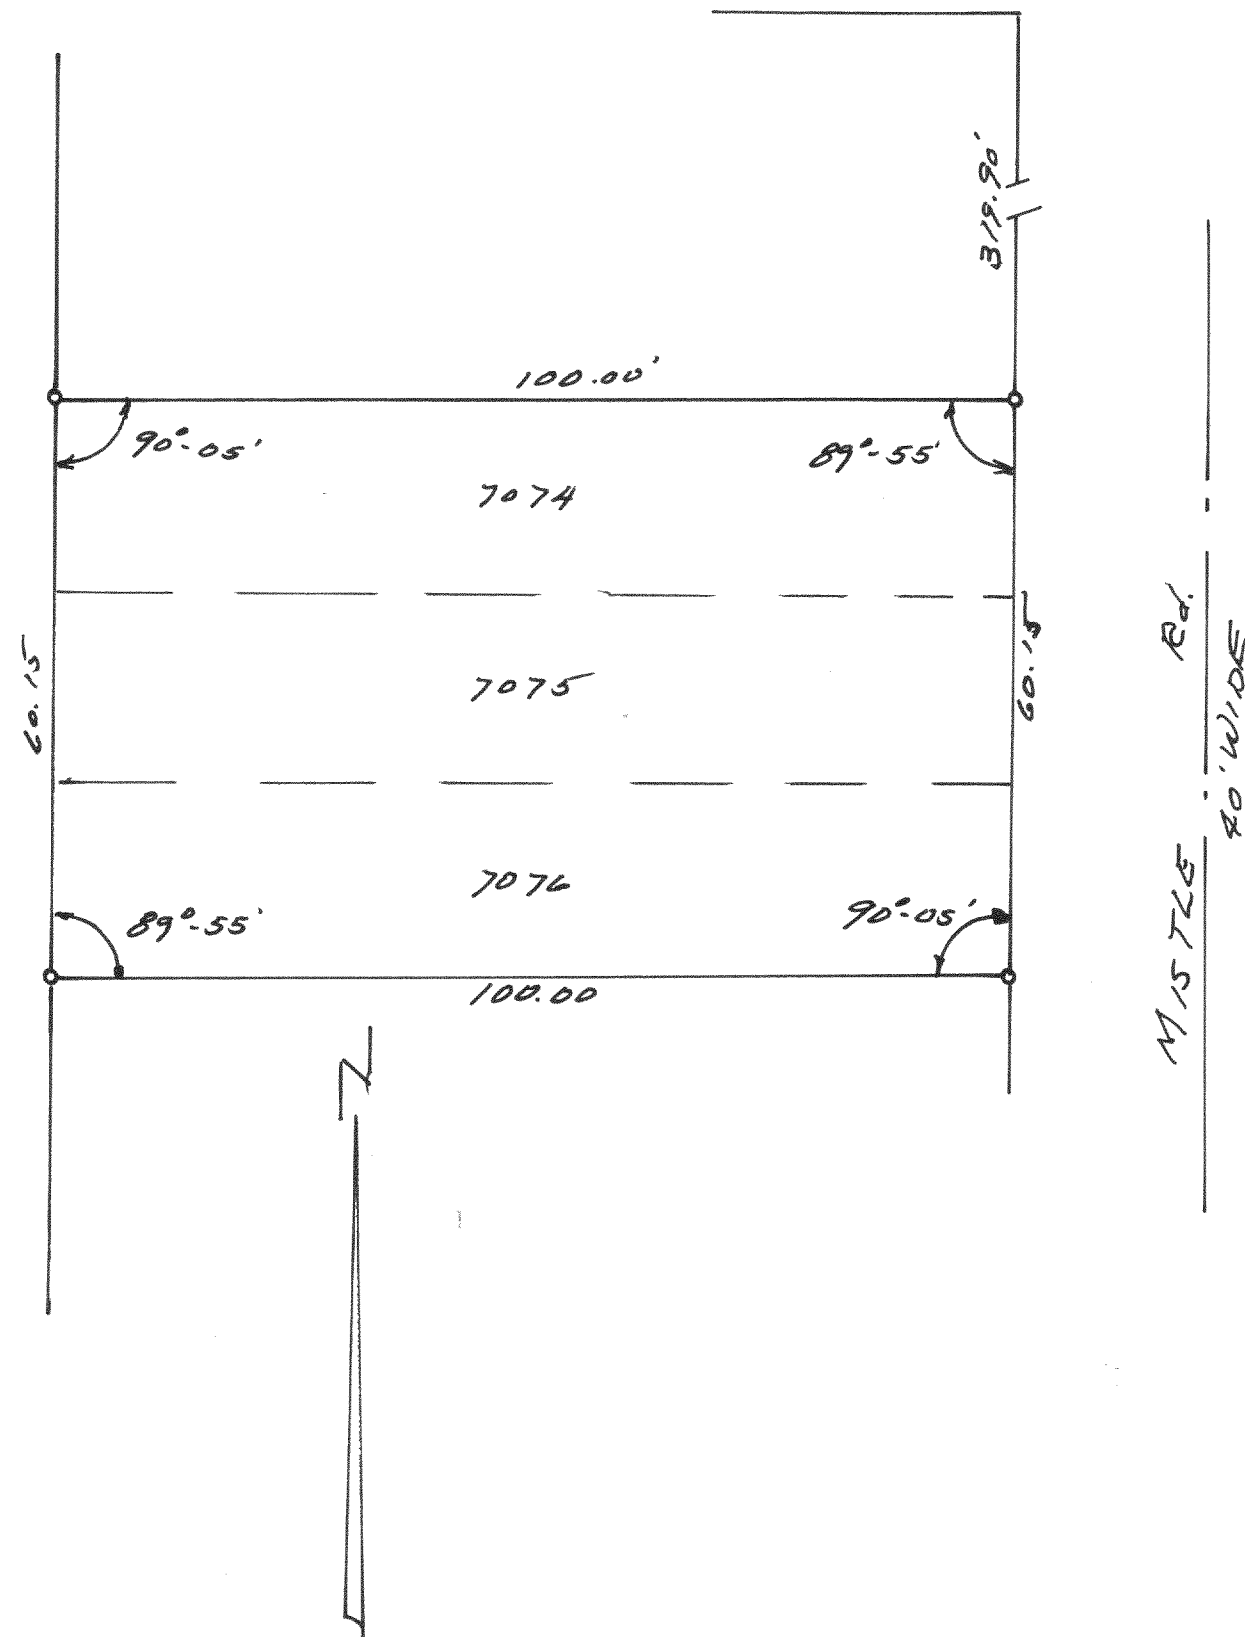


#4399

PLAT OF SURVEY

OF

NE 1/4 SECTION 19
T2N-R17E, WALWORTH
COUNTY, WISCONSIN.

DEC. 1965

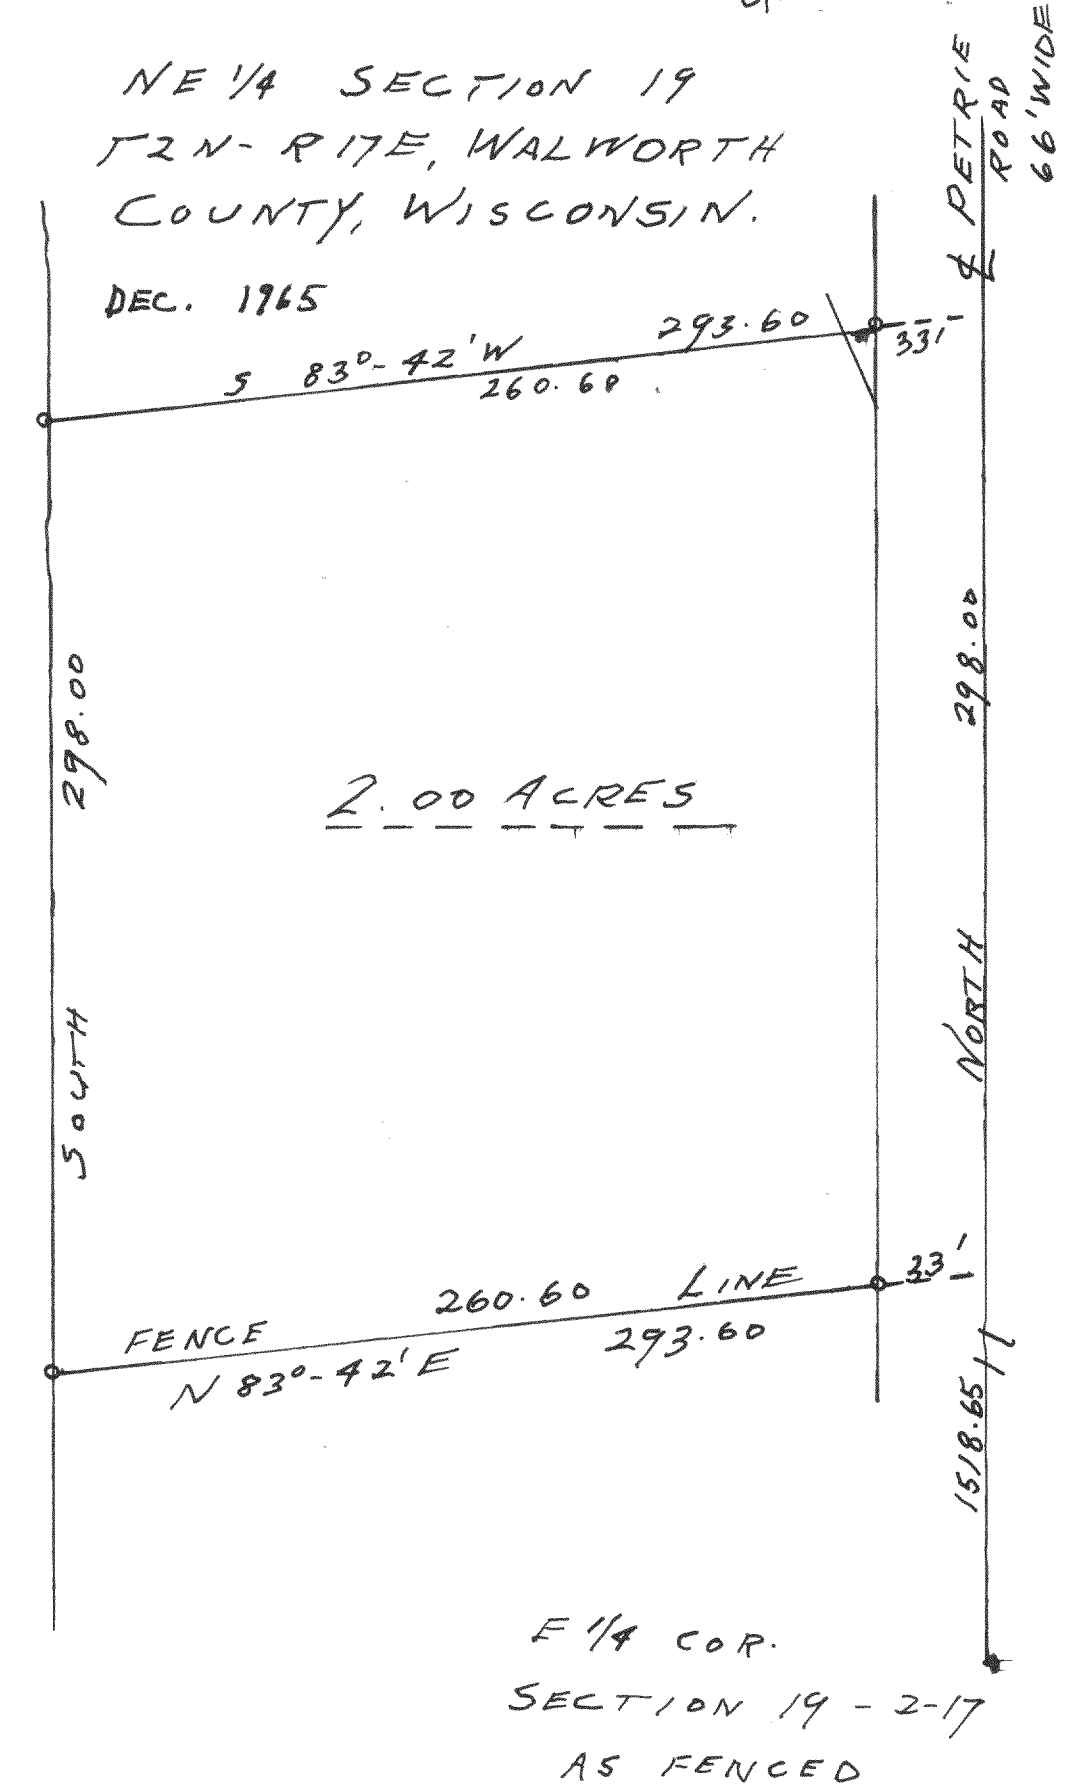

Lloyd L. Jensen
CO. SURVEYOR