


SEPT. 1965

Lloyd F. Jensen
Co. SURVEYOR

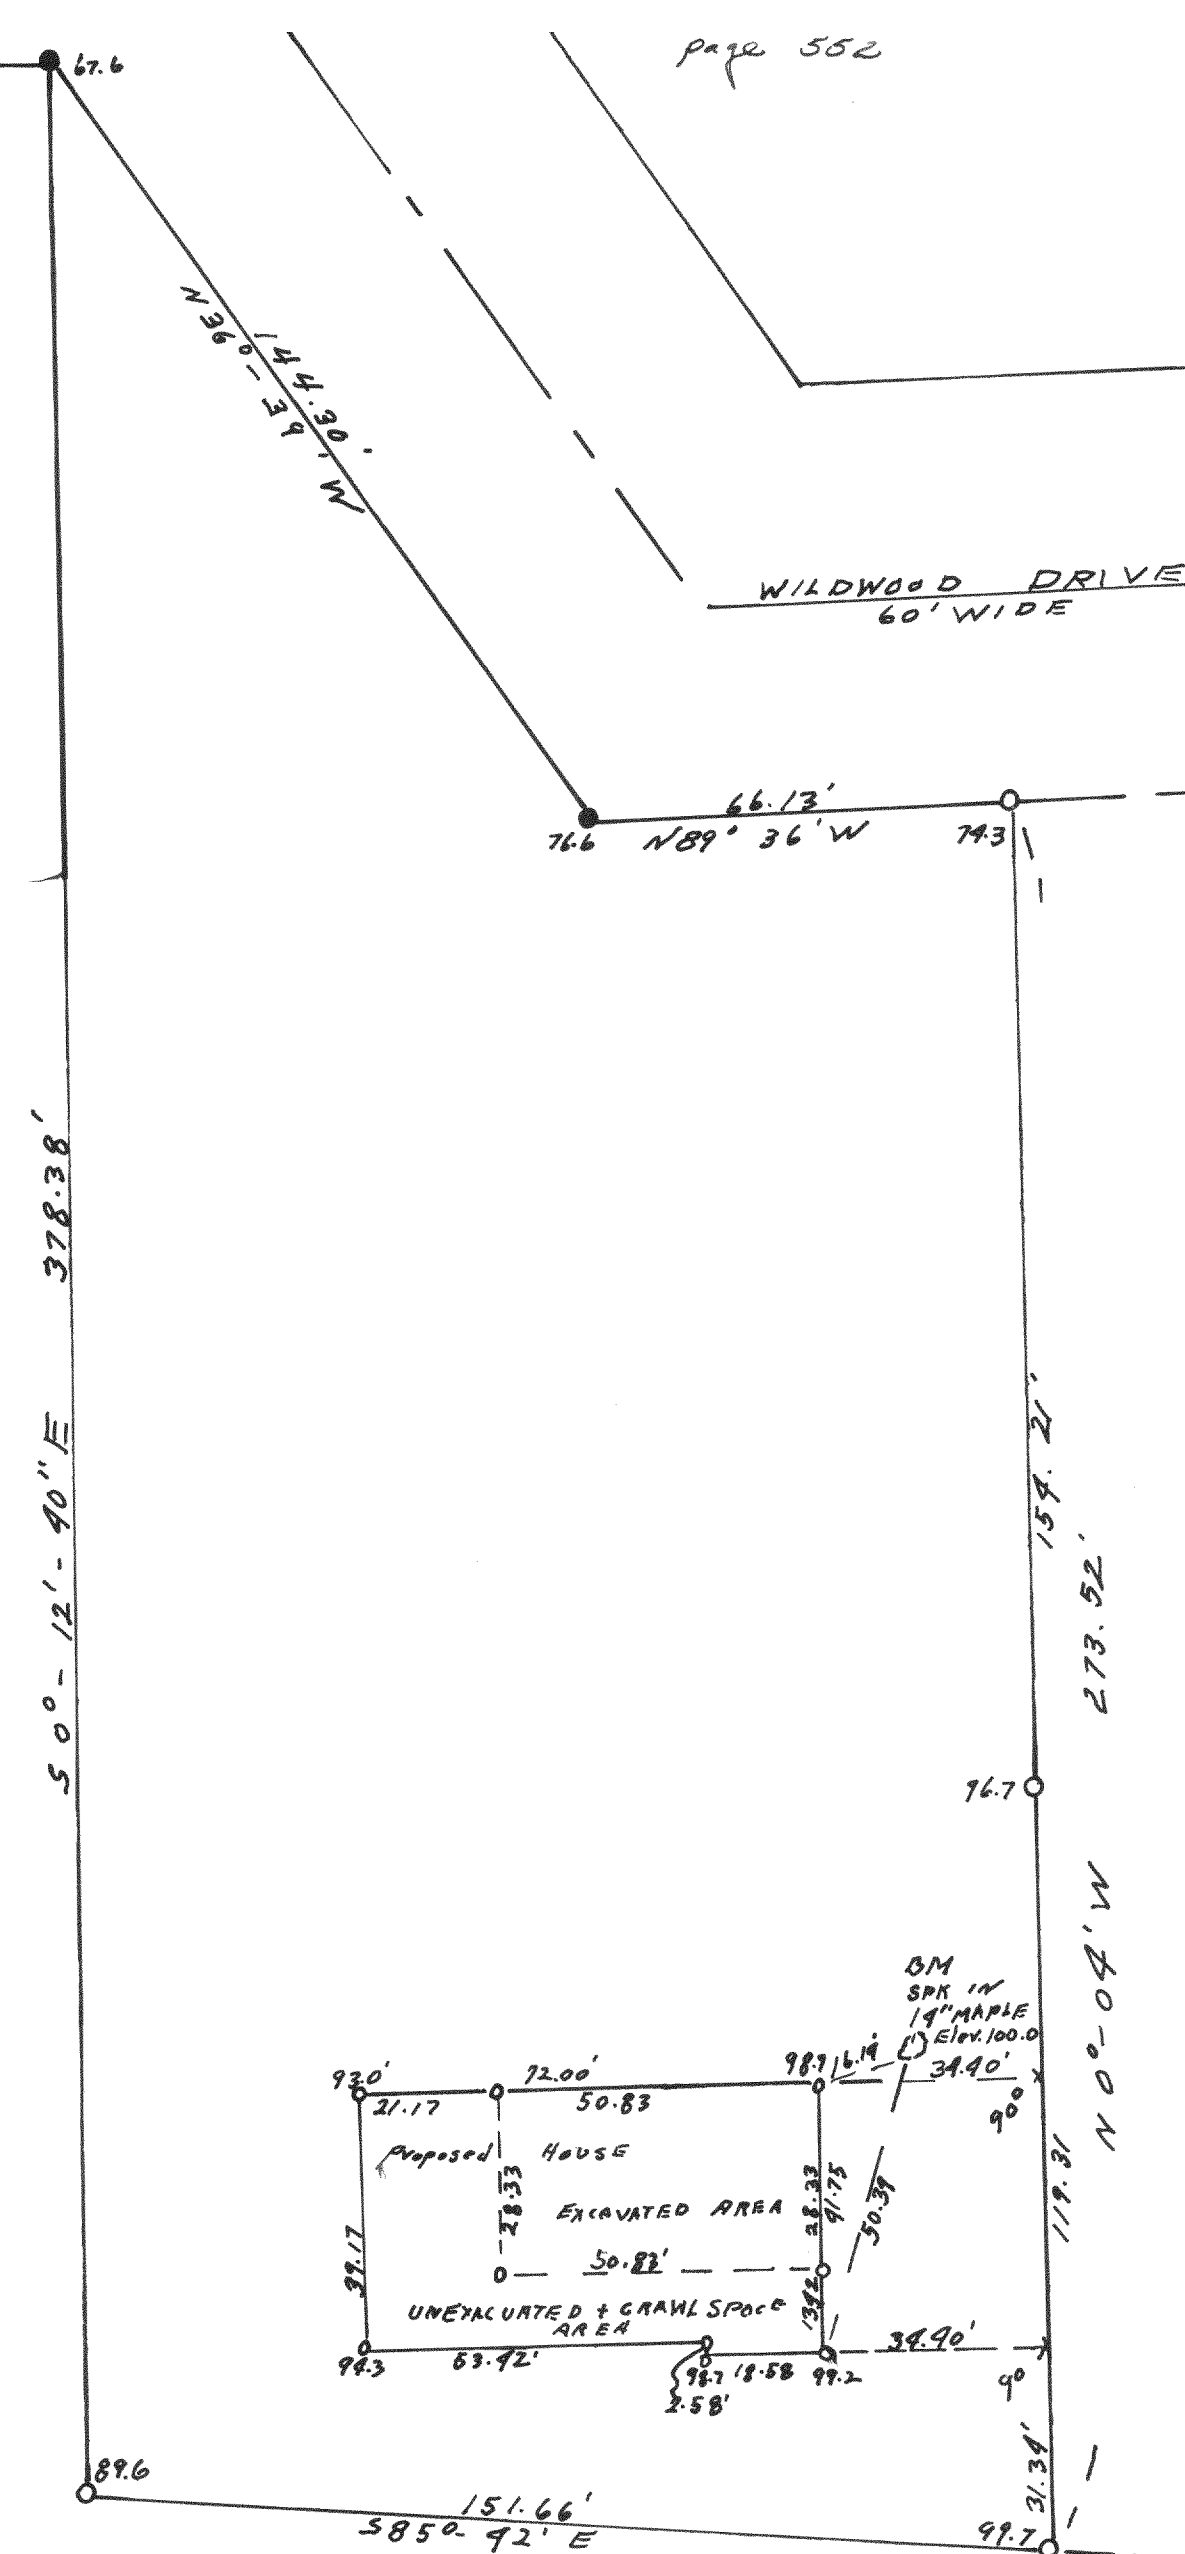

PLAT OF SURVEY
OF

LOT #7 OF THE PRELIMINARY PLAT (TO BE KNOWN
AS LOT #4 OF THE FINAL PLAT) OF
WILDWOOD SUBDIVISION, LOCATED IN THE
NW $\frac{1}{4}$ & NE $\frac{1}{4}$ SEC. 34 T2N R17E WAL. CO. WIS.