




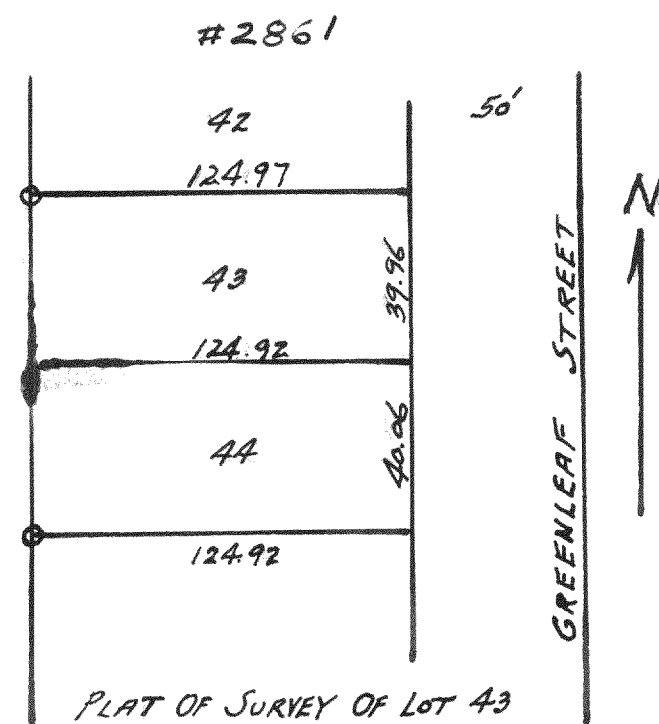

PLAT OF SURVEY OF LOT 43
BLOCK 1 CISCO BEACH
T1N R17E WALWORTH CO. WISC.
SEPT. 1954 LLOYD L. JENSEN
COUNTY SURVEYOR

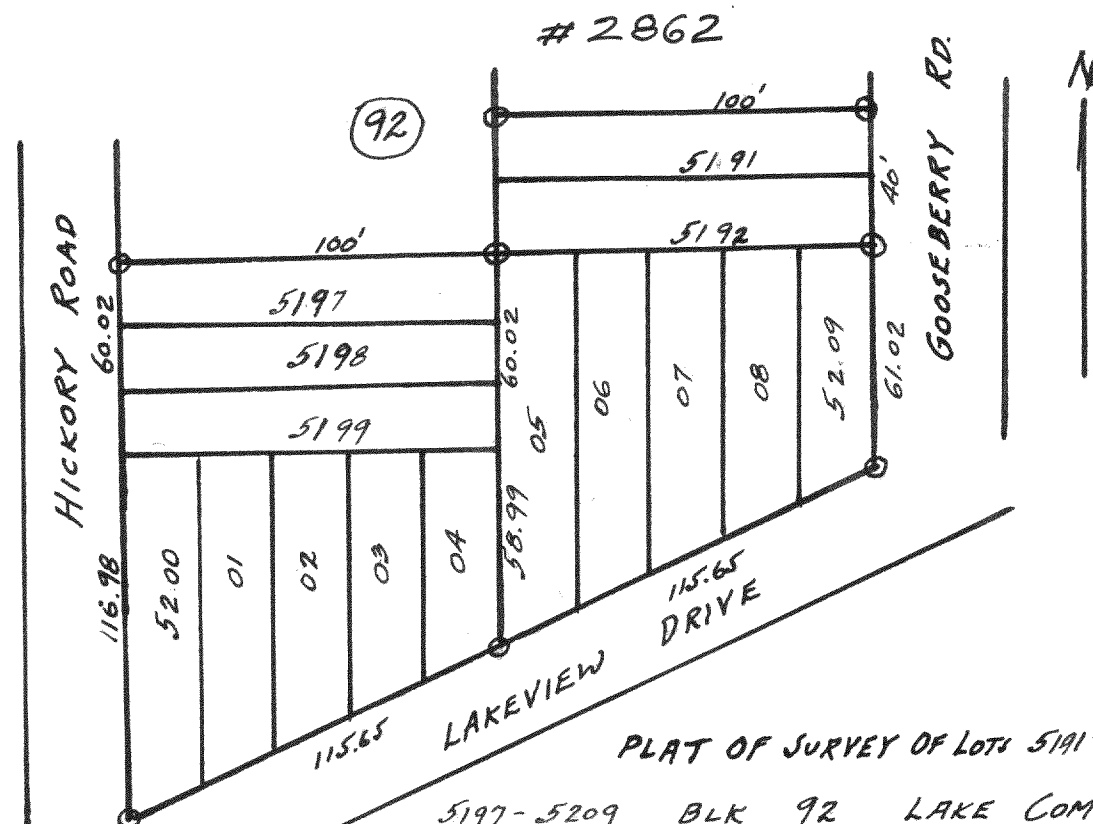

PLAT OF SURVEY OF LOTS 5191-5192
5197-5209 BLK 92 LAKE COMD BEACH
T2N R17E WALWORTH COUNTY WISC.
OCT. 1954 LLOYD L. JENSEN
COUNTY SURVEYOR

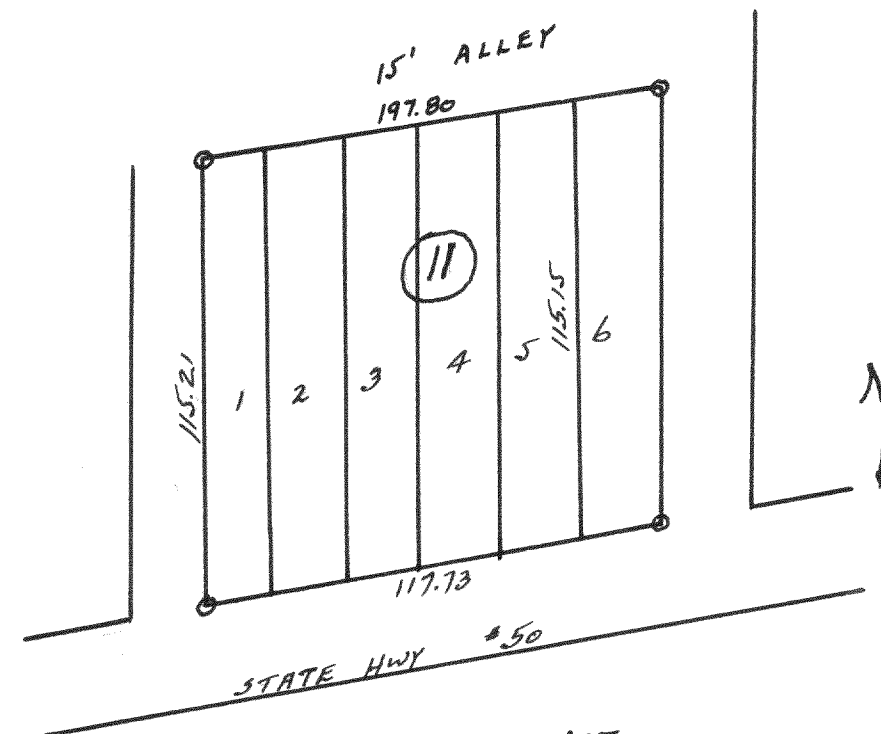

PLAT OF SURVEY OF LOTS
1-5 BLOCK 11
SUNSET HILLS T2N R17E
WALWORTH COUNTY WISCONSIN
JULY 1954

#2863

