

4420


PLAT OF SURVEY

OF

Lloyd L Jensen
CO. SURVEYOR

APIL 1965

PART OF LOT 1 AND LOT 2
BLOCK 8 - ORIGINAL PLAT VILLAGE
OF EAST TROY, WALWORTH
COUNTY, WISCONSIN.

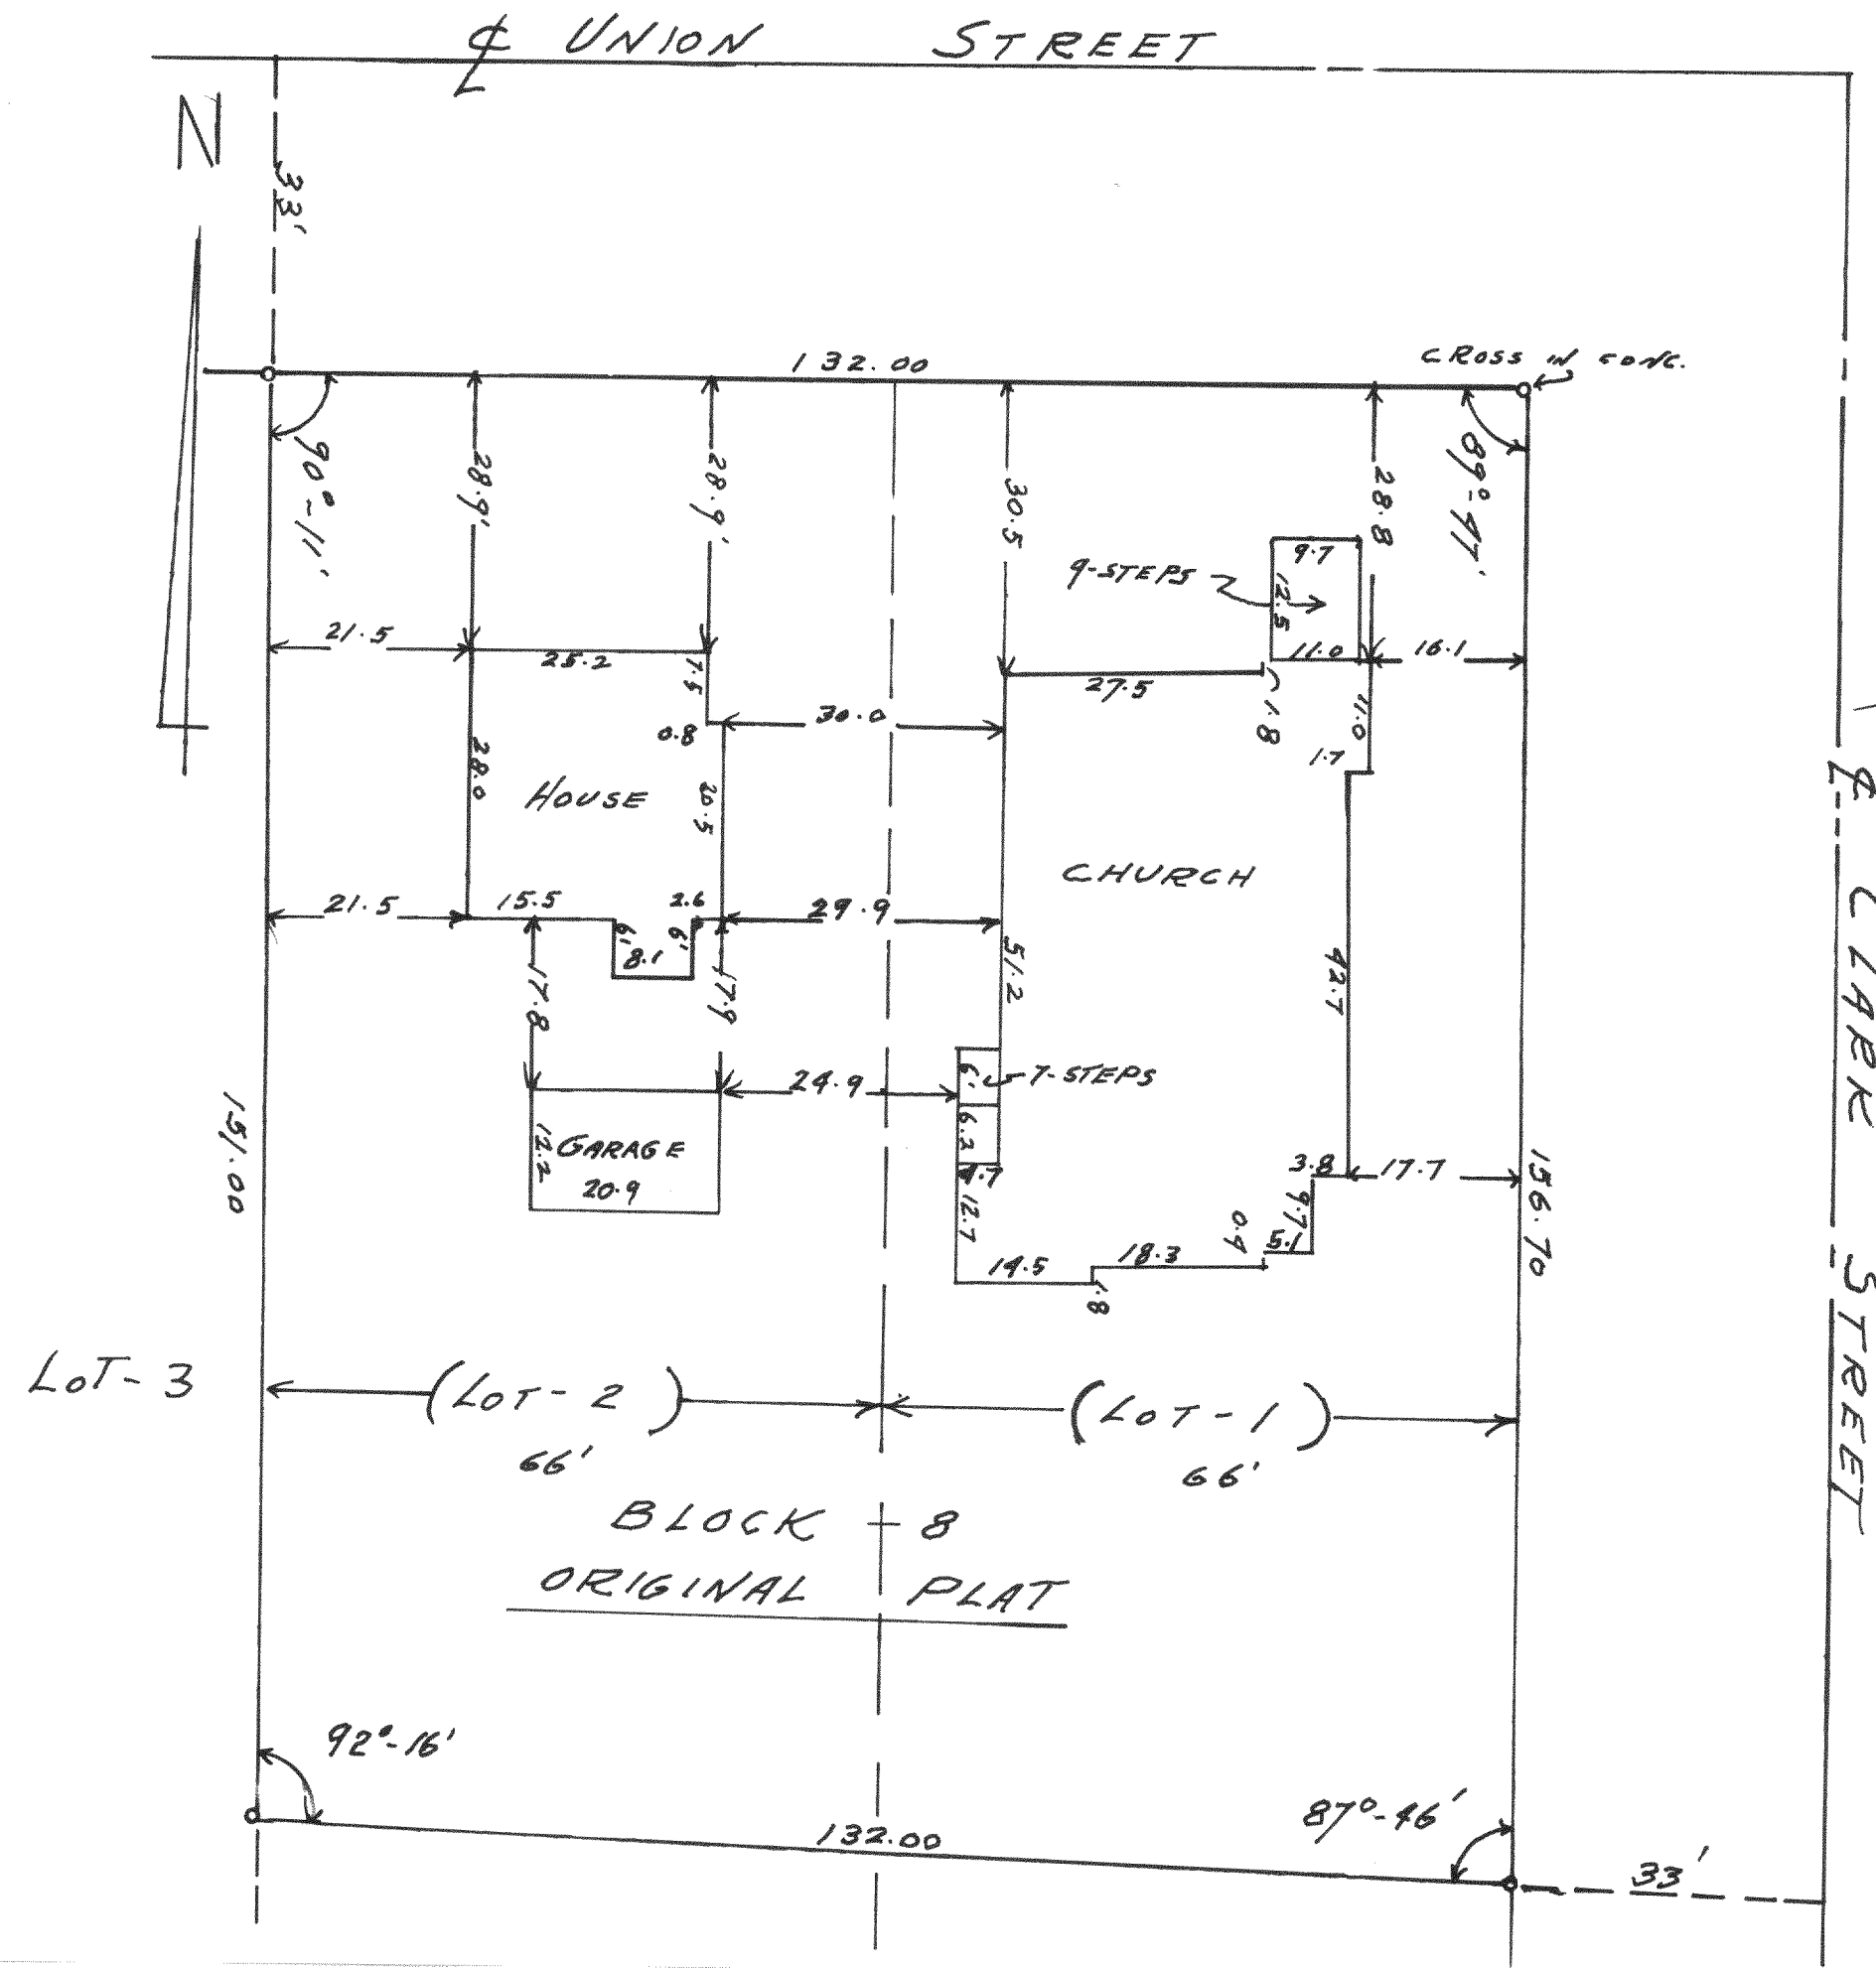

4421

PLAT OF SURVEY

OF

Lloyd L Jensen
CO. SURVEYOR

OCT. 1965

PART OF LOTS 230-231-232
3RD ADD'N TO CEDAR POINT PARK
WILLIAMS BAY, WISCONSIN.

