


4437

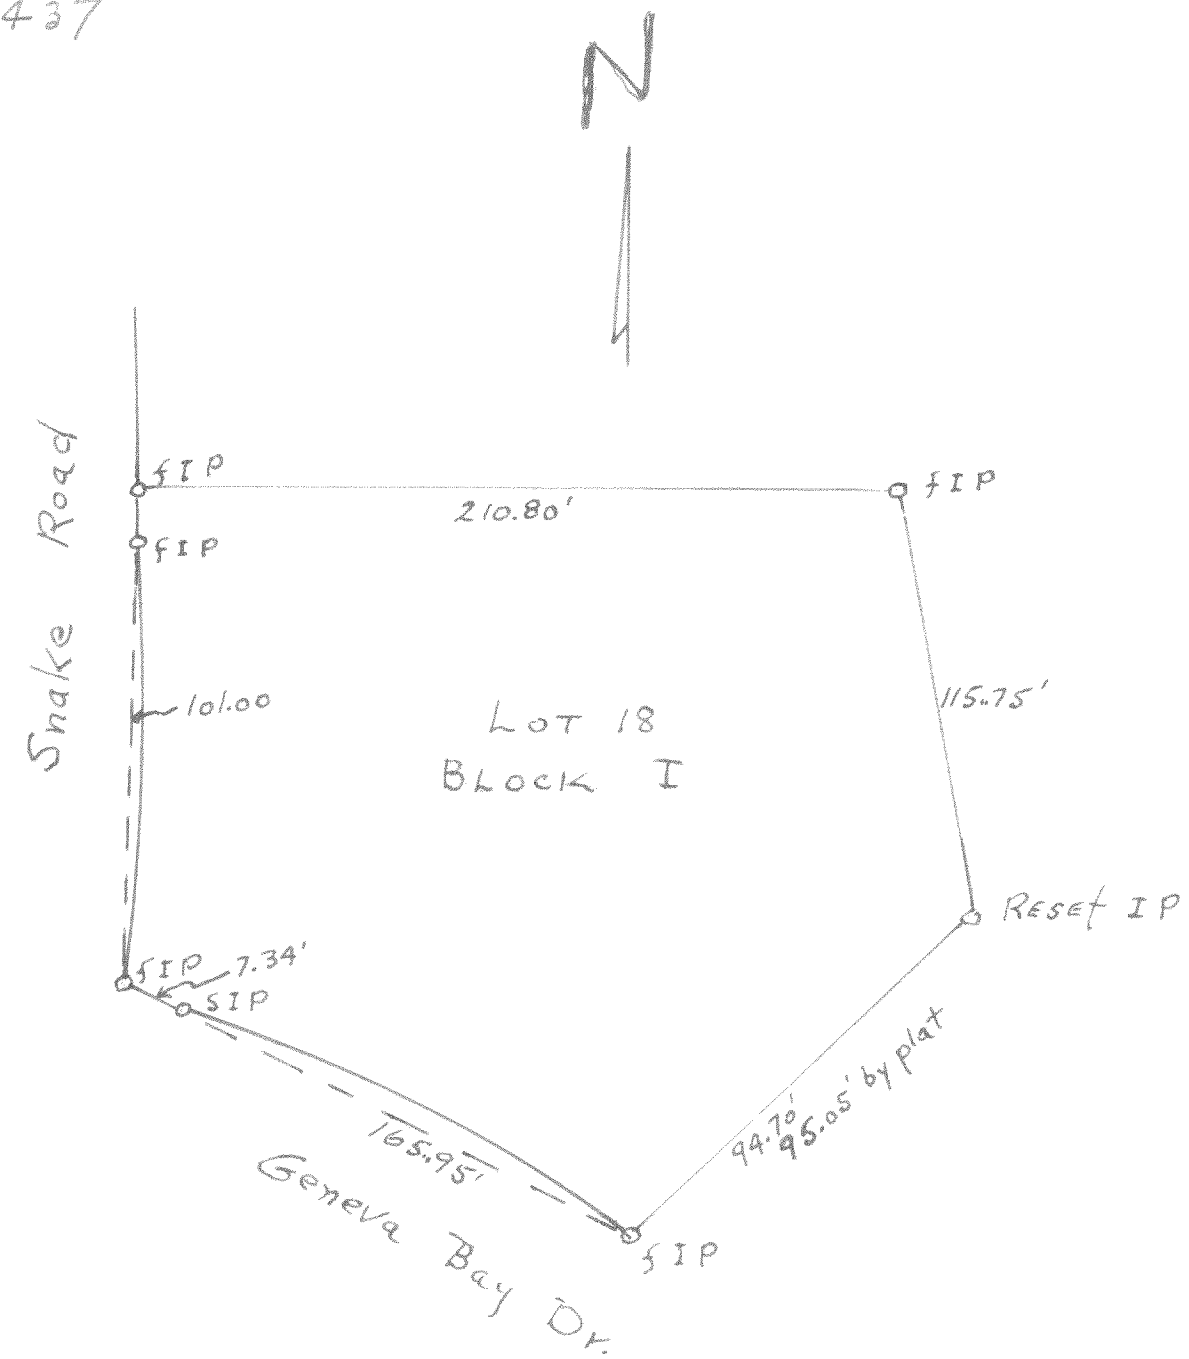


Survey of Lot 18 of Geneva
Bay Estates in Section 35,
T2N R17E (Block I)

Feb. 1963

Land & Survey
County Surveyor

4438

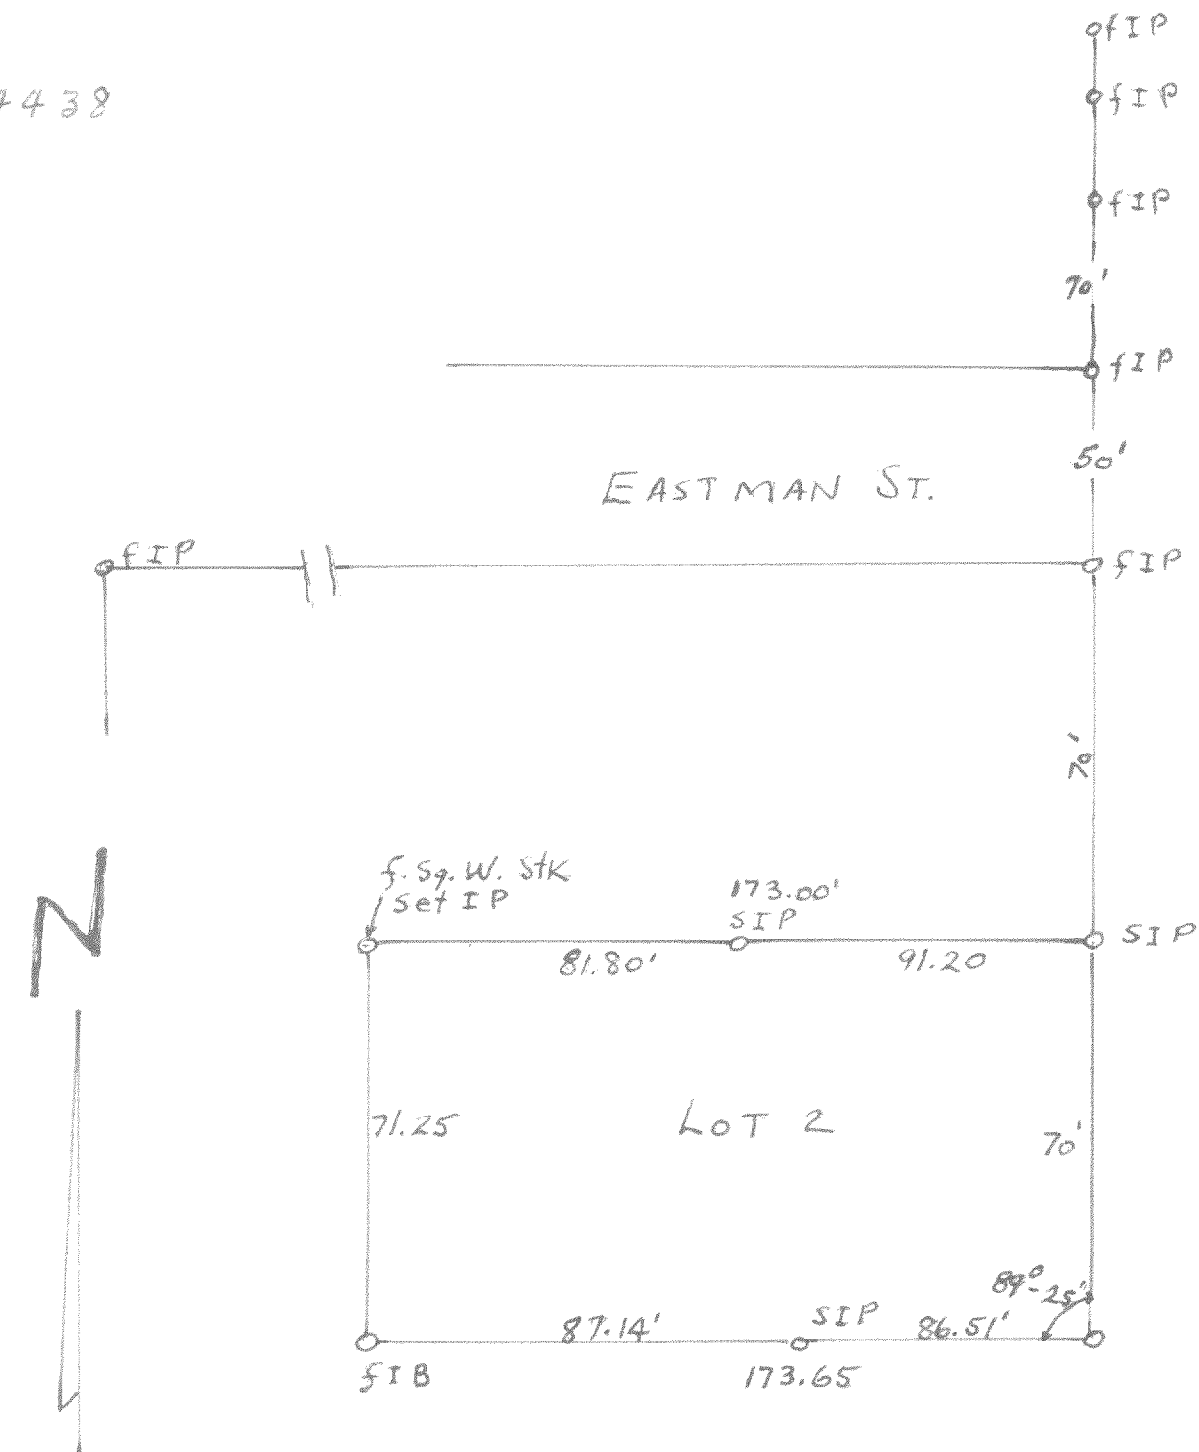

Survey of Lot 2 of Block 4
of Zenda

June 1963

Donald L Jensen
County Surveyor