


4444

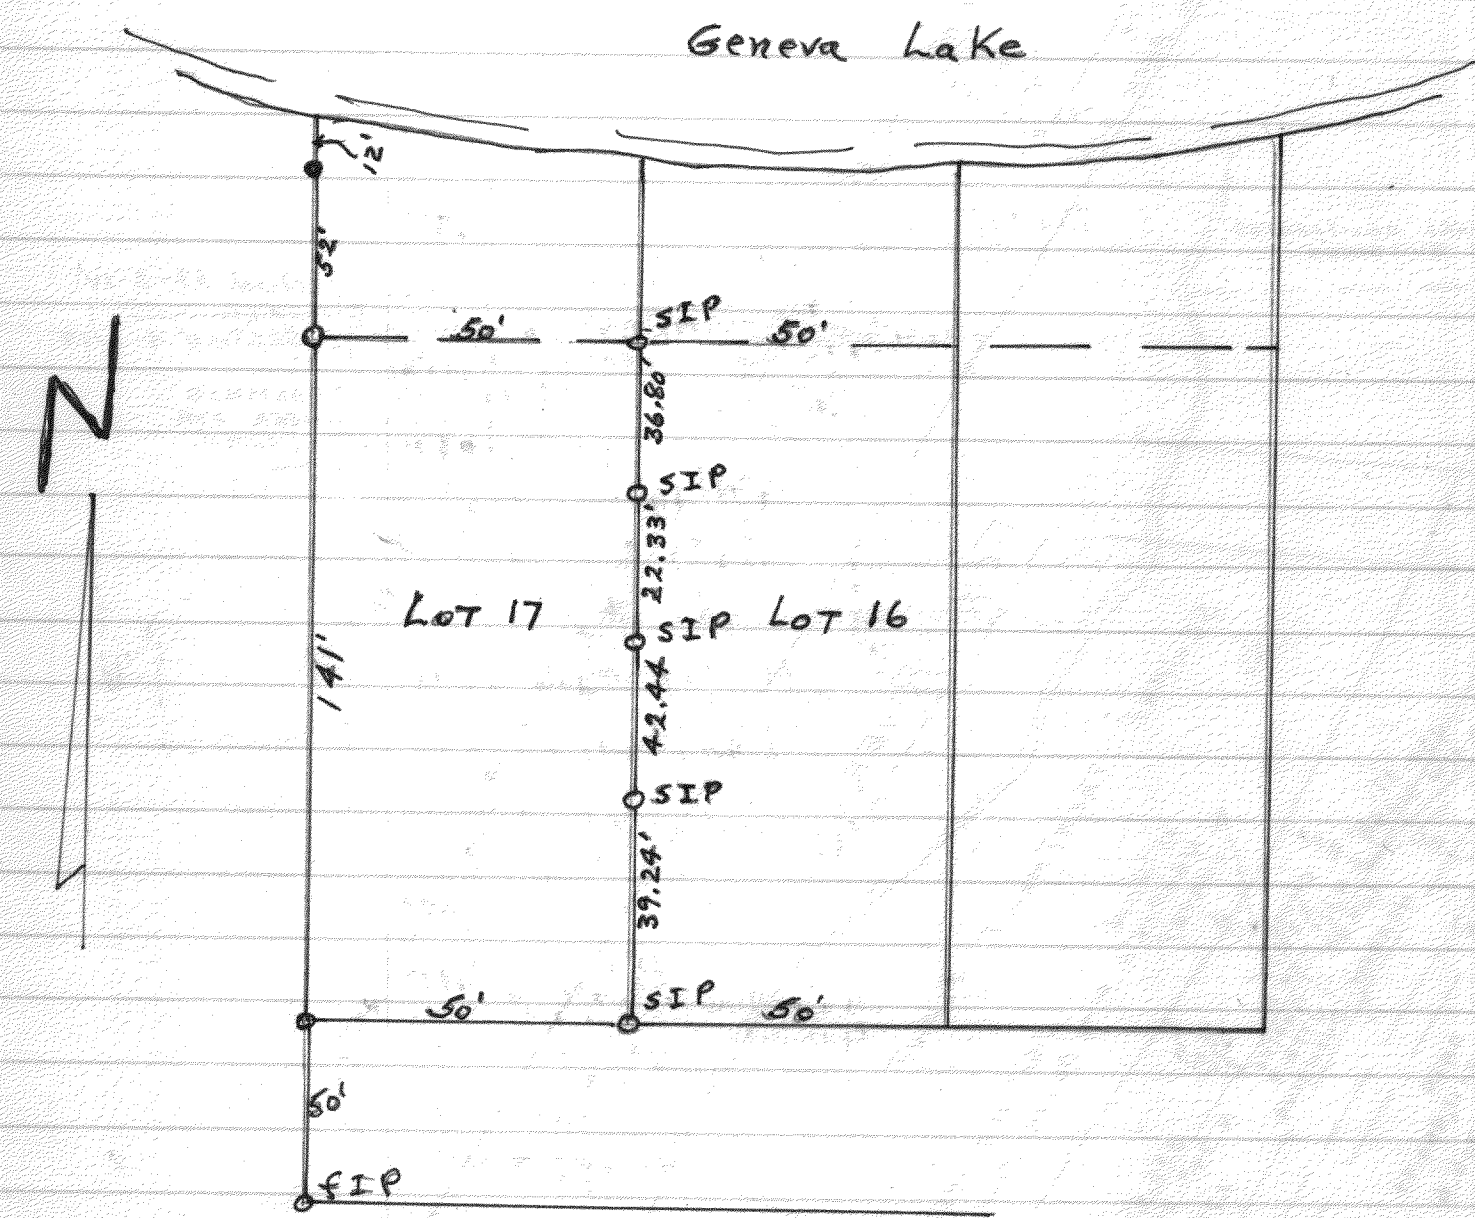

Plat of survey of Lot line
between Lots 16 & 17 of Lake
Geneva Highlands.

April 21, 1962

Lloyd J. Jensen
County Surveyor

4445

PLAT OF SURVEY OF
LOT 1, BLOCK 16 ORIGINAL PLAT
VILLAGE OF MUKWONAGO, WAUKESHA
COUNTY, WISCONSIN.

MARCH 7, 1964
MAY 18, 1969

Lloyd J. Jensen
SURVEYOR

NOTE:

CHECK WATER DEPT. FOR RECENT WATER
MAIN INSTALLATION ON WEST PART OF
MAIN STREET. CHECK VILLAGE BUILDING
INSPECTOR FOR CURRENT ZONING AND
BUILDING CODE.

