


#4450

PLAT OF SURVEY OF
U.P. 159 NW 1/4 SEC. 5
TAN RISE CITY OF
WHITEWATER, WAL. CO. WIS.
JUNE 1962

Floyd & Jensen
CO. SURVEYOR

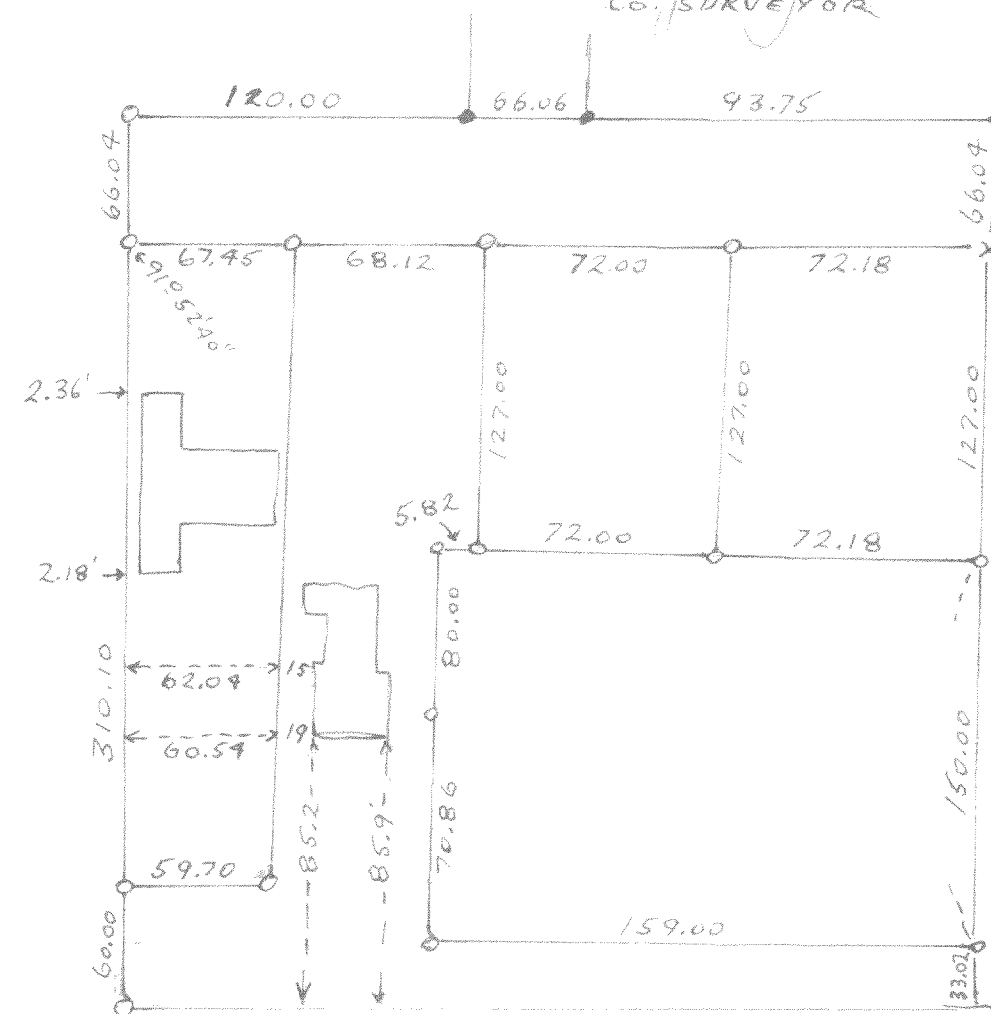

#4451

PLAT OF SURVEY OF
LAND LOCATED IN CONGER
SUBD. WHITEWATER, WAL. CO. WIS.
1964

Floyd & Jensen
CO. SURVEYOR

