


4454

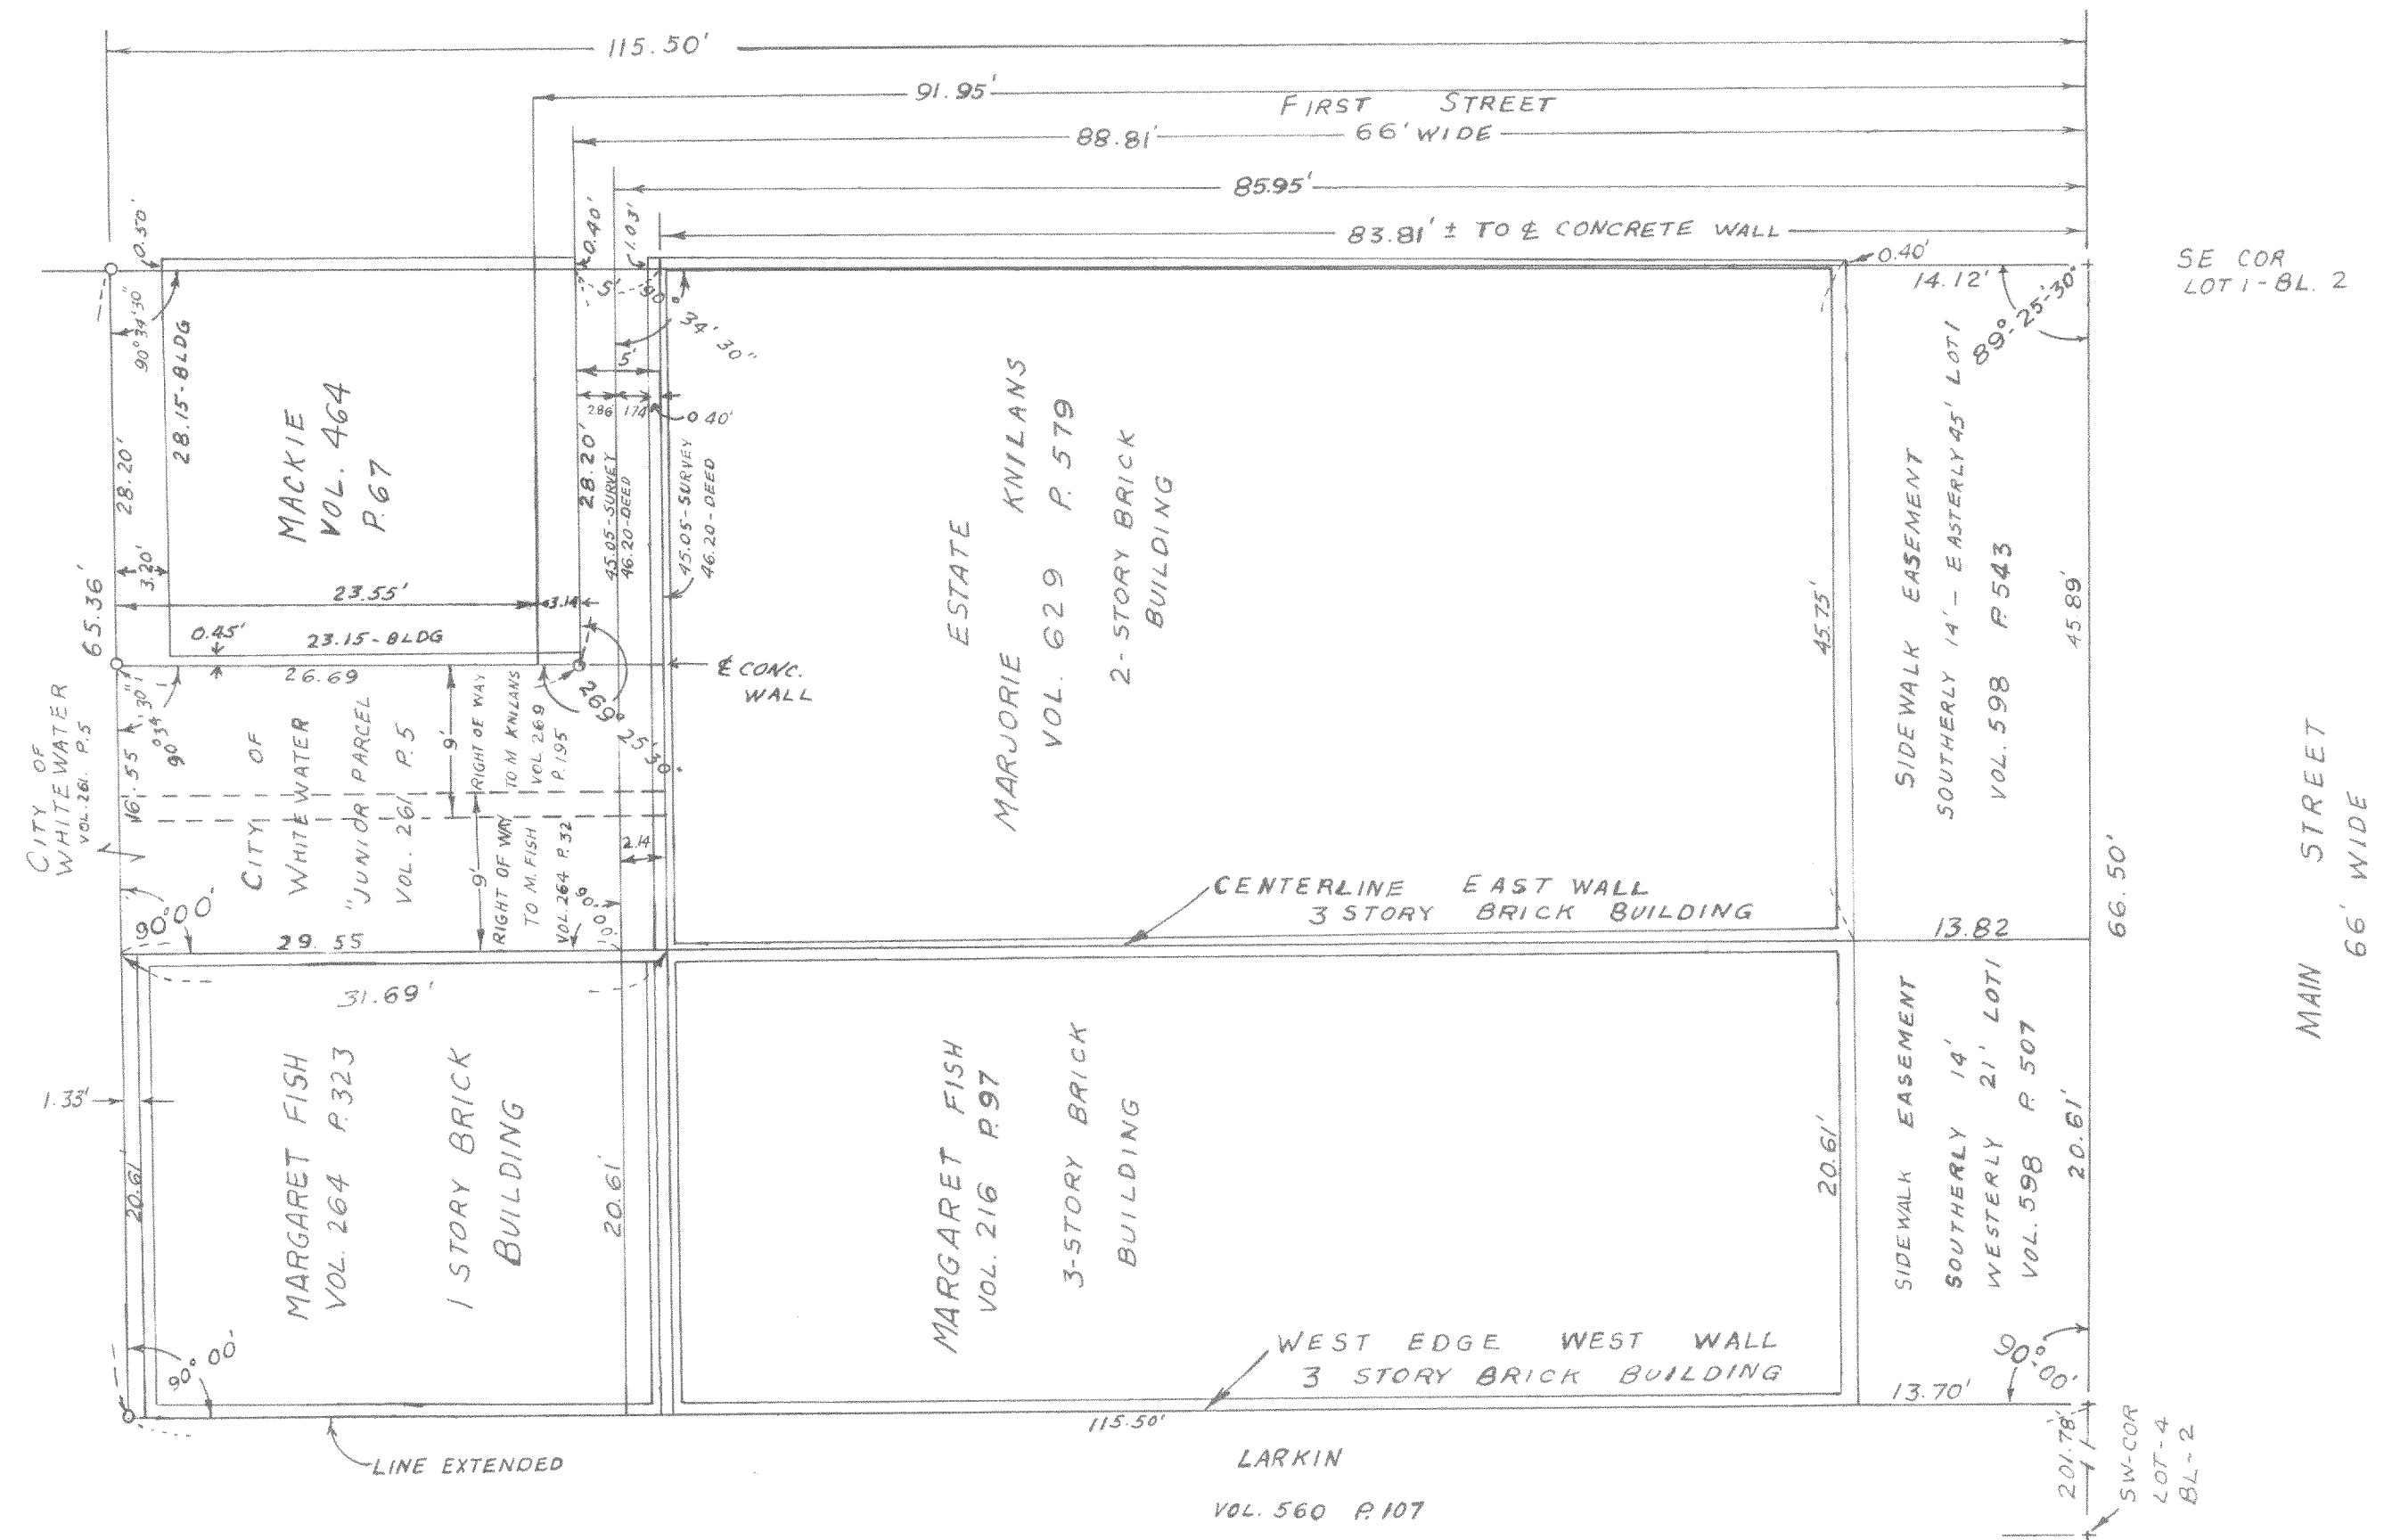

LEGEND

- + - CHISEL MARK IN SIDEWALK
- o - IRON STAKE

PART OF LOT 1, BLOCK 2		
ORIGINAL PLAT - WHITEWATER,		
WALWORTH COUNTY, WISCONSIN		
SCHULTZ BROS. STORE		
DRAWN BY	JENSEN & JOHNSON CIVIL ENGINEERS ELKHORN, WIS. DATE: MARCH 18, 1966	SCALE
CHECKED BY		REVISED
APPROVED BY		SHEET NO OF