



588 # 4455

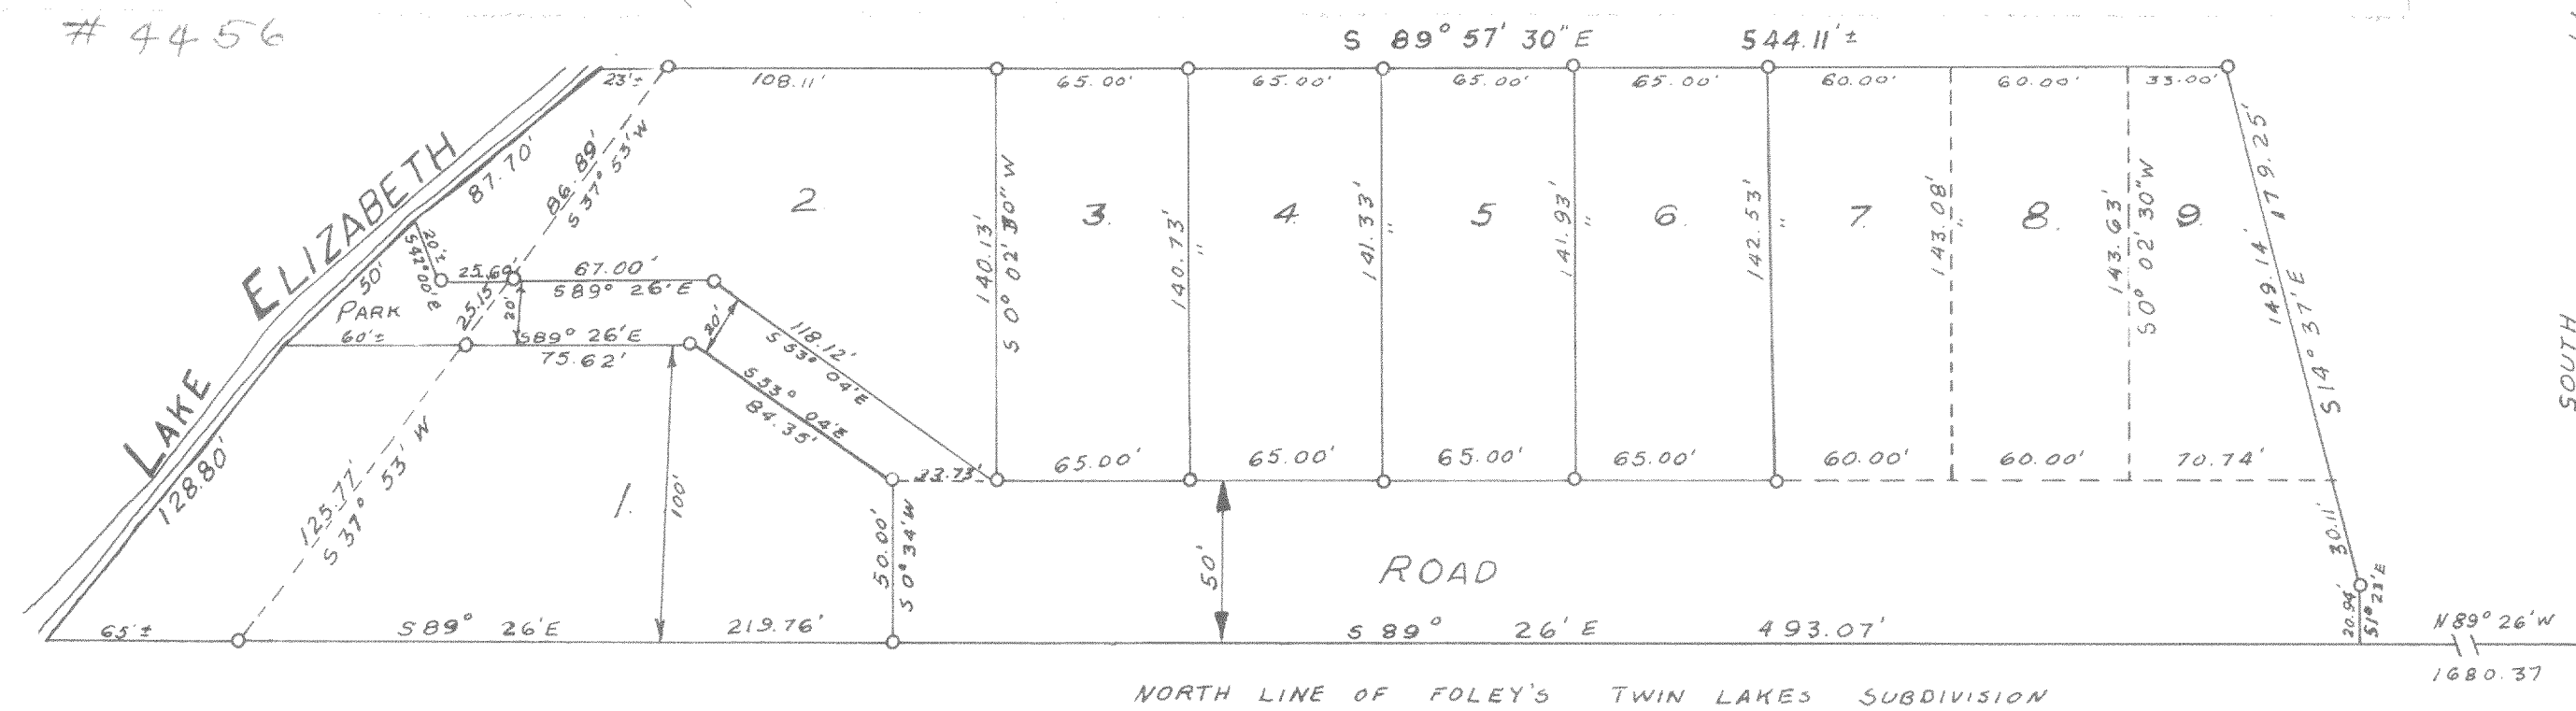

O - DENOTES IRON PIPE

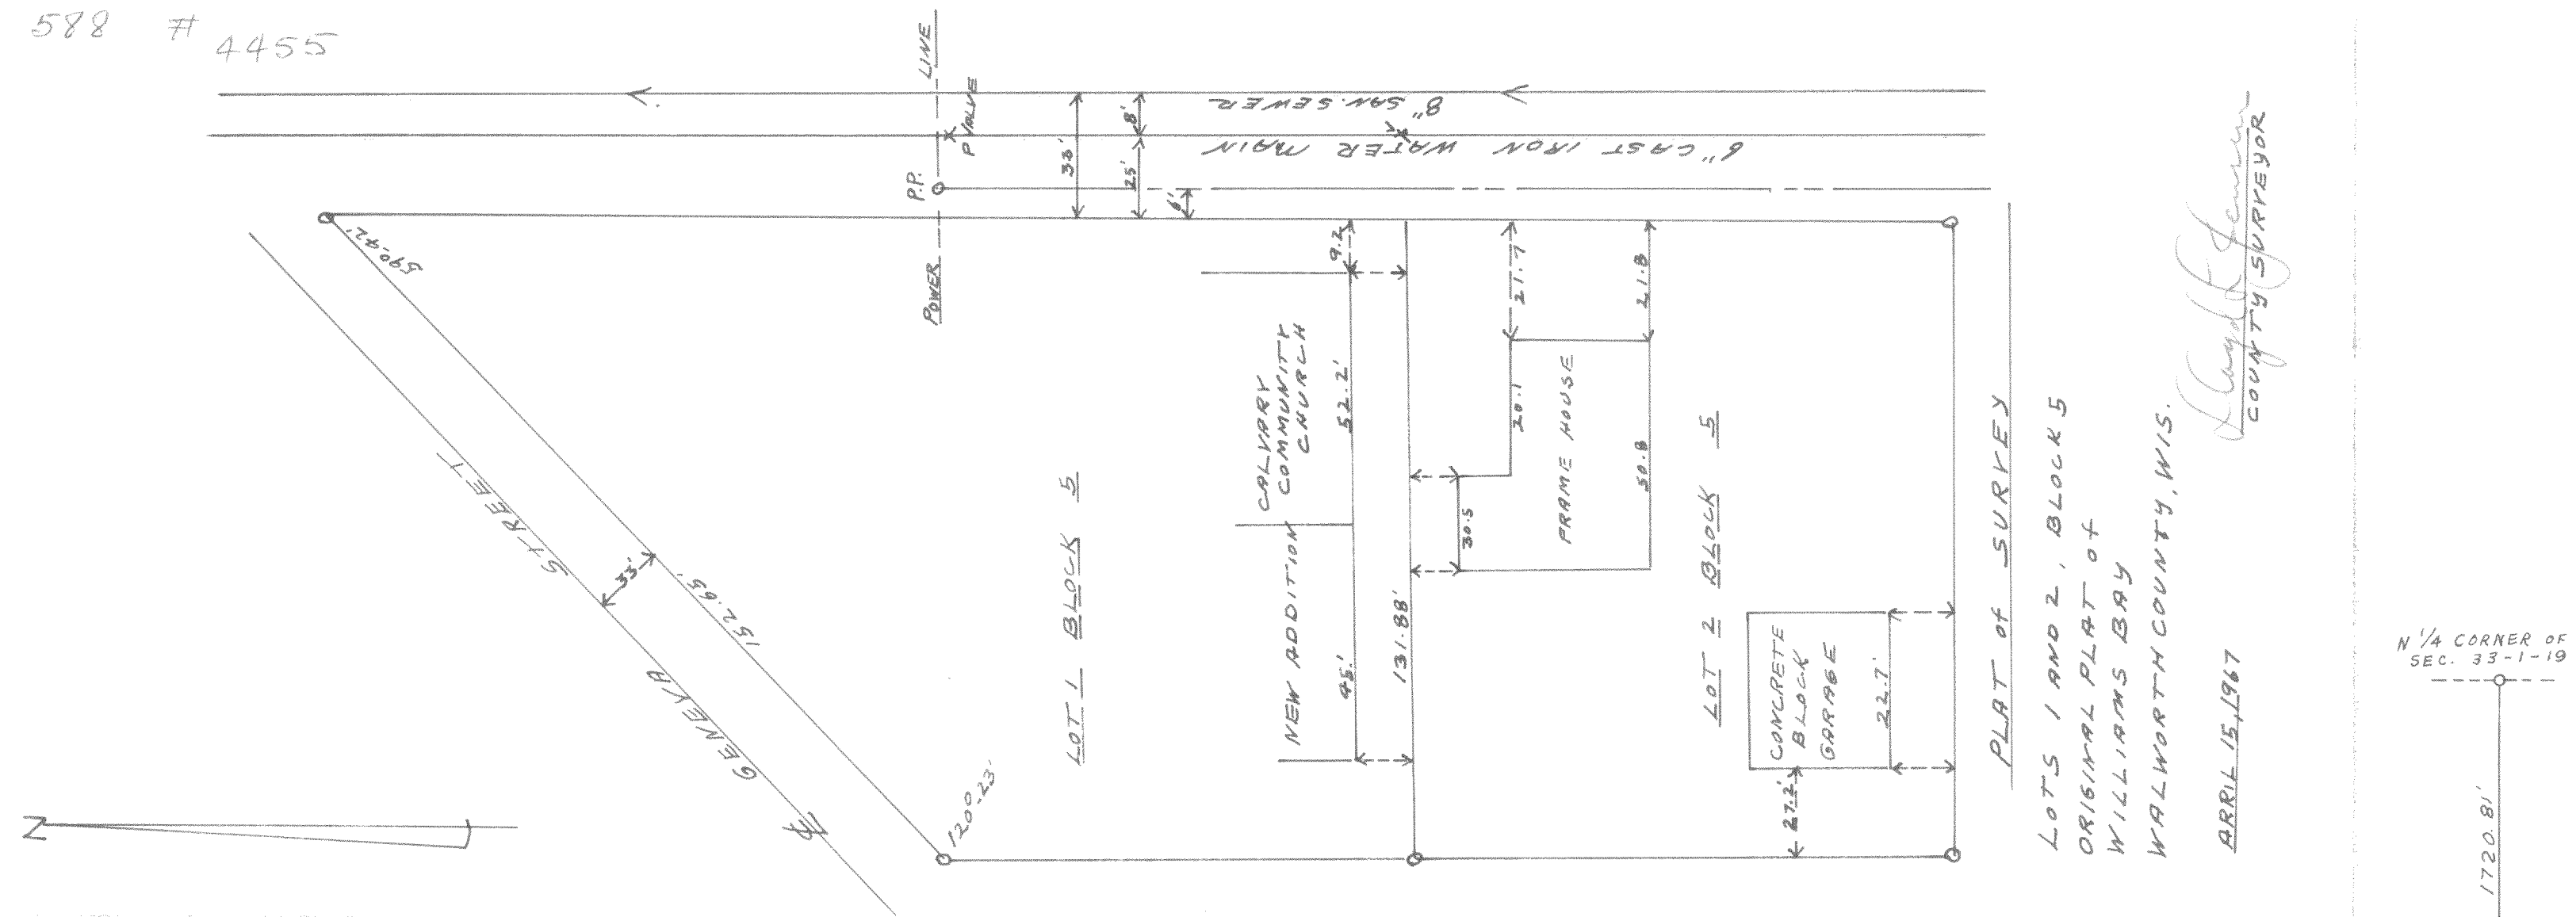

NW 1/4 SECTION 33 T1N R19E  
KENOSHA COUNTY, WISCONSIN

PLAT OF SURVEY

Clayton Jensen  
SURVEYOR

AUGUST 1966