


4457

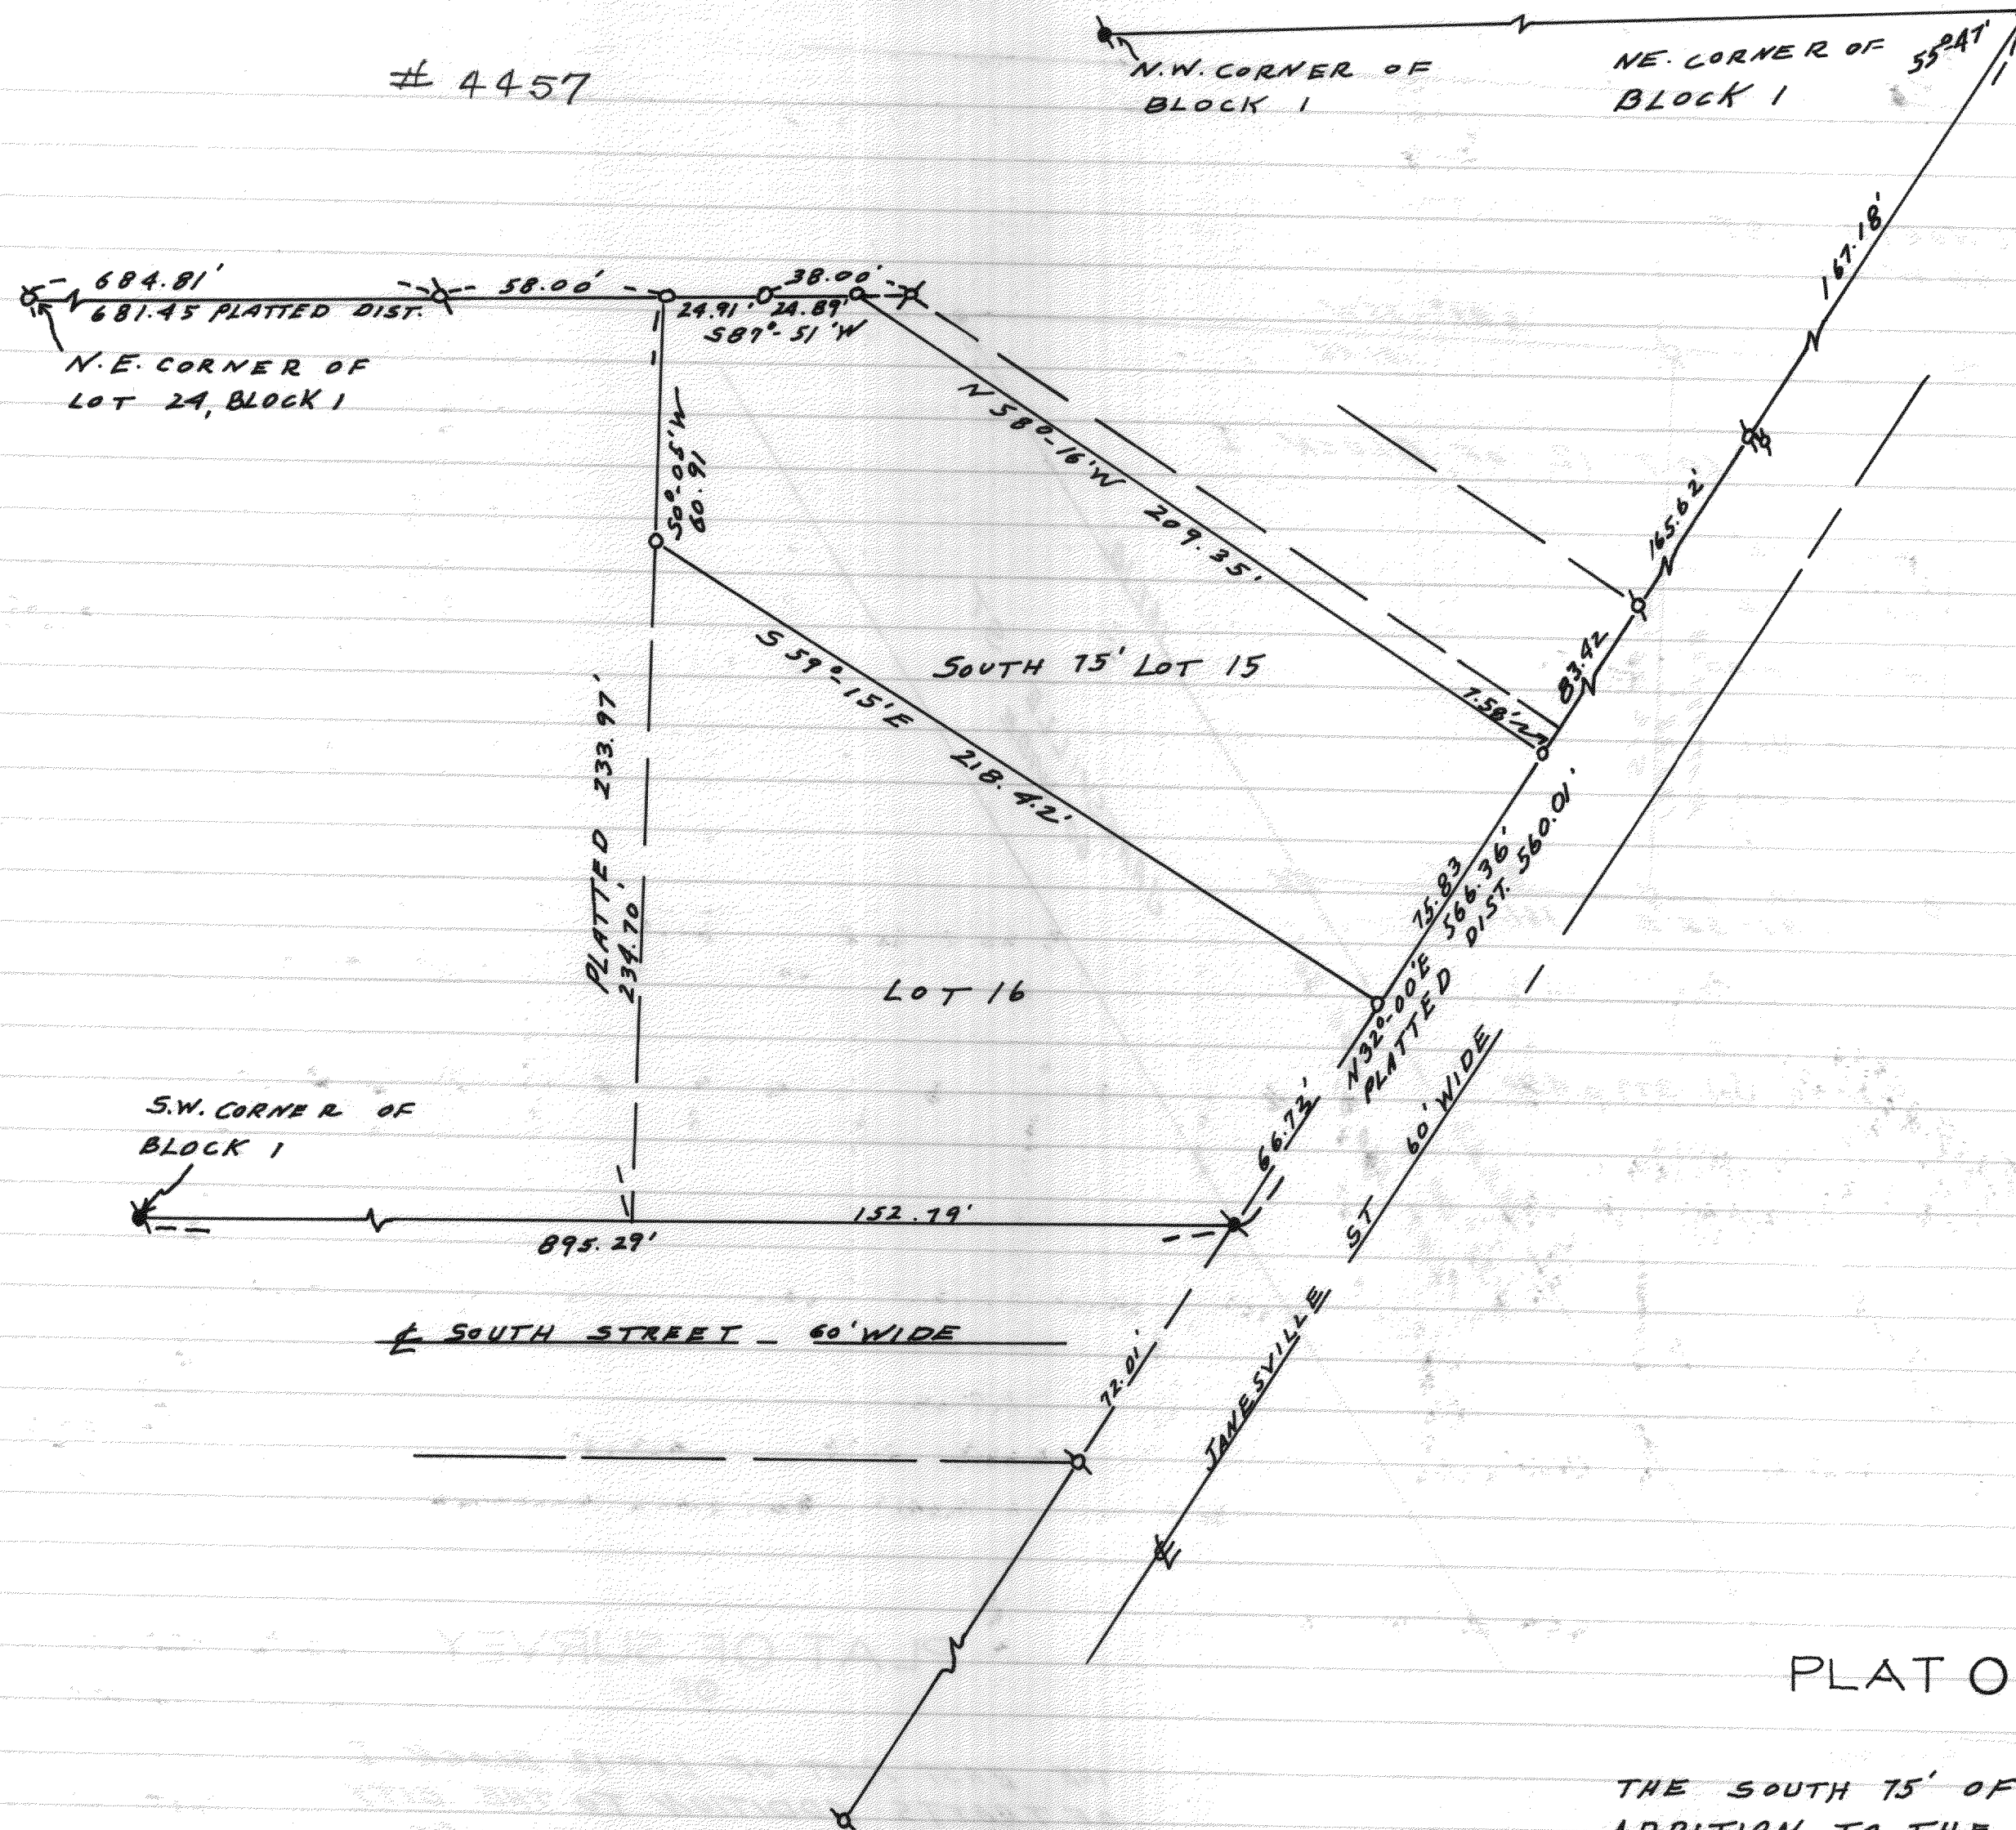

PLAT OF SURVEY
OF

THE SOUTH 75' OF LOT 15, BLK 1, TRATTS
ADDITION TO THE CITY OF WHITEWATER,
WALWORTH COUNTY, WIS.

JULY 1966

Lloyd J. Jensen
SURVEYOR