


590

4458

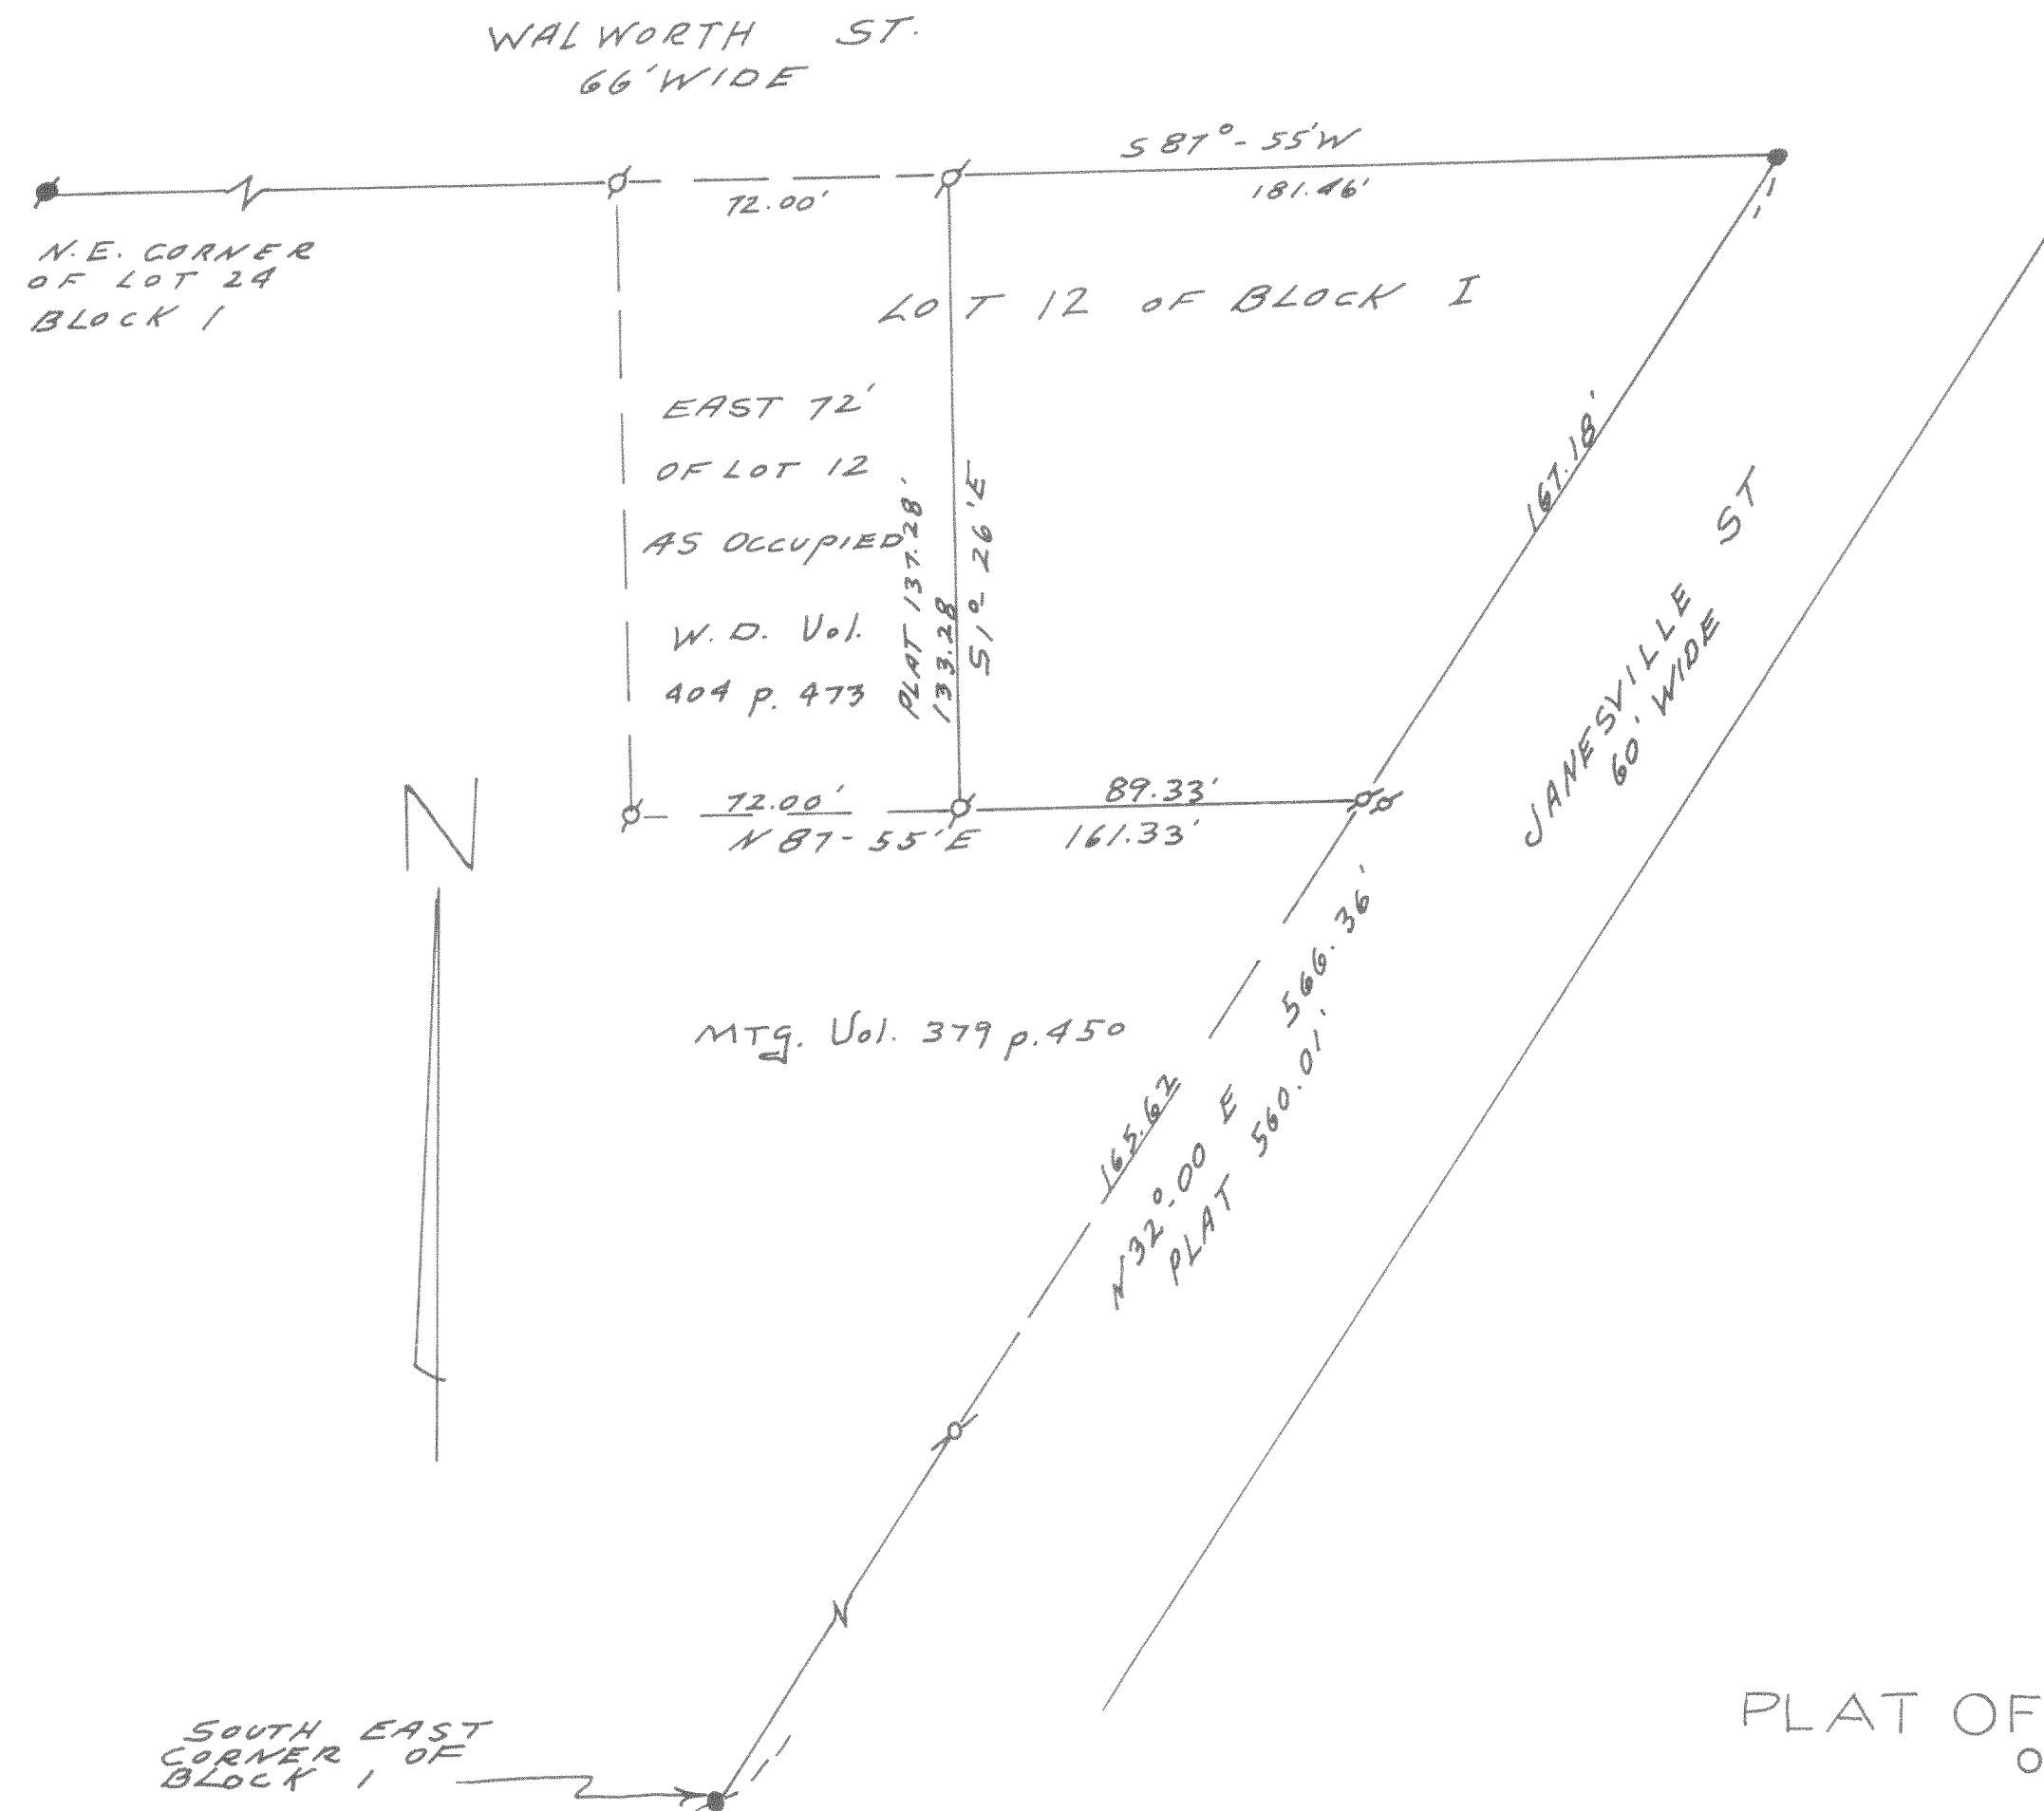

PLAT OF SURVEY OF

THE EAST PART OF LOT 12 BLOCK I
OF TRATTS ADDITION TO THE CITY
OF WHITEWATER, WAL. CO. WIS.

JULY 1966

Floyd F. Jensen
SURVEYOR