


4480

PLAT OF SURVEY

OF

LOT 185 AND LOT 185 1/2
CEDAR POINT PARK SUBDIVISION
WILLIAMS
M^S KINLEY COURT BAY, WISCONSIN.

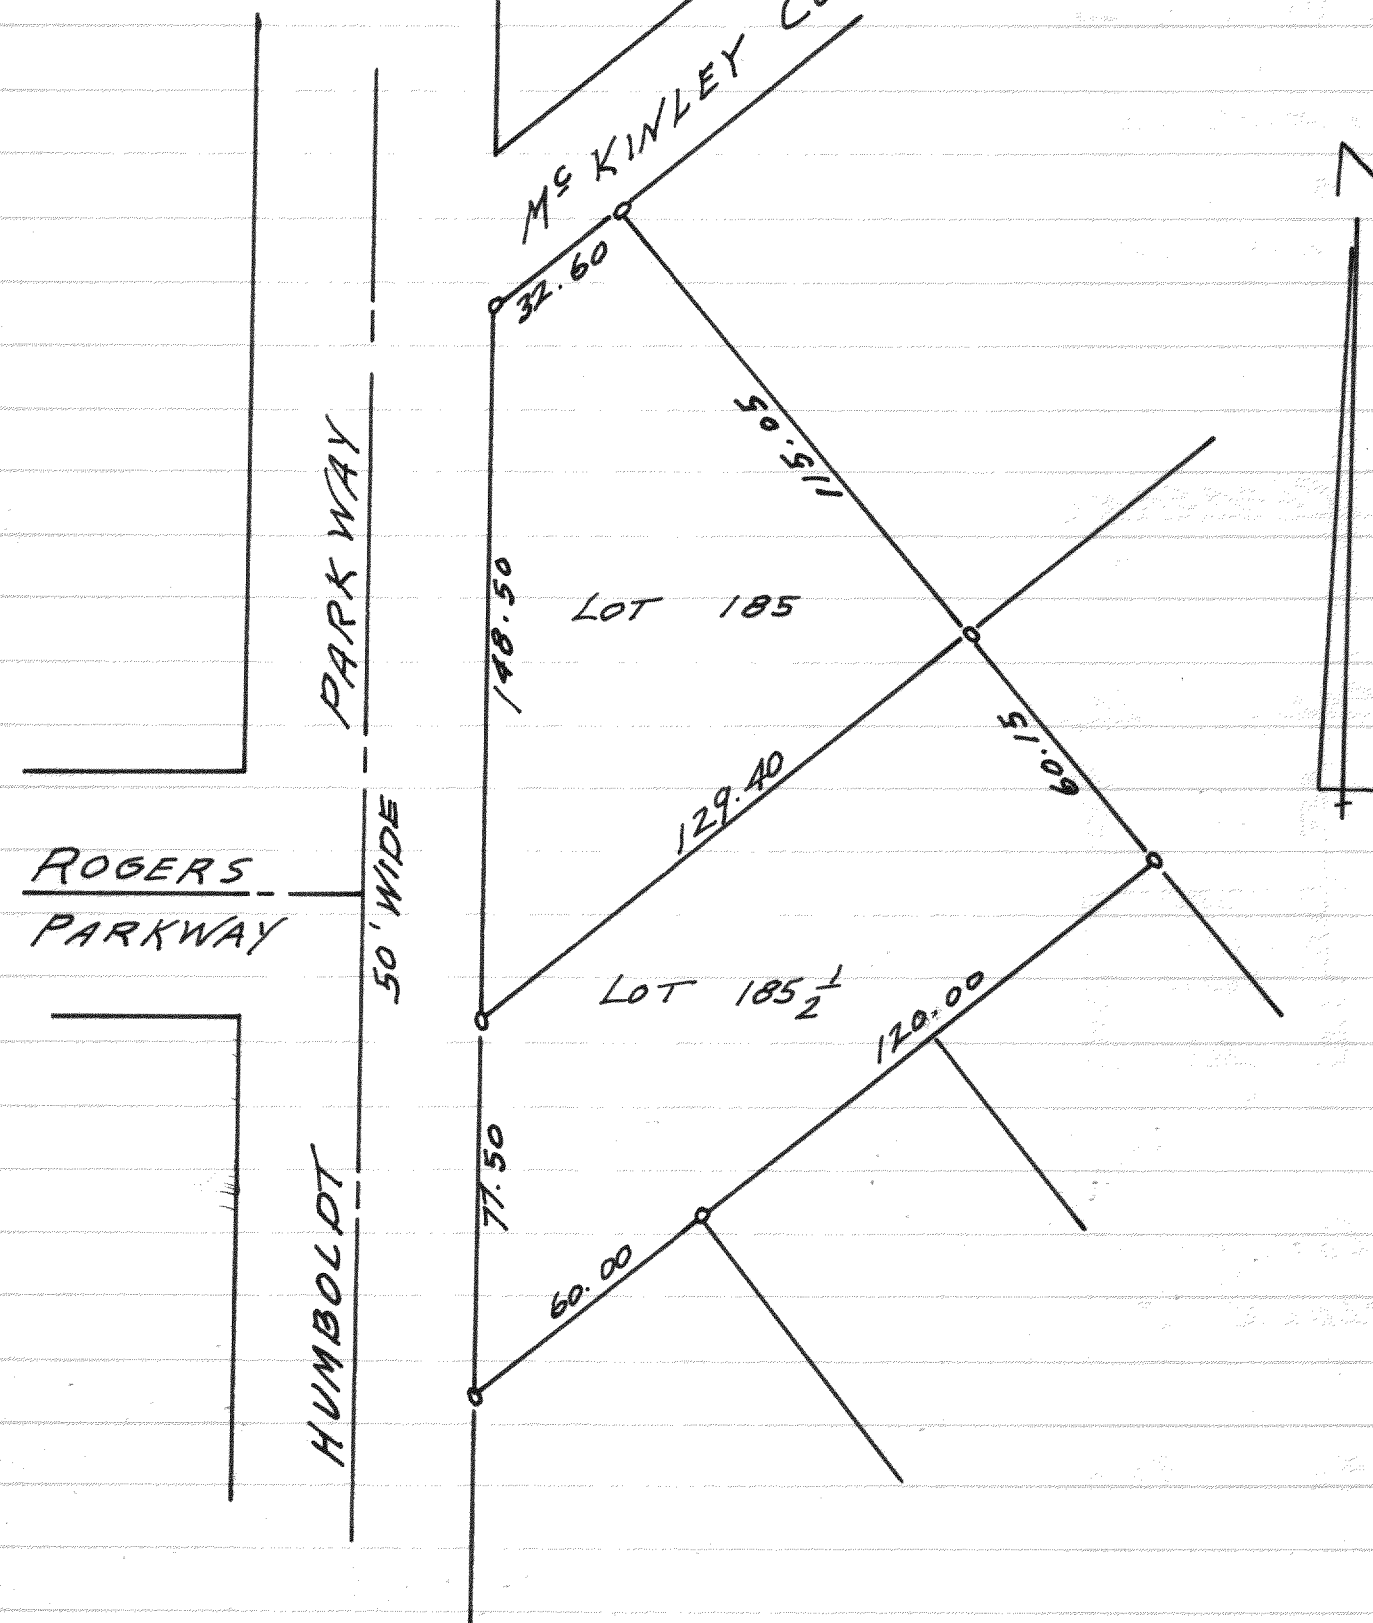

AUG. 1966


Lloyd L Jensen
COUNTY SURVEYOR

4481

PLAT OF SURVEY

OF

Lots 1-2-5-6 and
the North 15' Lot 9
of Fearlows Subdivision
located in the NE 1/4
Section 24, T4N-R17E Lake
Walworth County
Wisconsin.

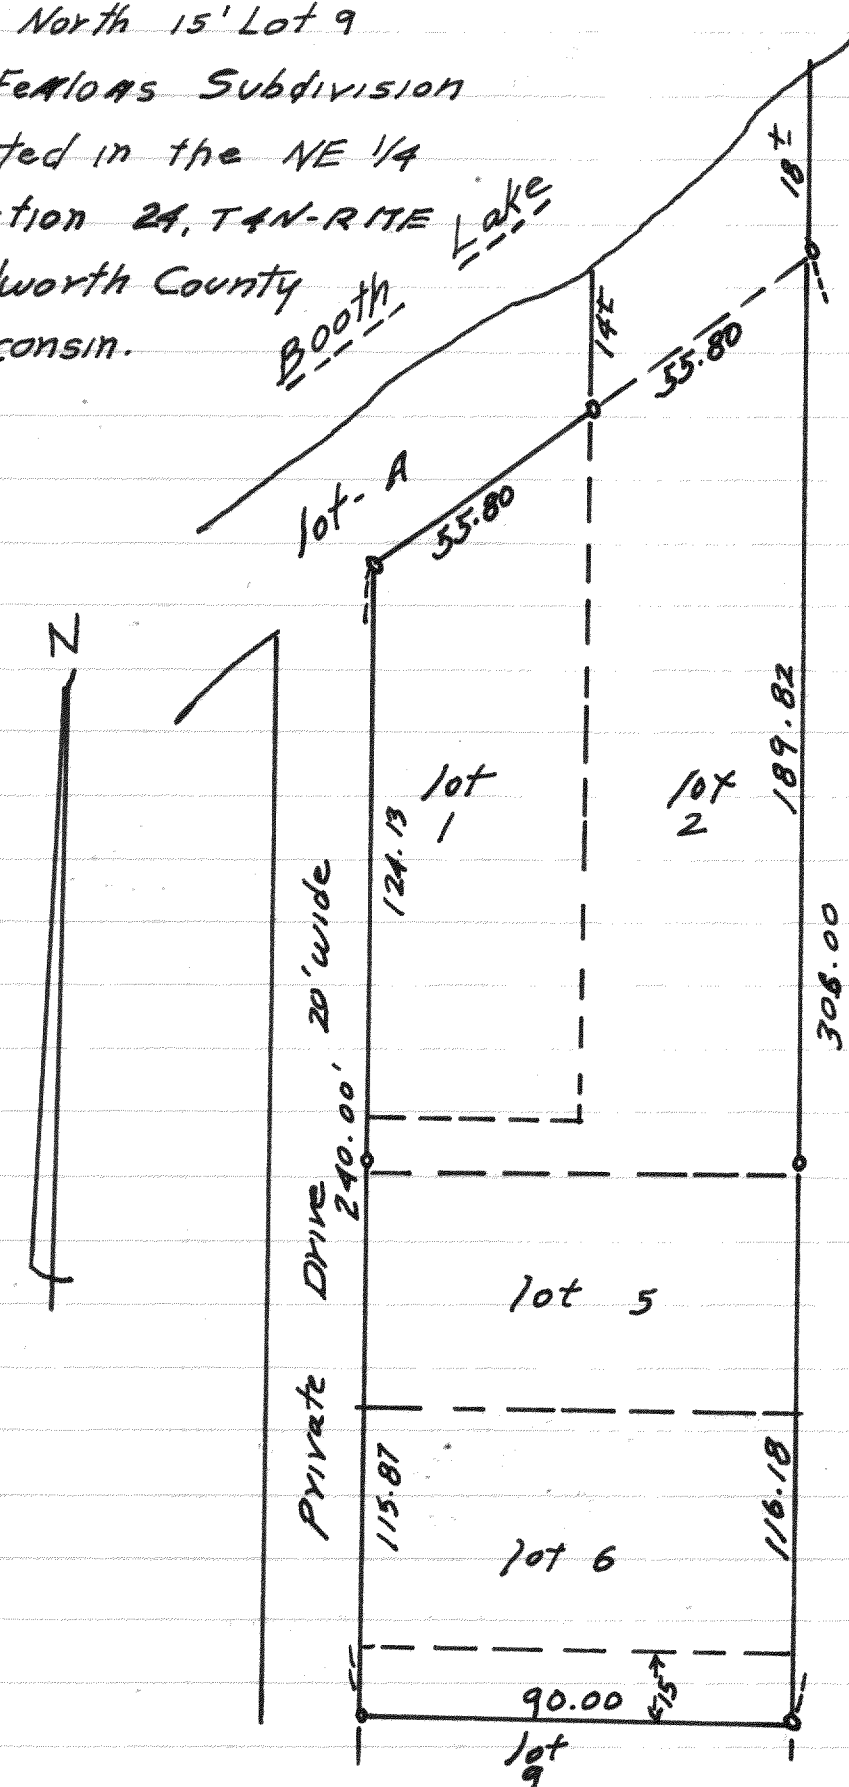

May 12, 1966

Lloyd L Jensen
COUNTY SURVEYOR