




#2886

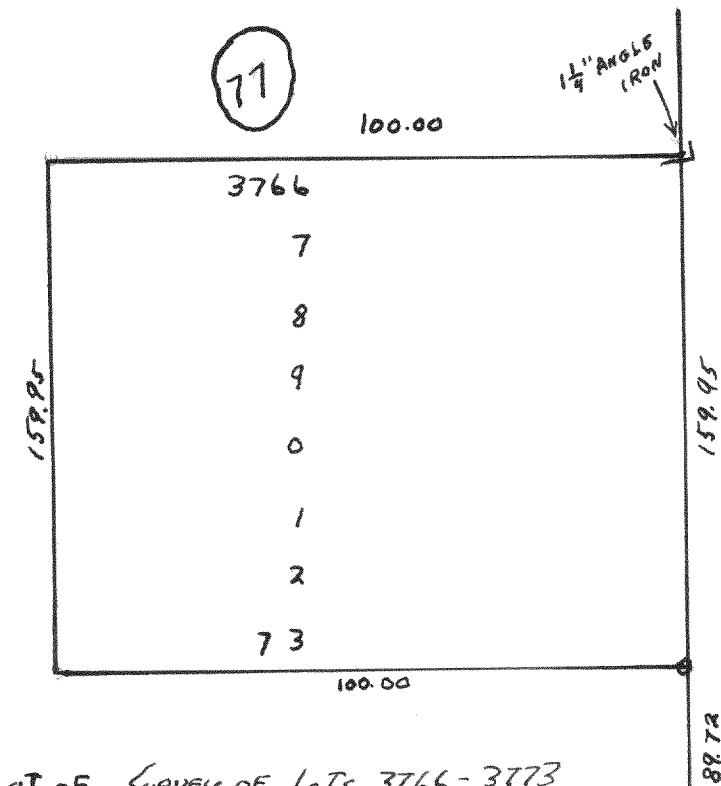


PLAT OF SURVEY OF LOTS 3766-3773
BLOCK 77 PELL LAKE T1N R12E
WAUKWORTH COUNTY WISCONSIN
JULY 1954 LLJ CS DAISY

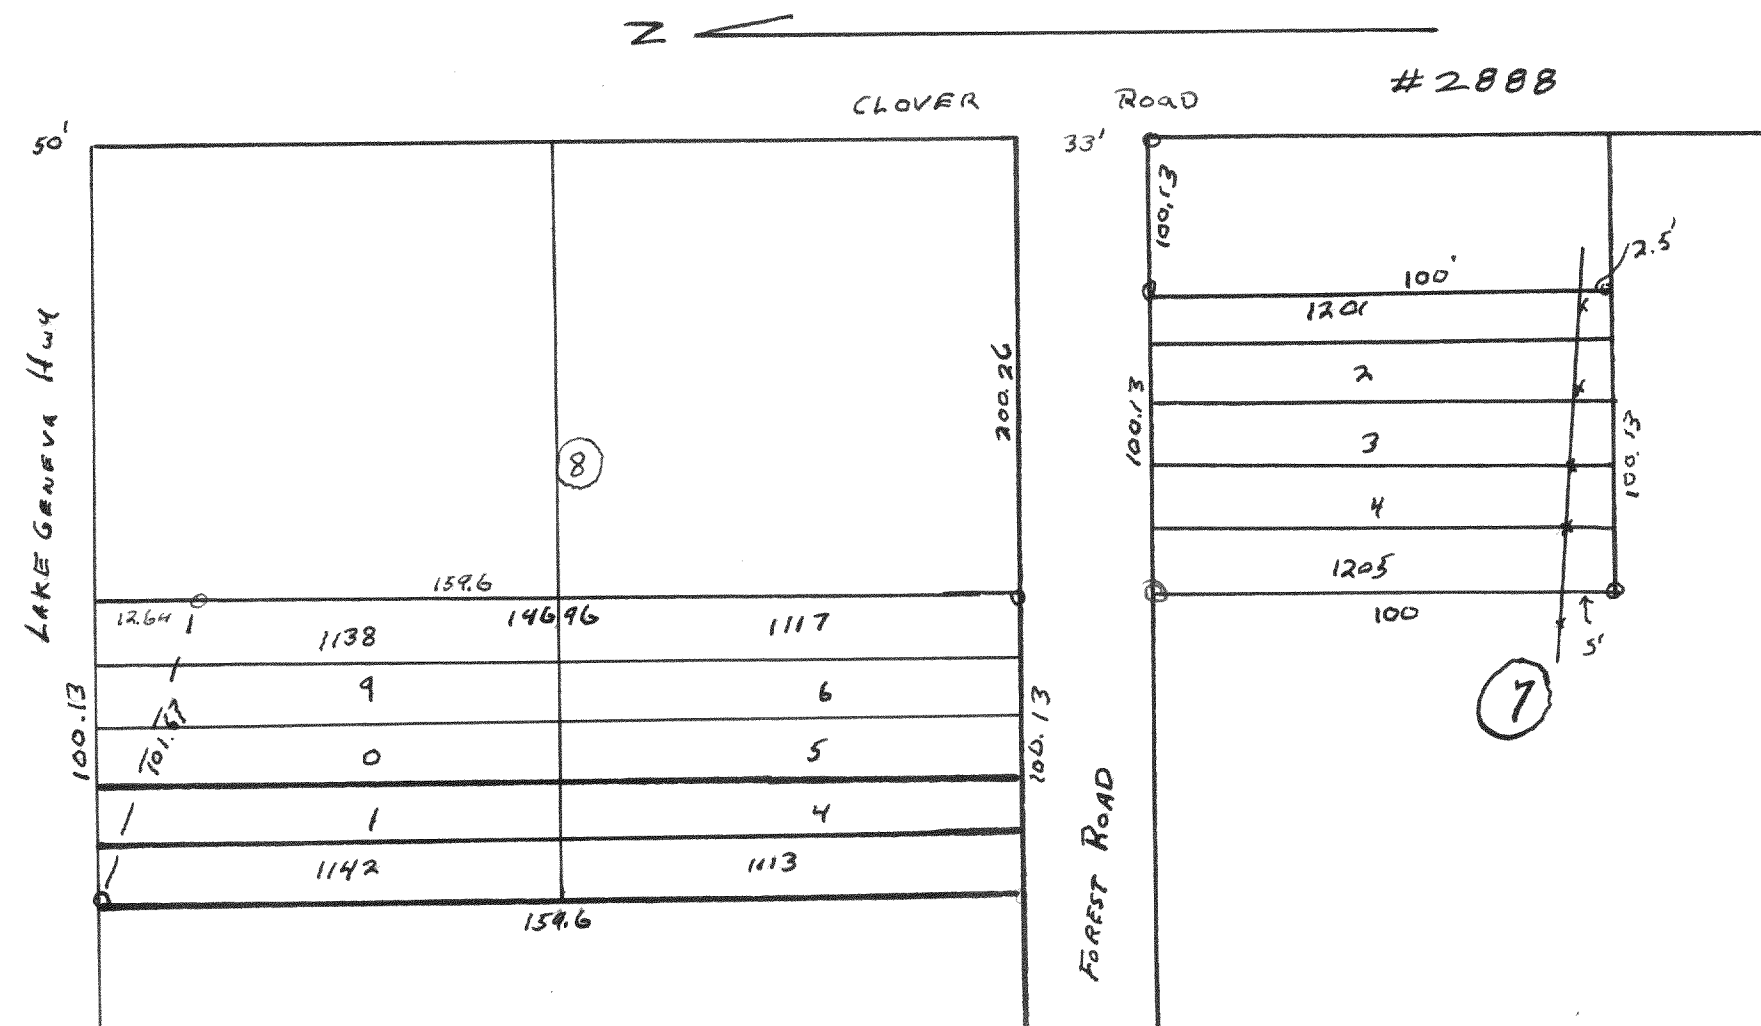

Plot of Survey of Lots 1113-1117 and 1138-1142 Block 8 and
 Lots 1201-1205 Block 7 Pell Lake Highland Twp RISE
 WAH WORTH COUNTY WISC
 Nov 1954

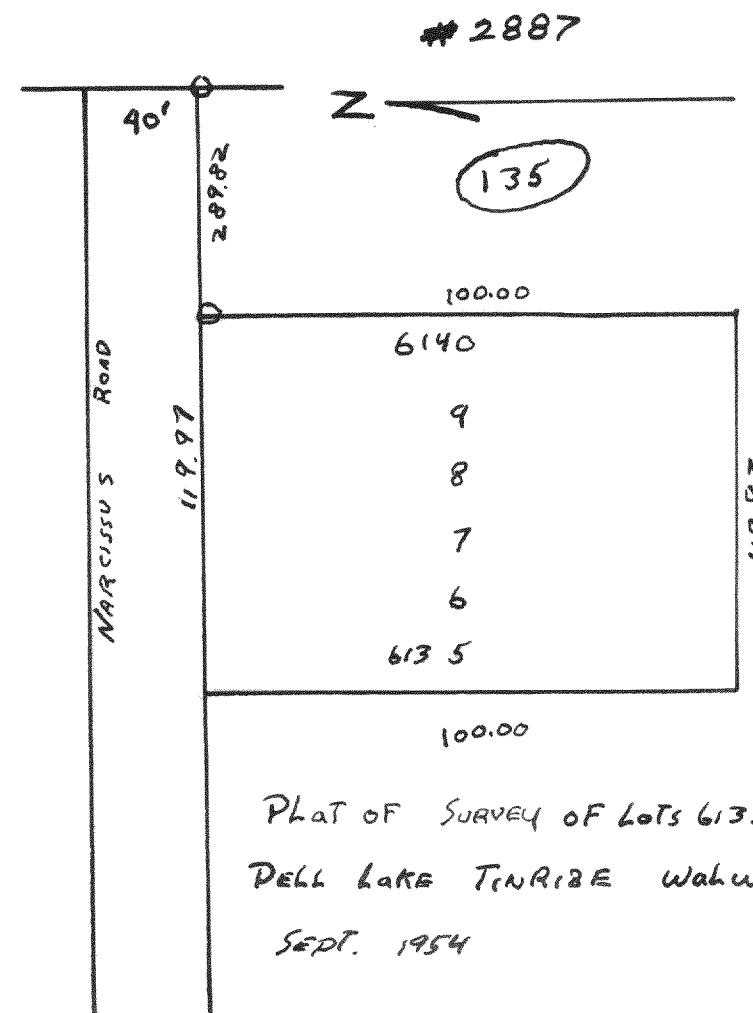

PLAT OF SURVEY OF LOTS 6135-6140 BLOCK 135
DELL LAKE TENNISE WAHWAH COUNTY WISC
SEPT. 1954 22 J CS

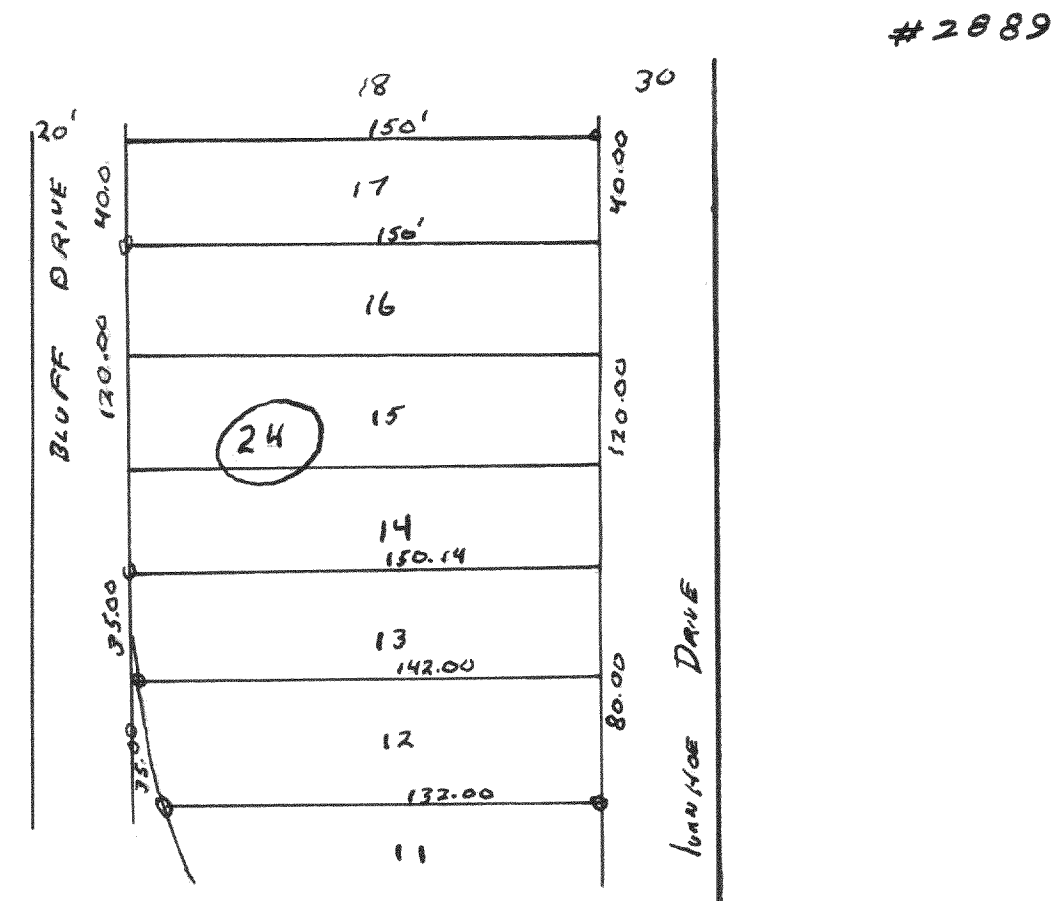

PLAT OF SURVEY OF LOTS 12, 13 AND 17 Block 24
LAKE IANNOE RESORT TNR RISE Wauwatosa
COUNTY Wisconsin
Nov 1954