



62-A

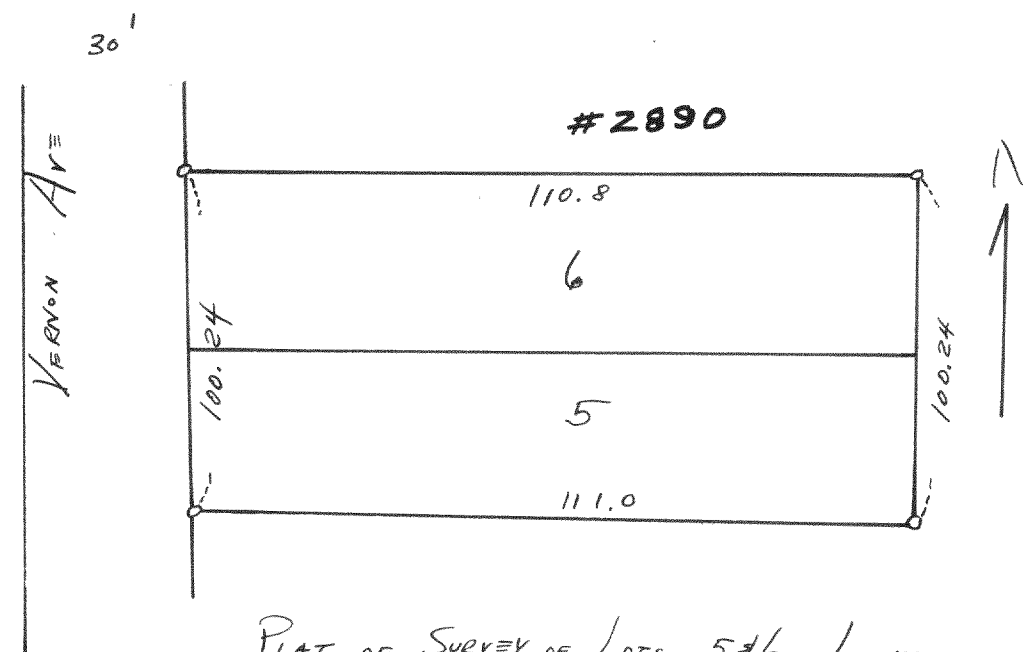

PLAT OF SURVEY OF LOTS 5 & 6 LOCKWOODS SUBD
VILLAGE OF W^{MS} BAY WALWORTH COUNTY, WISC

AUG 1954


Lloyd L Jensen
County Surveyor

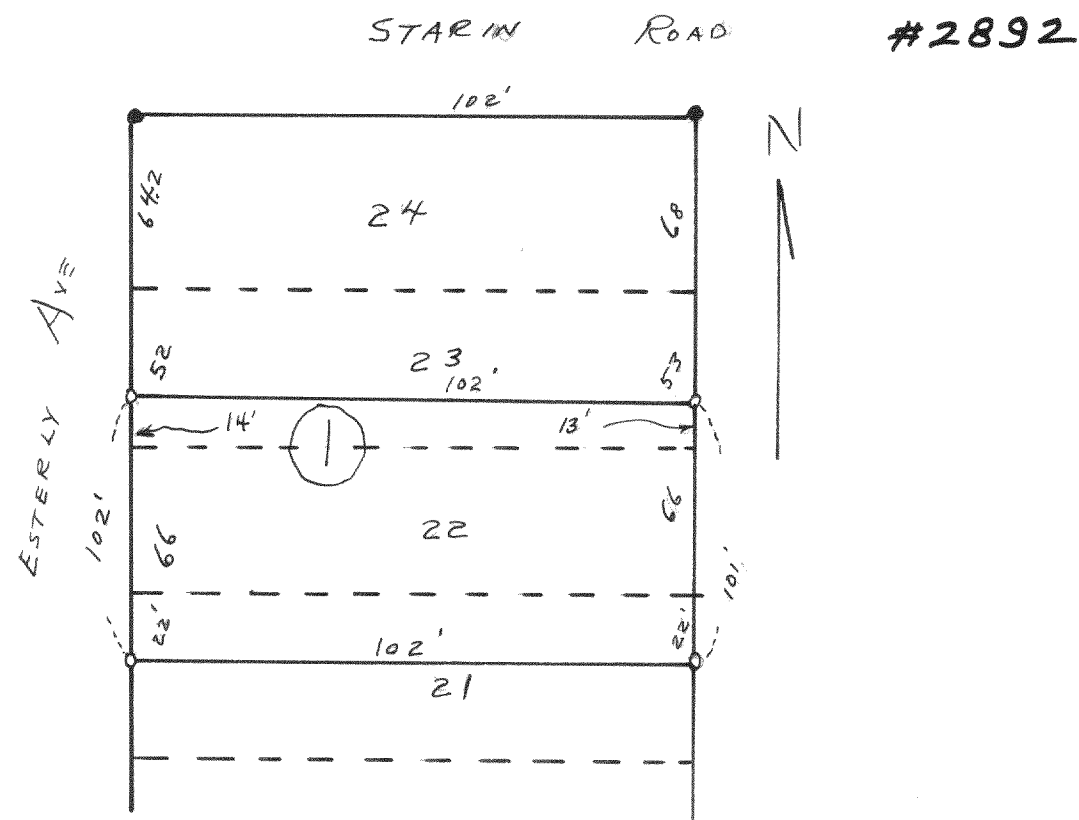

PLAT OF SURVEY OF LOT 22 AND PART OF LOTS 21 AND 23
FISH & JOHNSON ADD'N TO THE CITY OF WHITEWATER
WALWORTH COUNTY, WISCONSIN

MAY 1954


Lloyd L Jensen
County Surveyor

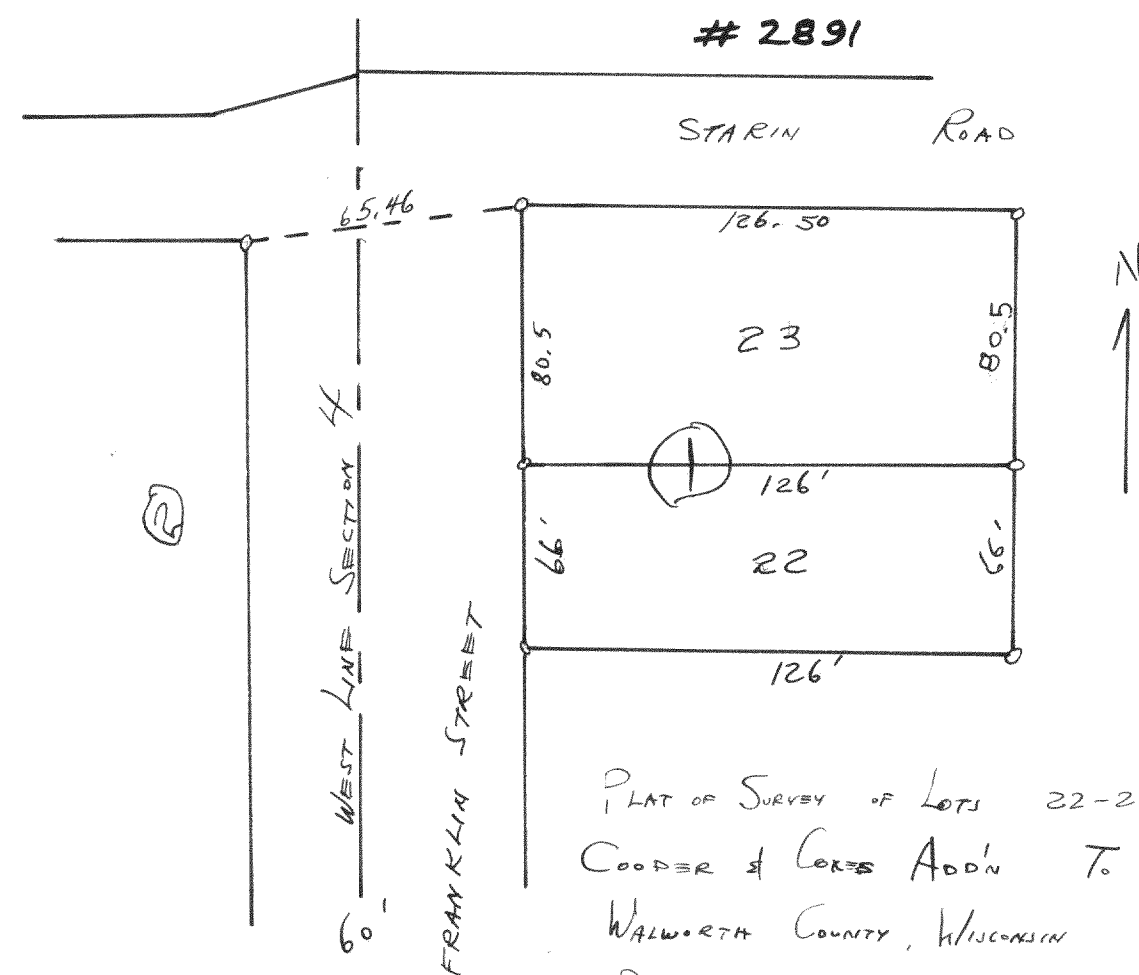

PLAT OF SURVEY OF LOTS 22-23 BLOCK 1
COOPER & CORSE ADD'N TO THE CITY OF WHITEWATER
WALWORTH COUNTY, WISCONSIN

DEC 1954

Lloyd L Jensen
County Surveyor

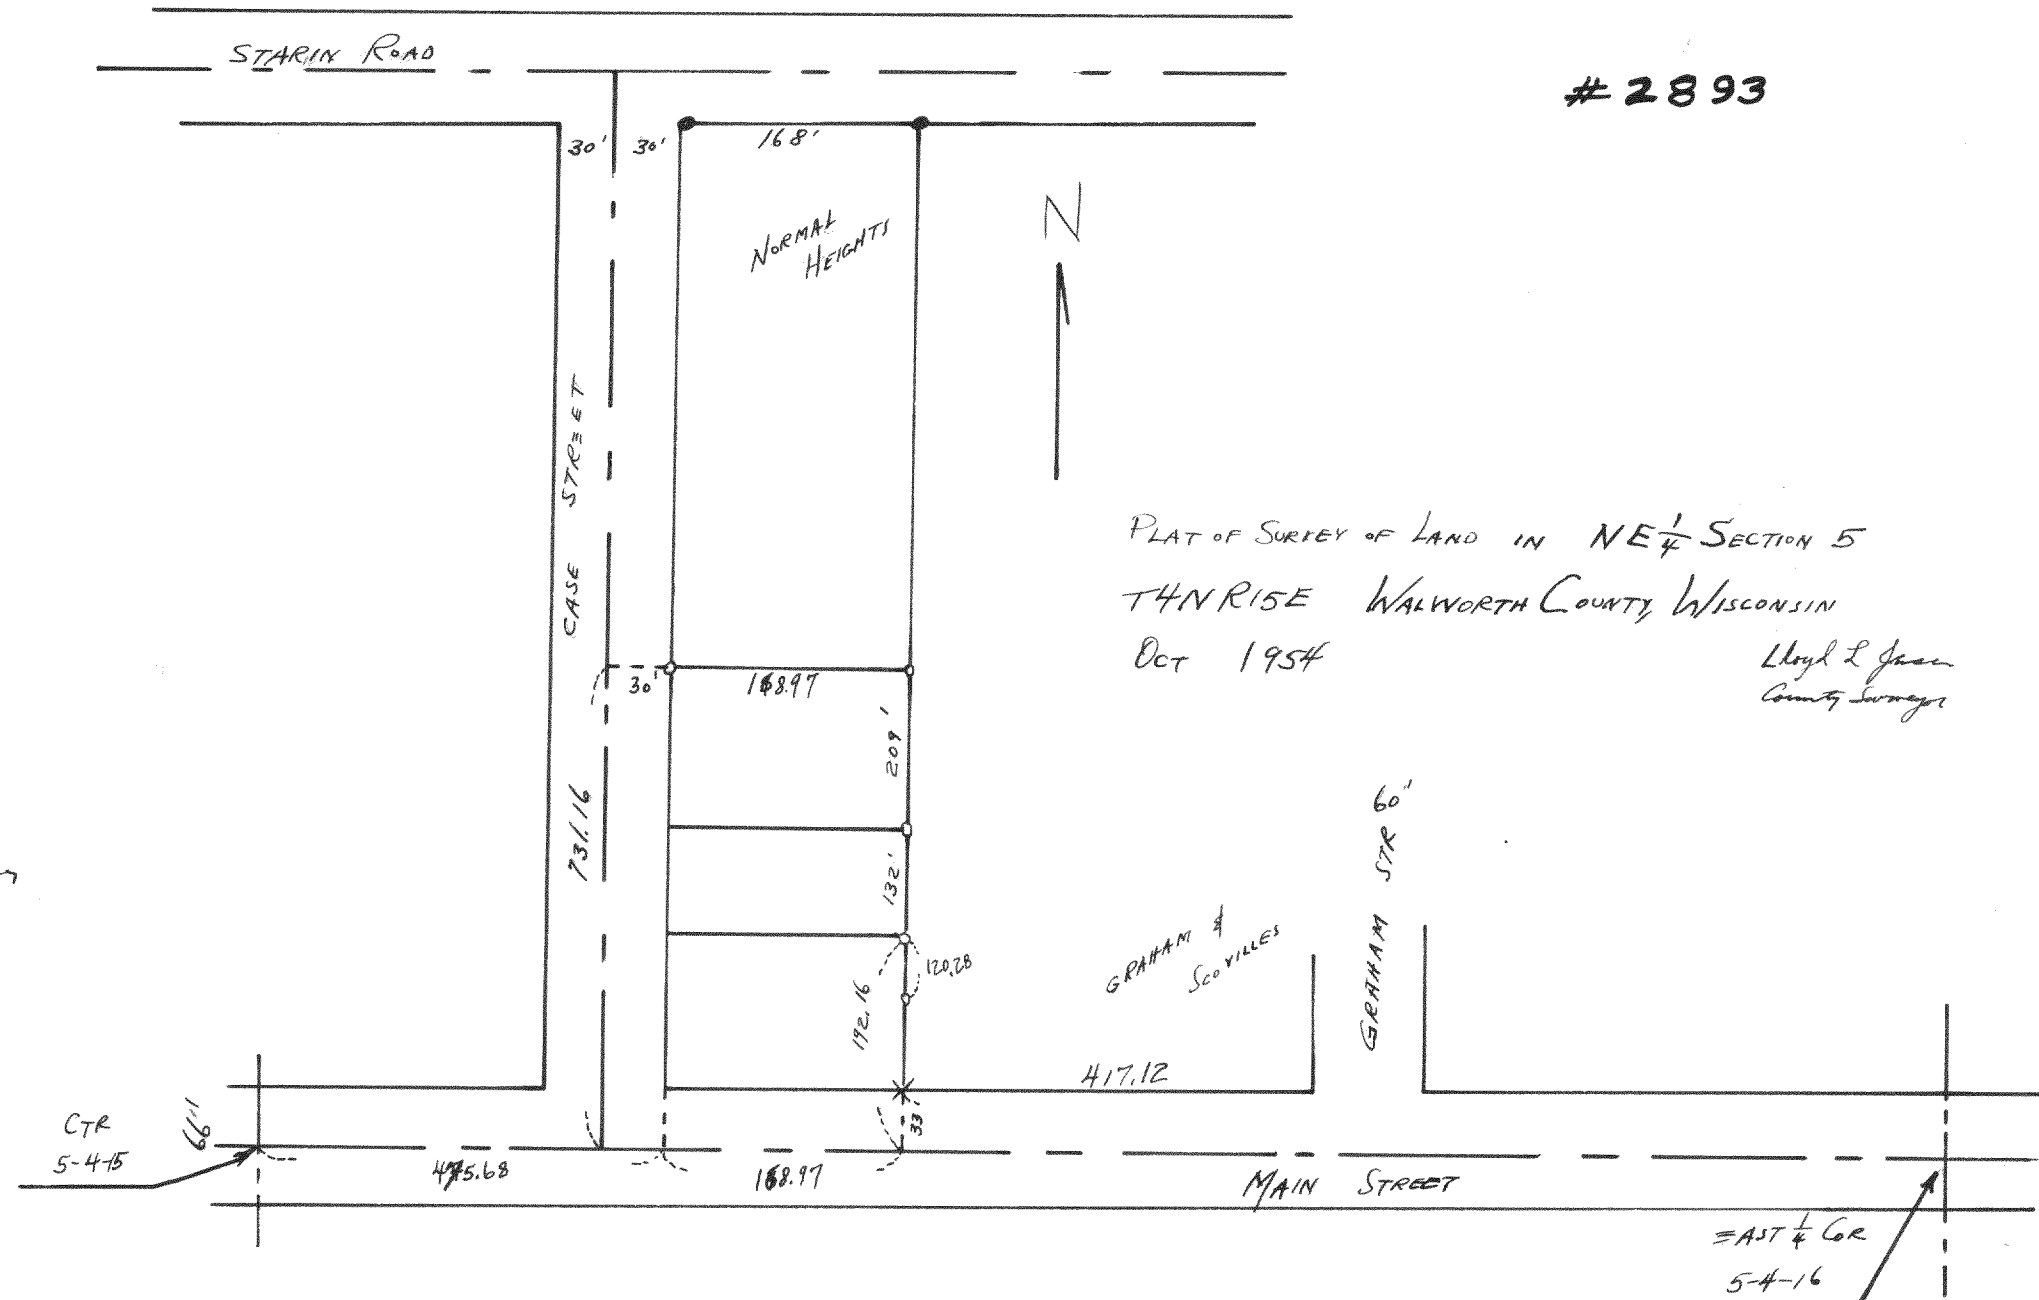

PLAT OF SURVEY OF LAND IN NE 1/4 SECTION 5
THURRISE WALWORTH COUNTY, WISCONSIN
OCT 1954

Lloyd L Jensen
County Surveyor

EAST 1/4 COR
5-4-16