


PAGE 2 OF 2

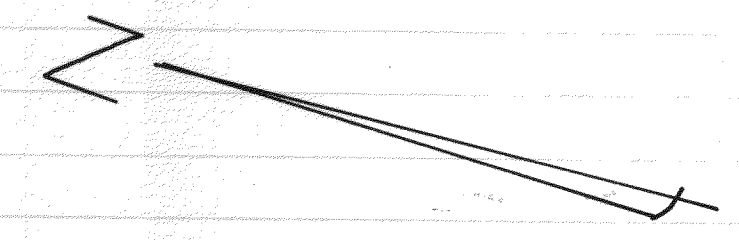

110'

MATCH
LINE

38.80

110

115'

90.38

MATCH
LINE

115

LOT 10 BLOCK 1
WOODDALE

51.42

115

120'

8' 0"
8' 0"
120'

70.00

10.0

9' 0"

Power Line
2" GAS MAIN

LAKEVIEW - ROAD -
(40' WIDE)

124

125

129

LOT 10 BLOCK 1 WOODDALE SUB.
SECTION 9 T1N-R17E
WALWORTH COUNTY, WISCONSIN.

MARCH 1, 1967

Luigi J. Janner
COUNTY SURVEYOR

#4518 (cont)