


#4524

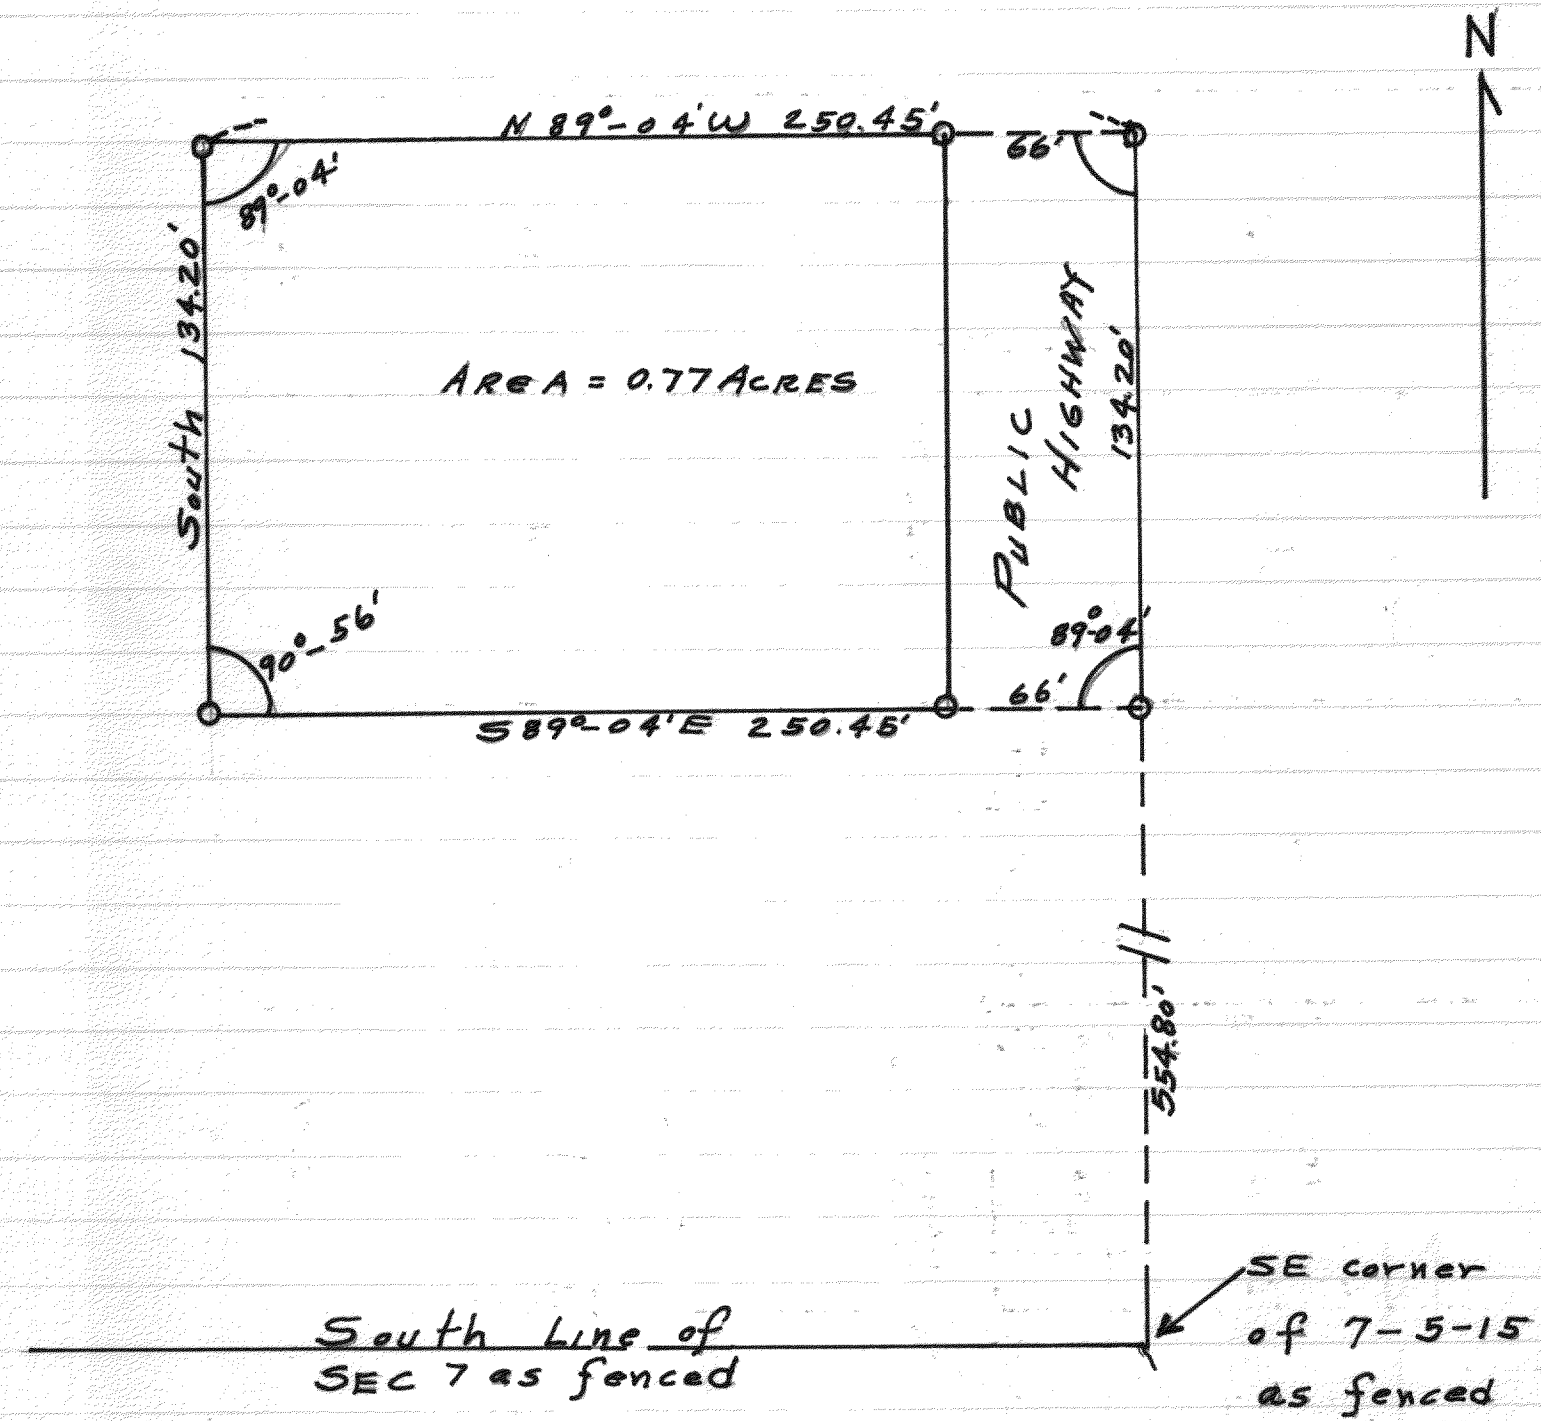

Survey of residence lot located
in the SE $\frac{1}{4}$ Section 7, T5N R15E
of Jefferson County, Wis.

JULY 1966

Lloyd Jensen
Surveyor


#4525

PLAT OF SURVEY

OF
LOT 4 of BLOCK 4 of COOL HILL PARK SUBDIVISION
LOCATED IN SECTION 35, T4N R16E of WALWORTH
COUNTY WISCONSIN.

COOL HILL DRIVE

66 FEET WIDE

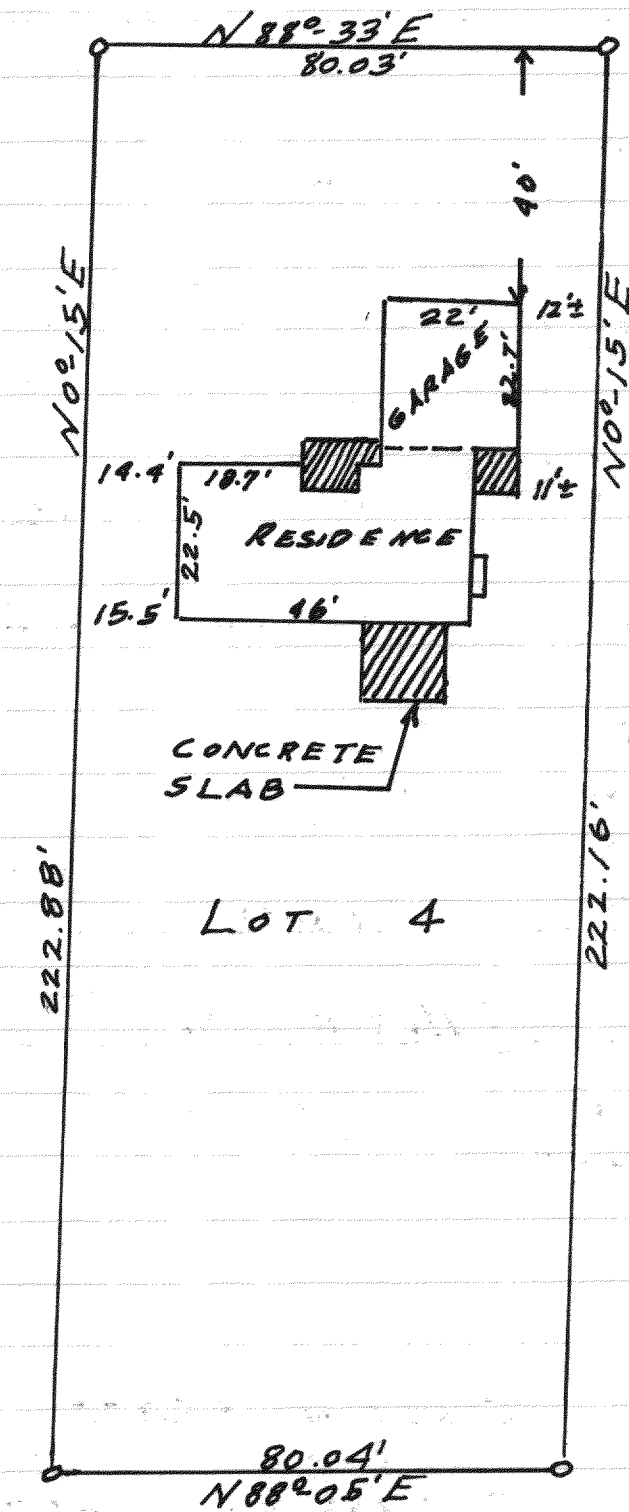

MAY 17, 1967

Lloyd Jensen
Surveyor