


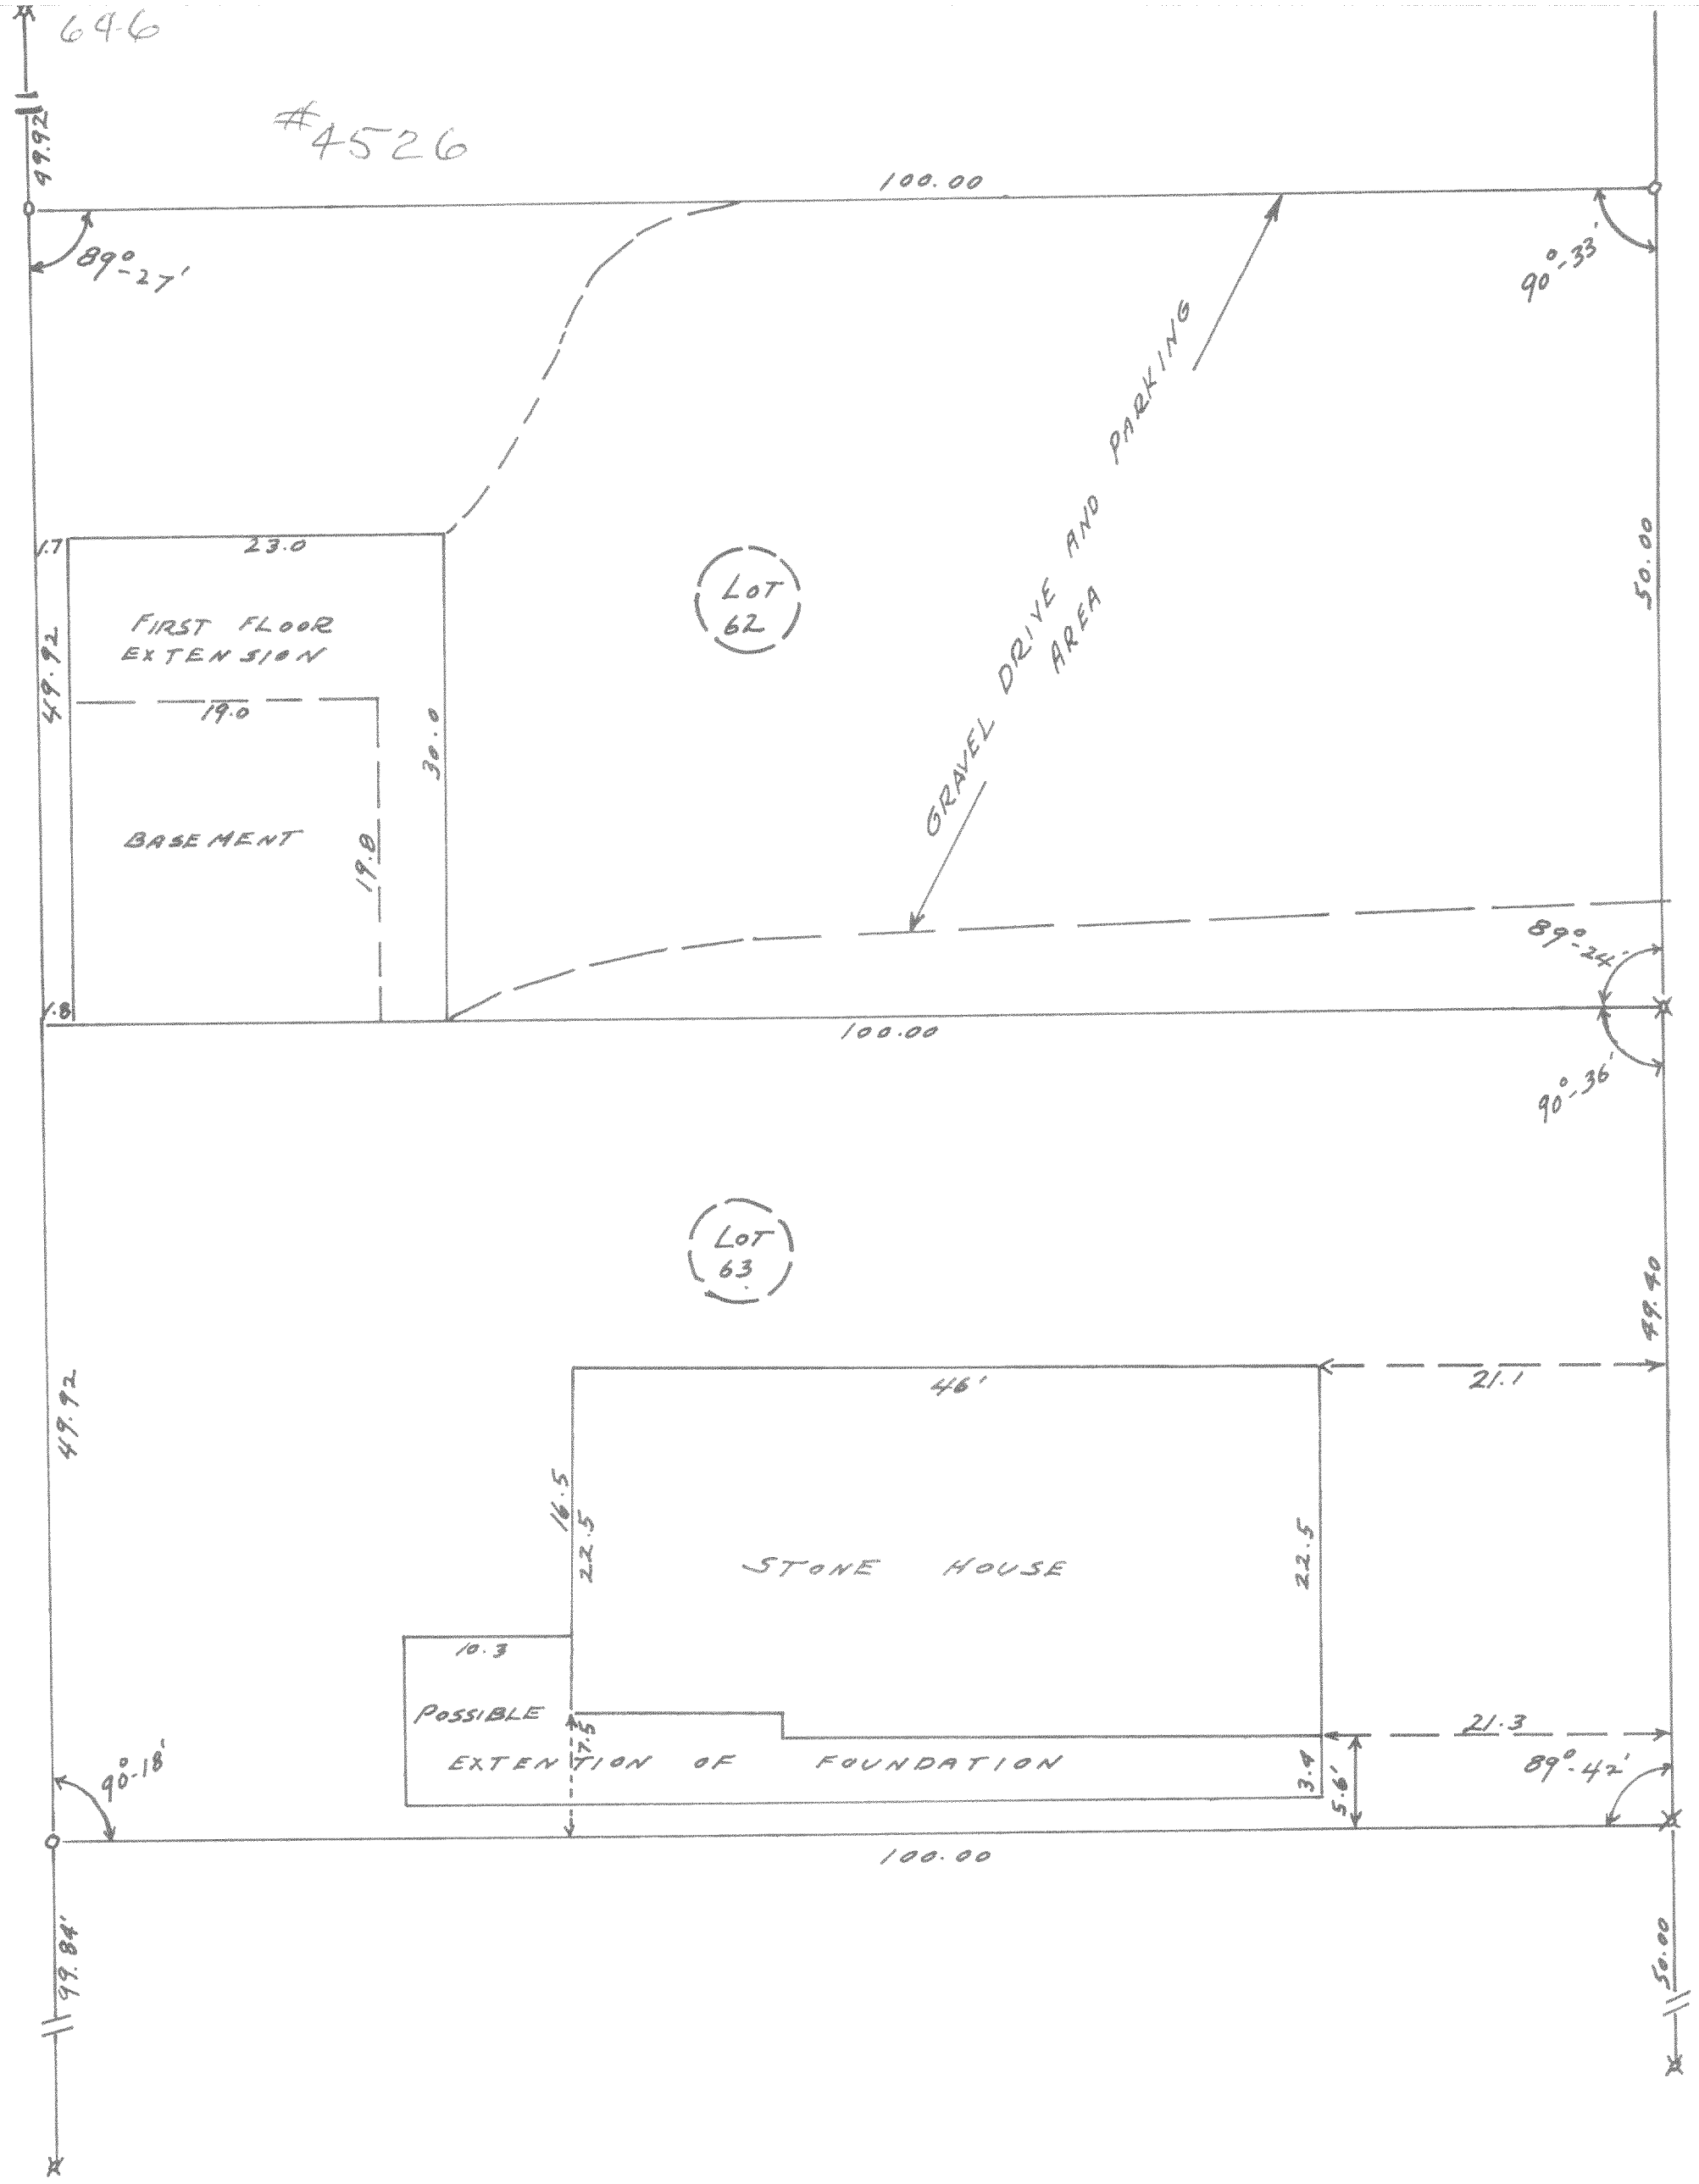

GREENLAND ROAD

50' W. 0.5

APRIL 15, 1967
WISCONSIN
Surveyor
Paul J. Green

PLAT OF SURVEY

OF
LOTS 62-63 LAKE GENEVA HIGHLANDS
LOCATED IN THE SE 1/4 SECTION 8,
T1N R17E W4WORTH COUNTY