



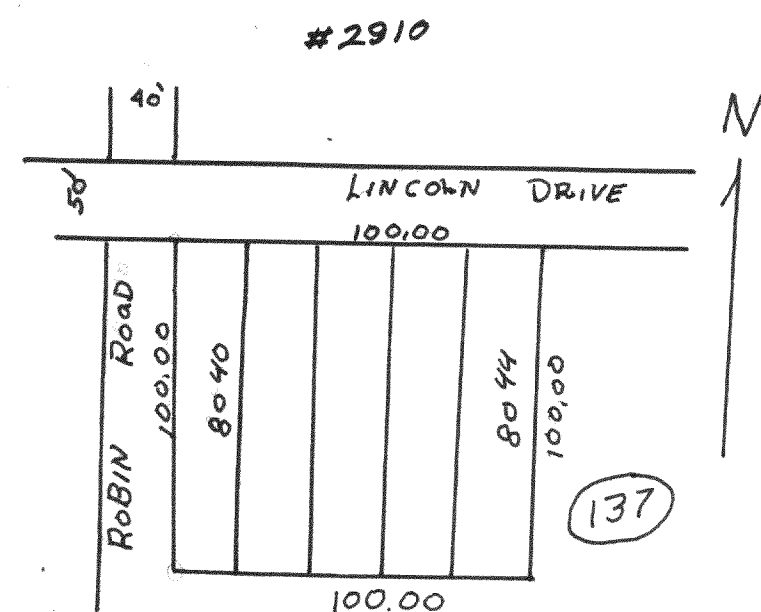


PLAT OF SURVEY OF LOTS 8040-8044 BLOCK 137
LAKE COMO BEACH T2N R17E WAH WORTH
COUNTY WISCONSIN
MARCH 1954 LLOYD L JENSEN CS

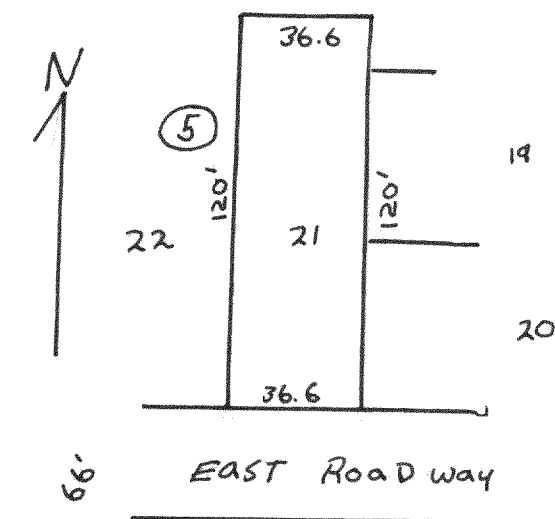


PLAT OF SURVEY OF LOT 21 BLOCK 5
SUNSET HILLS T1N R17E WAH WORTH
COUNTY WISCONSIN
JULY 1954 LLOYD L JENSEN CS

#2913

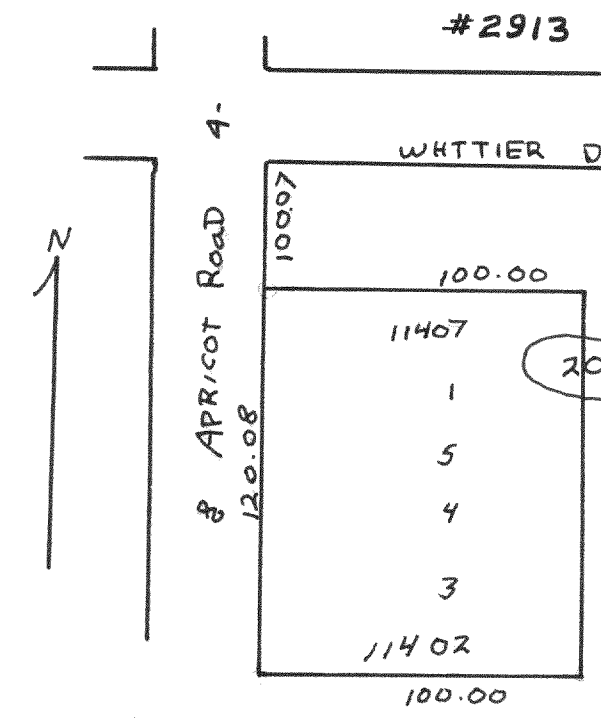


PLAT OF SURVEY OF LOTS
11402-11407 BLK 205
LAKE COMO BEACH
T2N R17E WAH WORTH
COUNTY WISCONSIN
JULY 1954 LLOYD L JENSEN CS

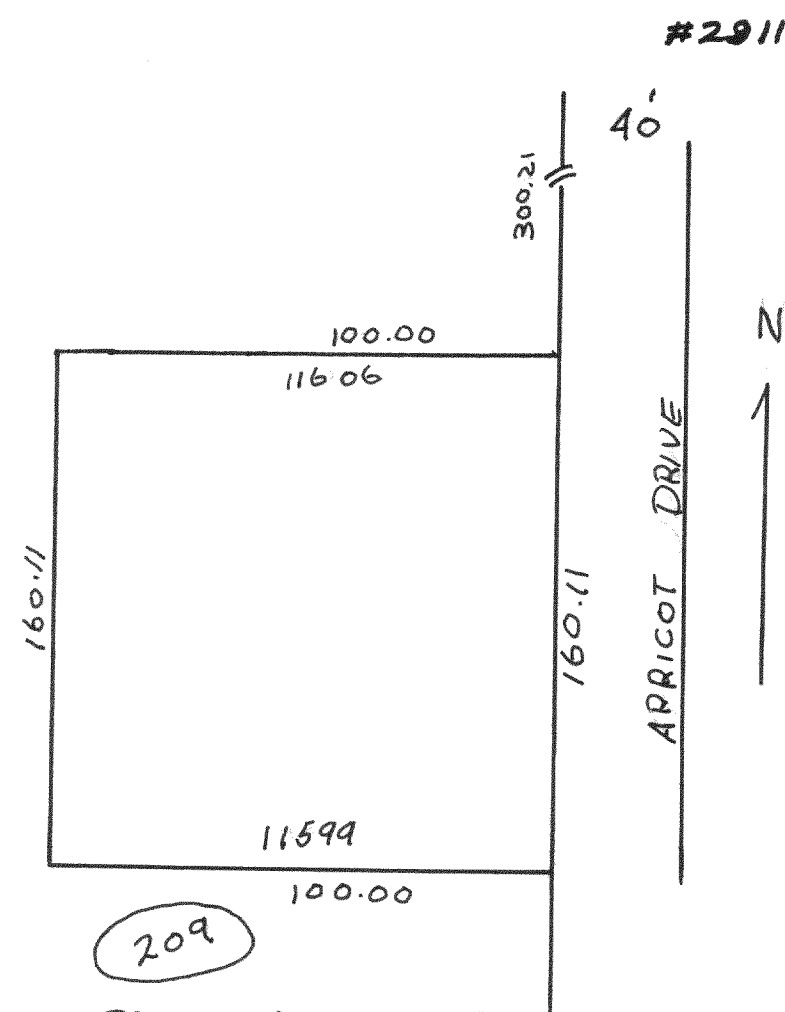


PLAT OF SURVEY OF LOTS 11599-11606 BLK. 209
LAKE COMO BEACH T2N R17E WAH WORTH
COUNTY WISCONSIN
JULY 1954 LLOYD L JENSEN CS

#2914

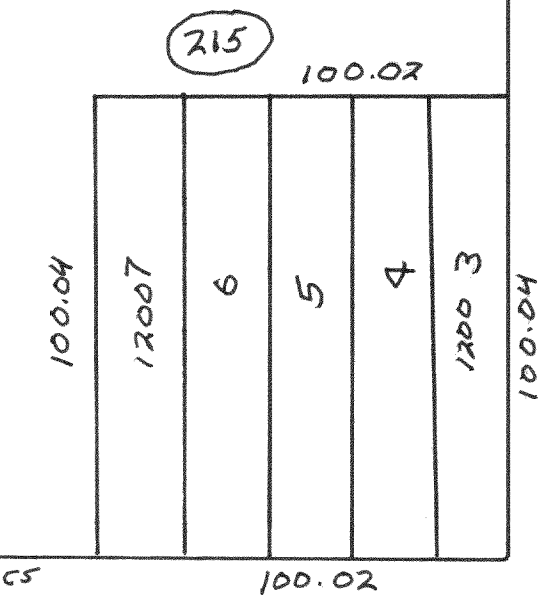


PLAT OF SURVEY OF LOTS 12003-12007
BLOCK 215 LAKE COMO BEACH
T2N R17E WAH WORTH COUNTY
WISCONSIN AUG. 1954 L.H.J. CS

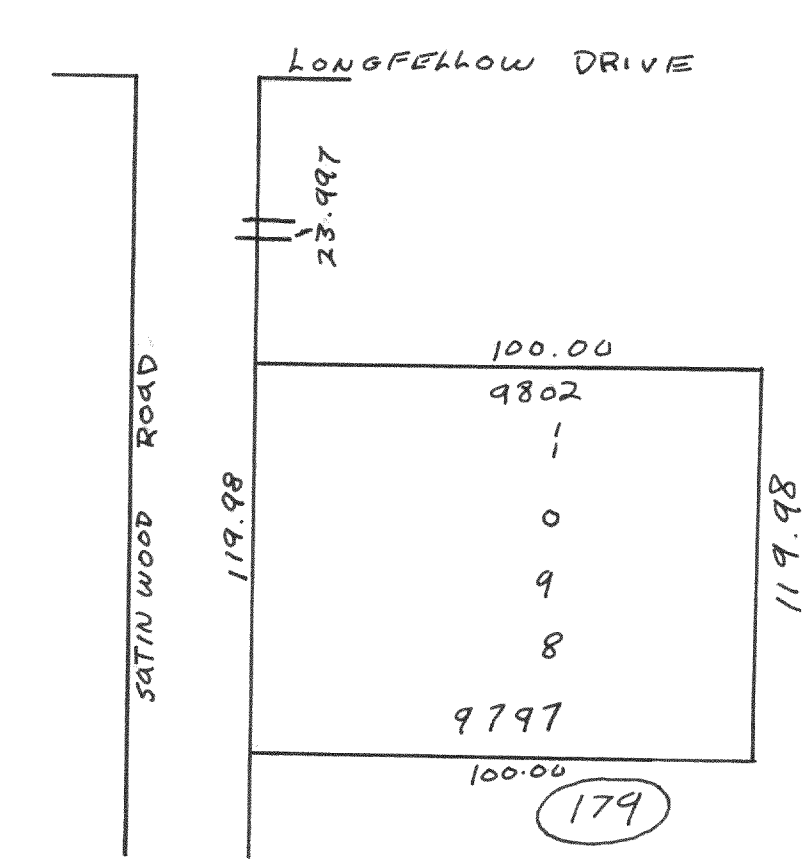

#2912

PLAT OF SURVEY OF LOTS 9797
9802 BLOCK 179 LAKE COMO BEACH
T2N R17E WAH WORTH COUNTY
WISCONSIN JULY 1954 L.H.J. CS

#2915

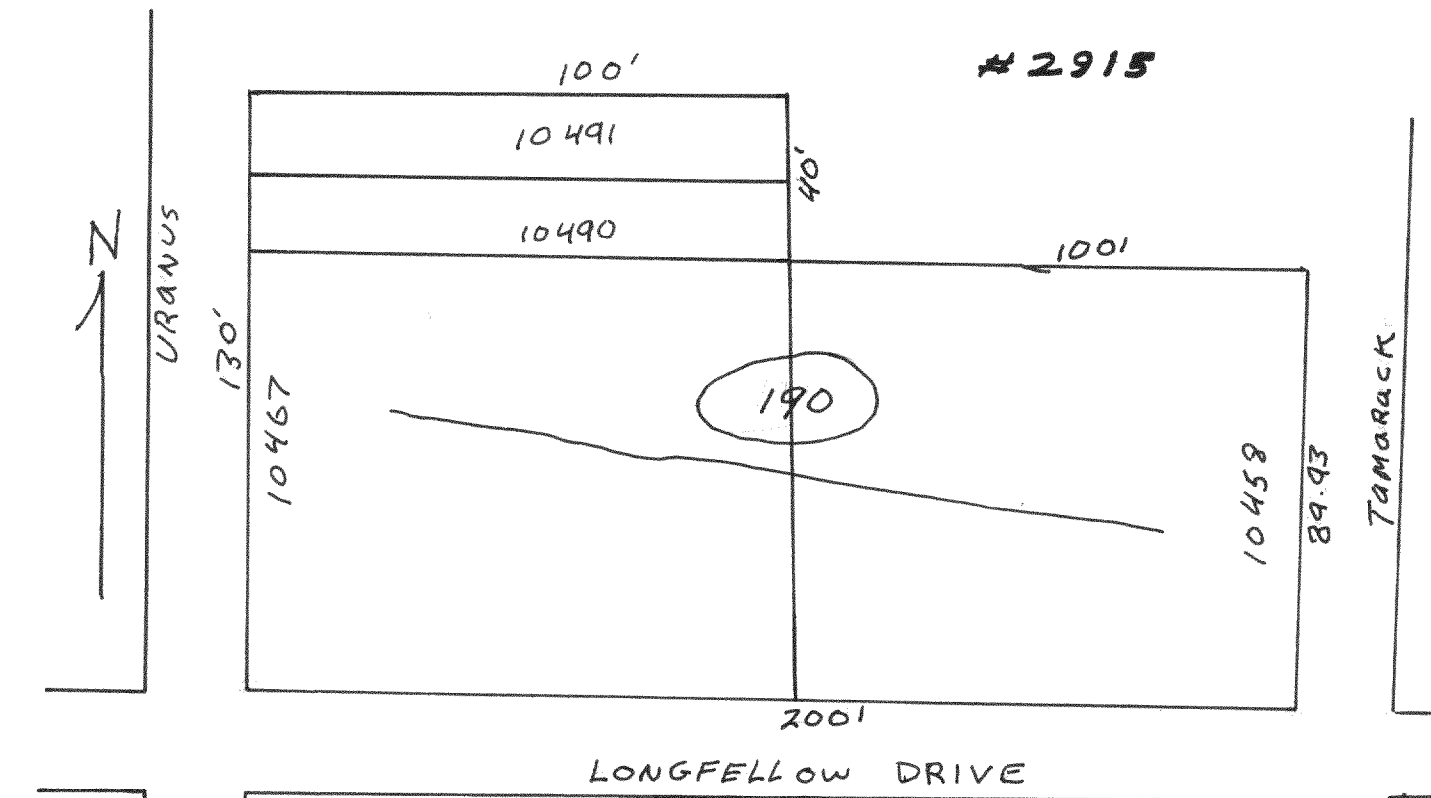

PLAT OF SURVEY OF LOTS 10458-10467 AND
LOTS 10490-10491 BLOCK 190 LAKE COMO BEACH
T2N R17E WAH WORTH COUNTY WISCONSIN
JUNE 1954 L.H.J. CS