


PLAT OF SURVEY
OF

671

4551

LOT 114 AND 115, 2ND ADDITION
CEDAR POINT PARK SUBDIVISION,
VILLAGE OF WILLIAMS BAY,
WALWORTH COUNTY, WISCONSIN.
JAN. 4, 1967

Floyd J. Jensen
COUNTY SURVEYOR

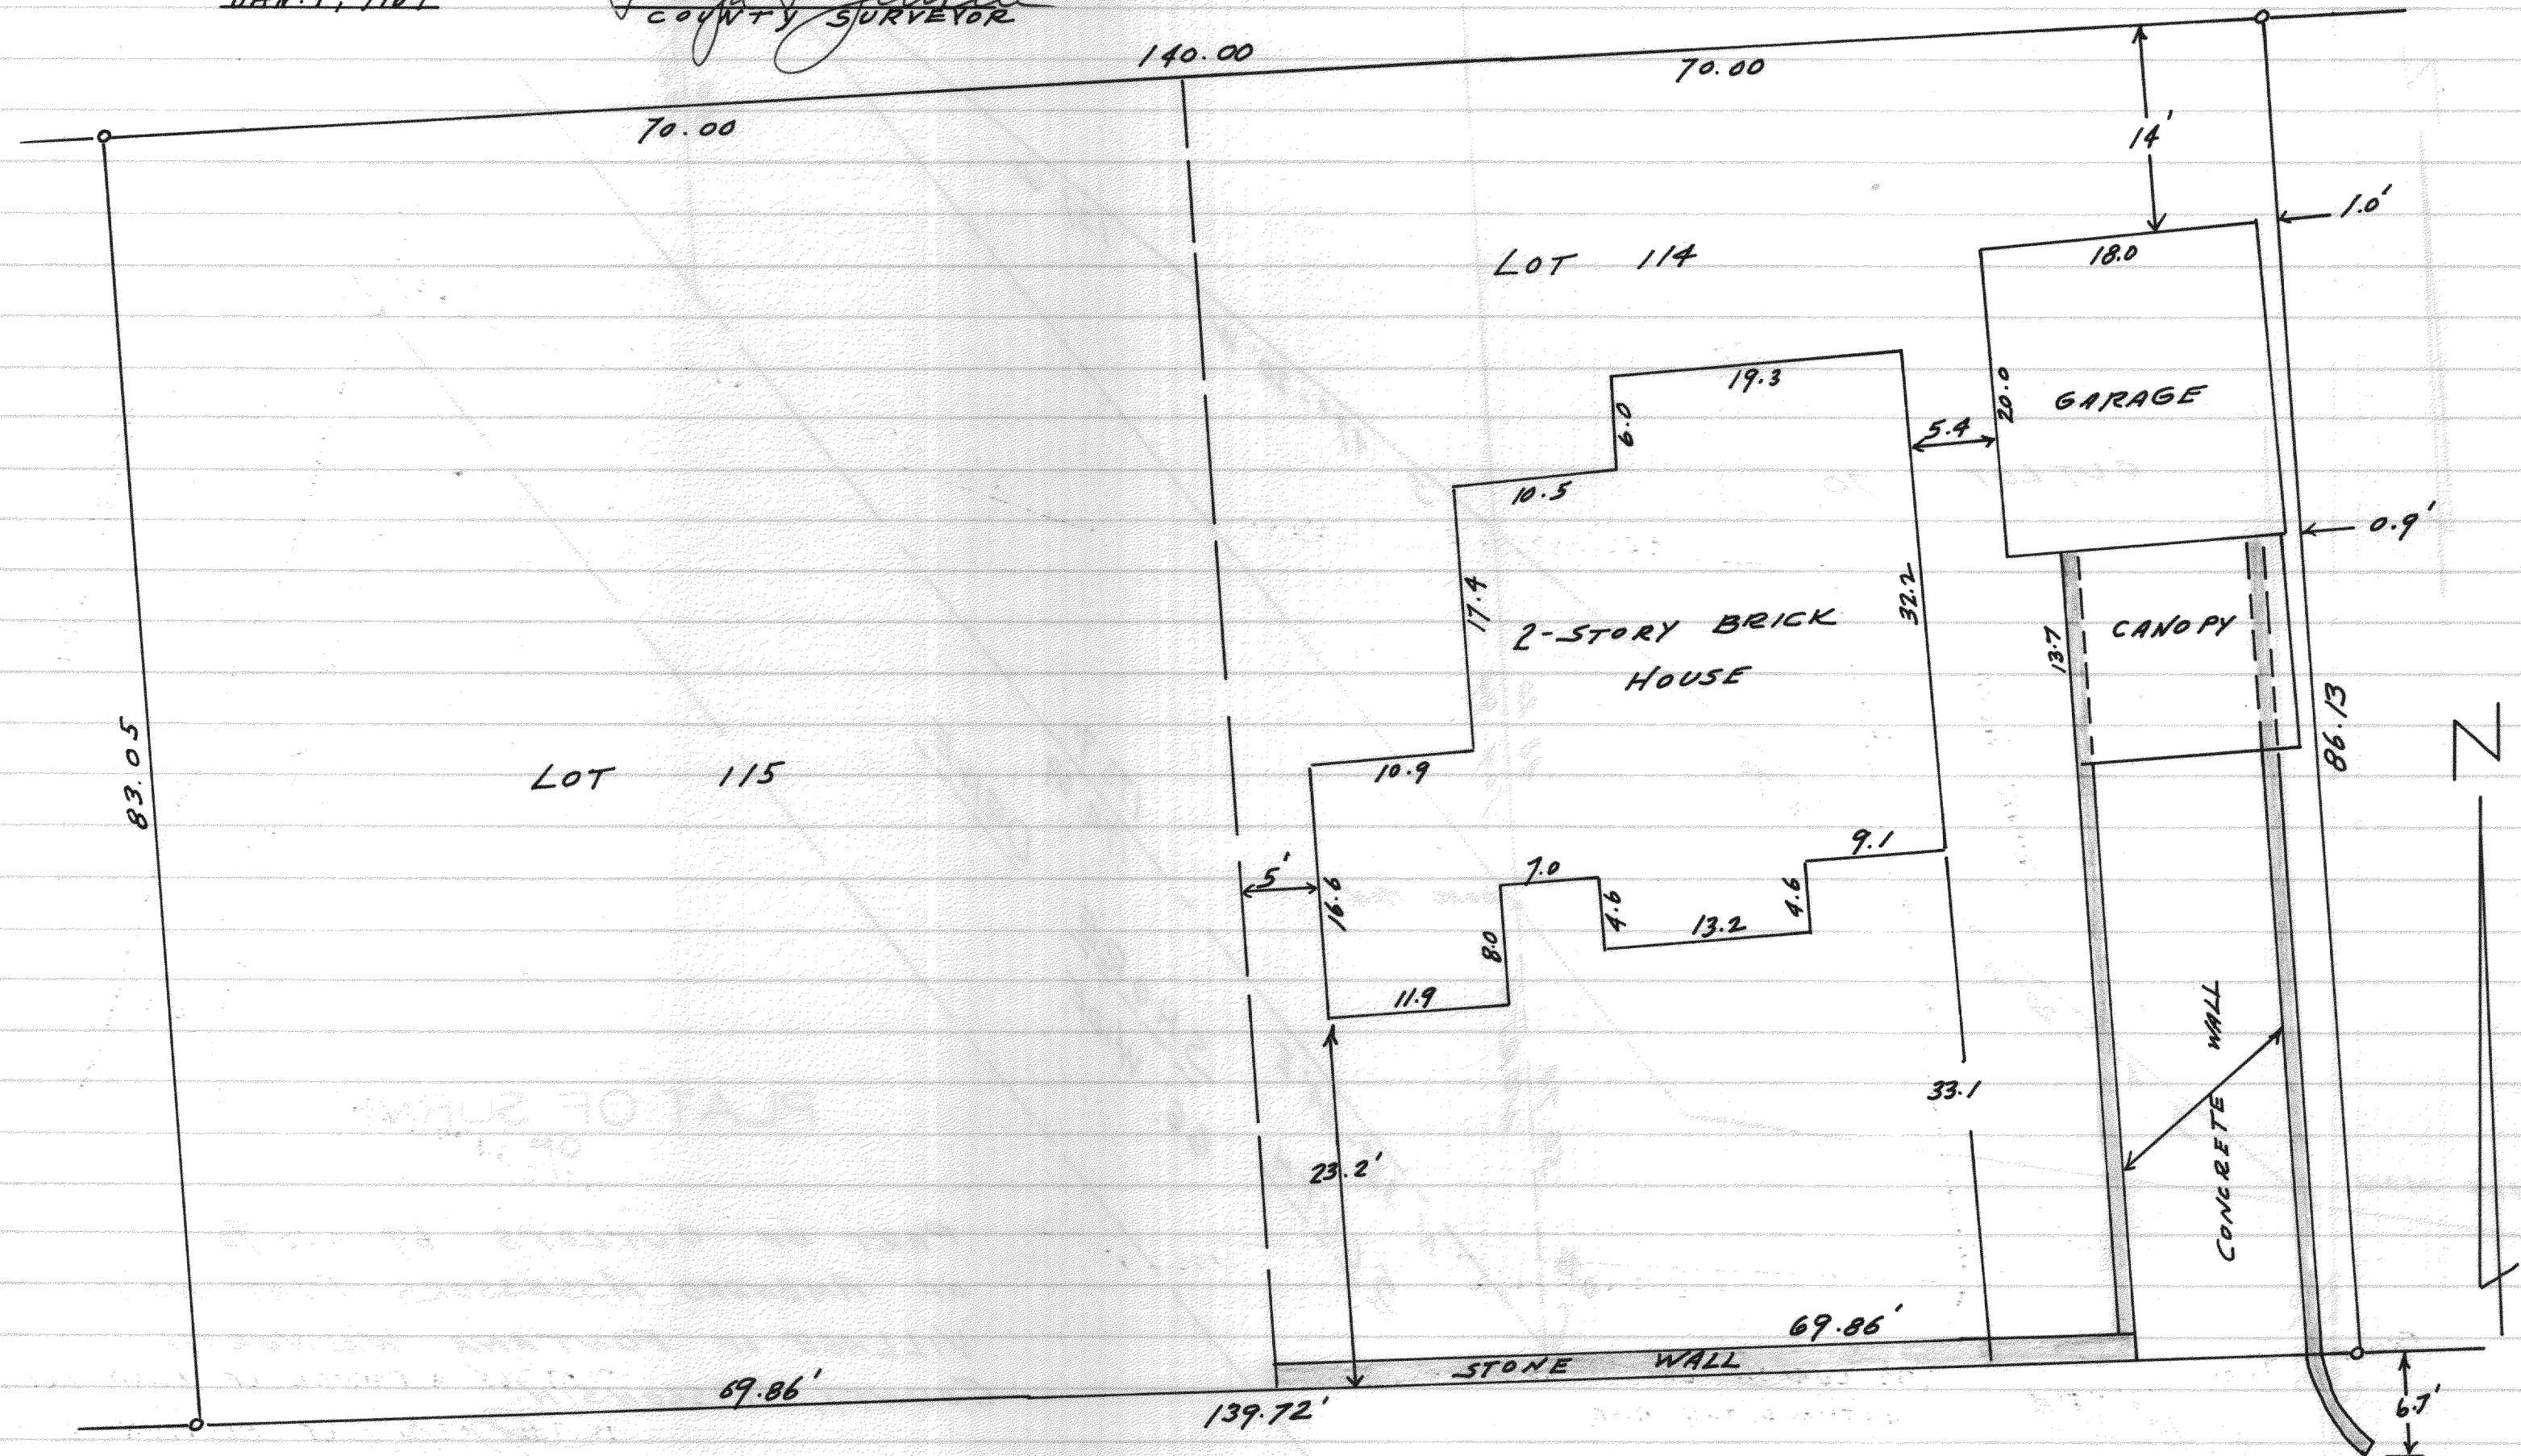

— — — — — PARK RIDGE ROAD — — — — —
40' WIDE